


T.8S.,R.40E.,W.M.

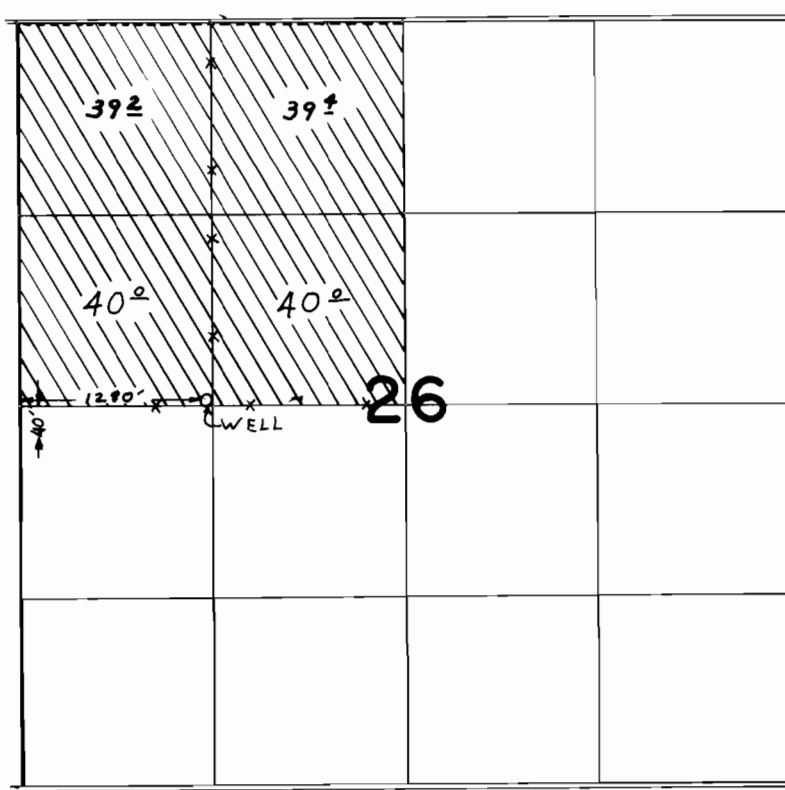

FINAL PROOF SURVEY
UNDER

Application No. G-6752 Permit No. G-6073
IN NAME OF

RALPH WARD

Surveyed JUNE 23 1976, by C.R. KING