


Application No. R-81650
Permit No.

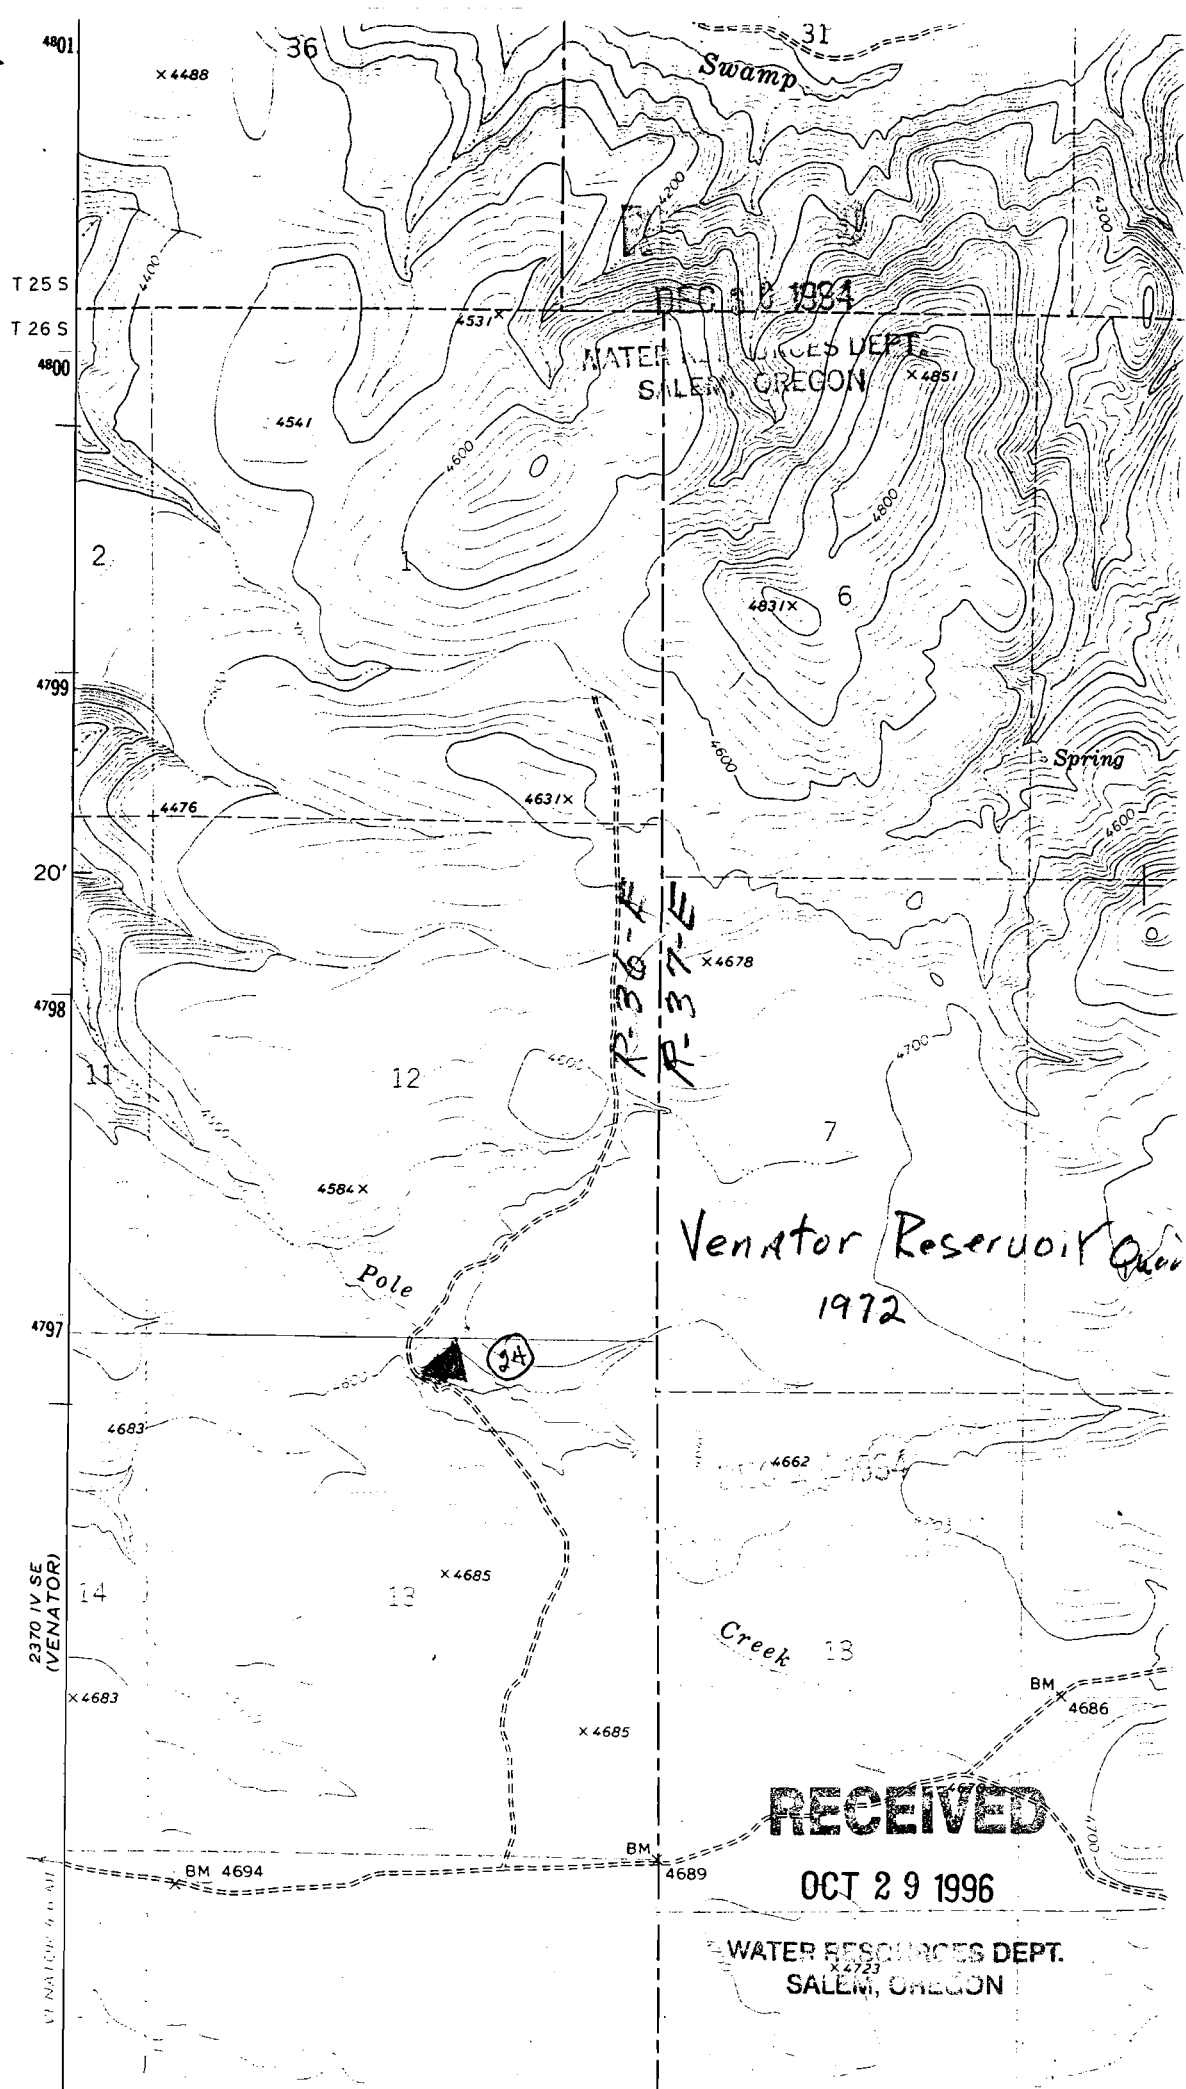

No Final Proof Map available

No Permit Map available