


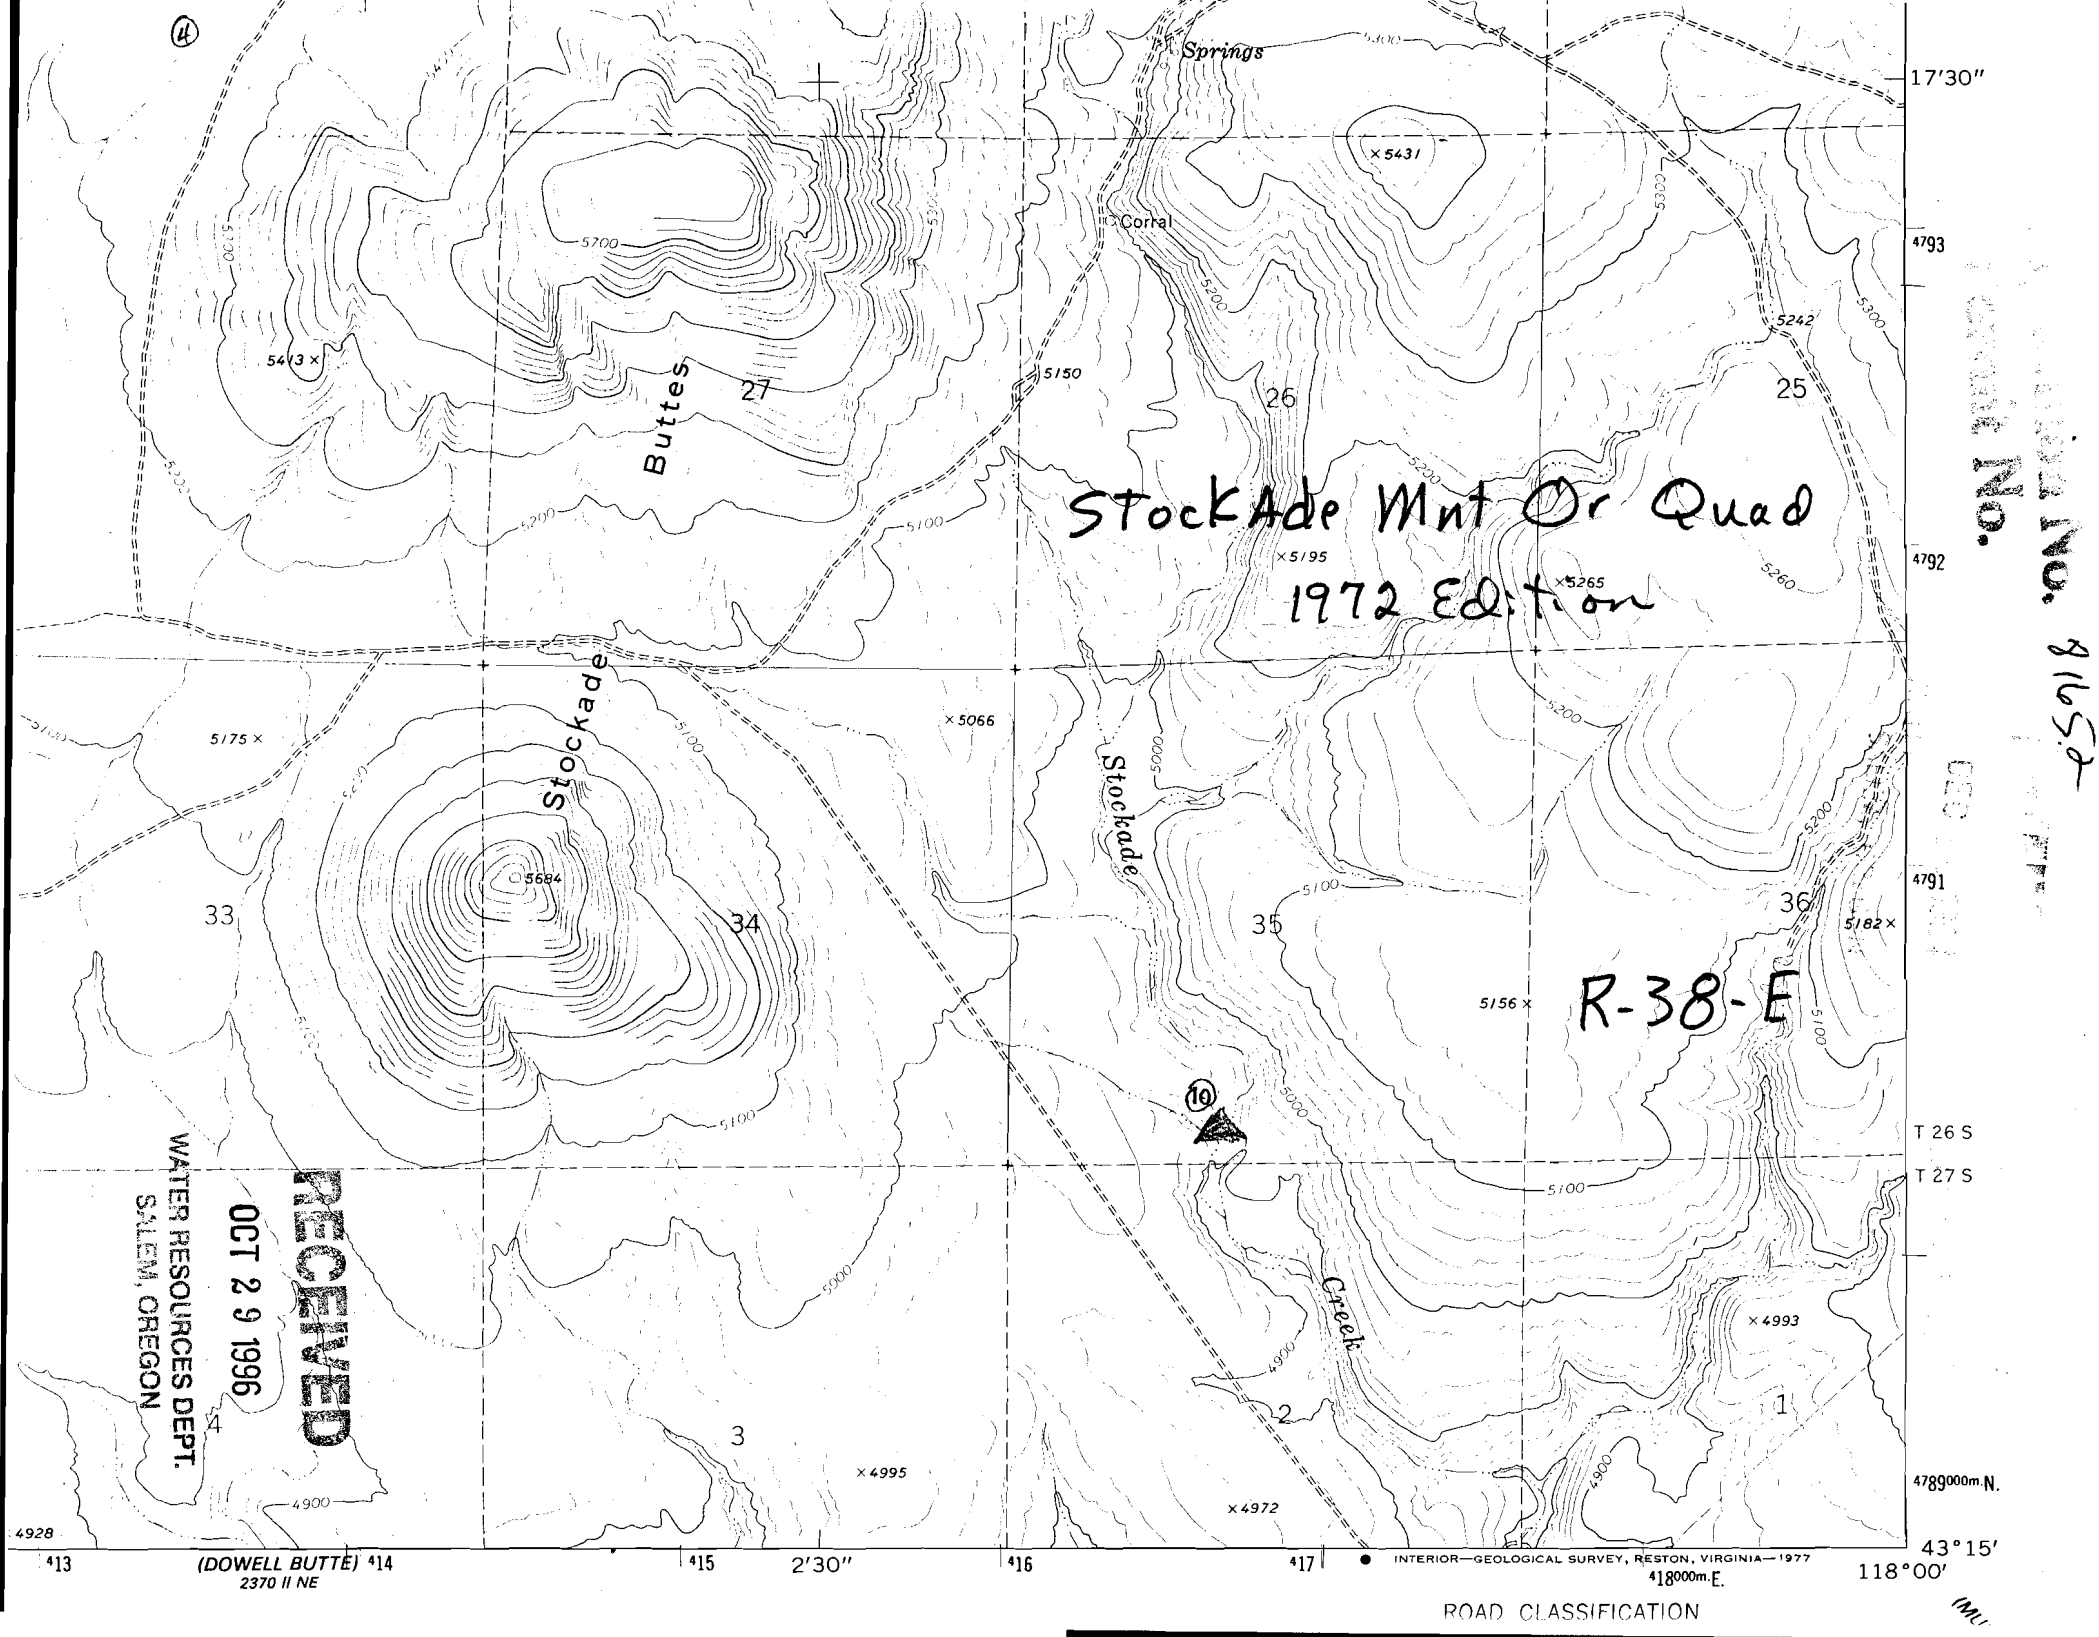

No. 81652

Stockade Mt Or Quad
1972 Edition

R-38-E

RECEIVED

OCT 29 1996


WATER RESOURCES DEPT.
SALEM, OREGON

(DOWELL BUTTE) 414
2370 II NE

INTERIOR—GEOLOGICAL SURVEY, RESTON, VIRGINIA—1977
418000m.E.

ROAD CLASSIFICATION

(M)

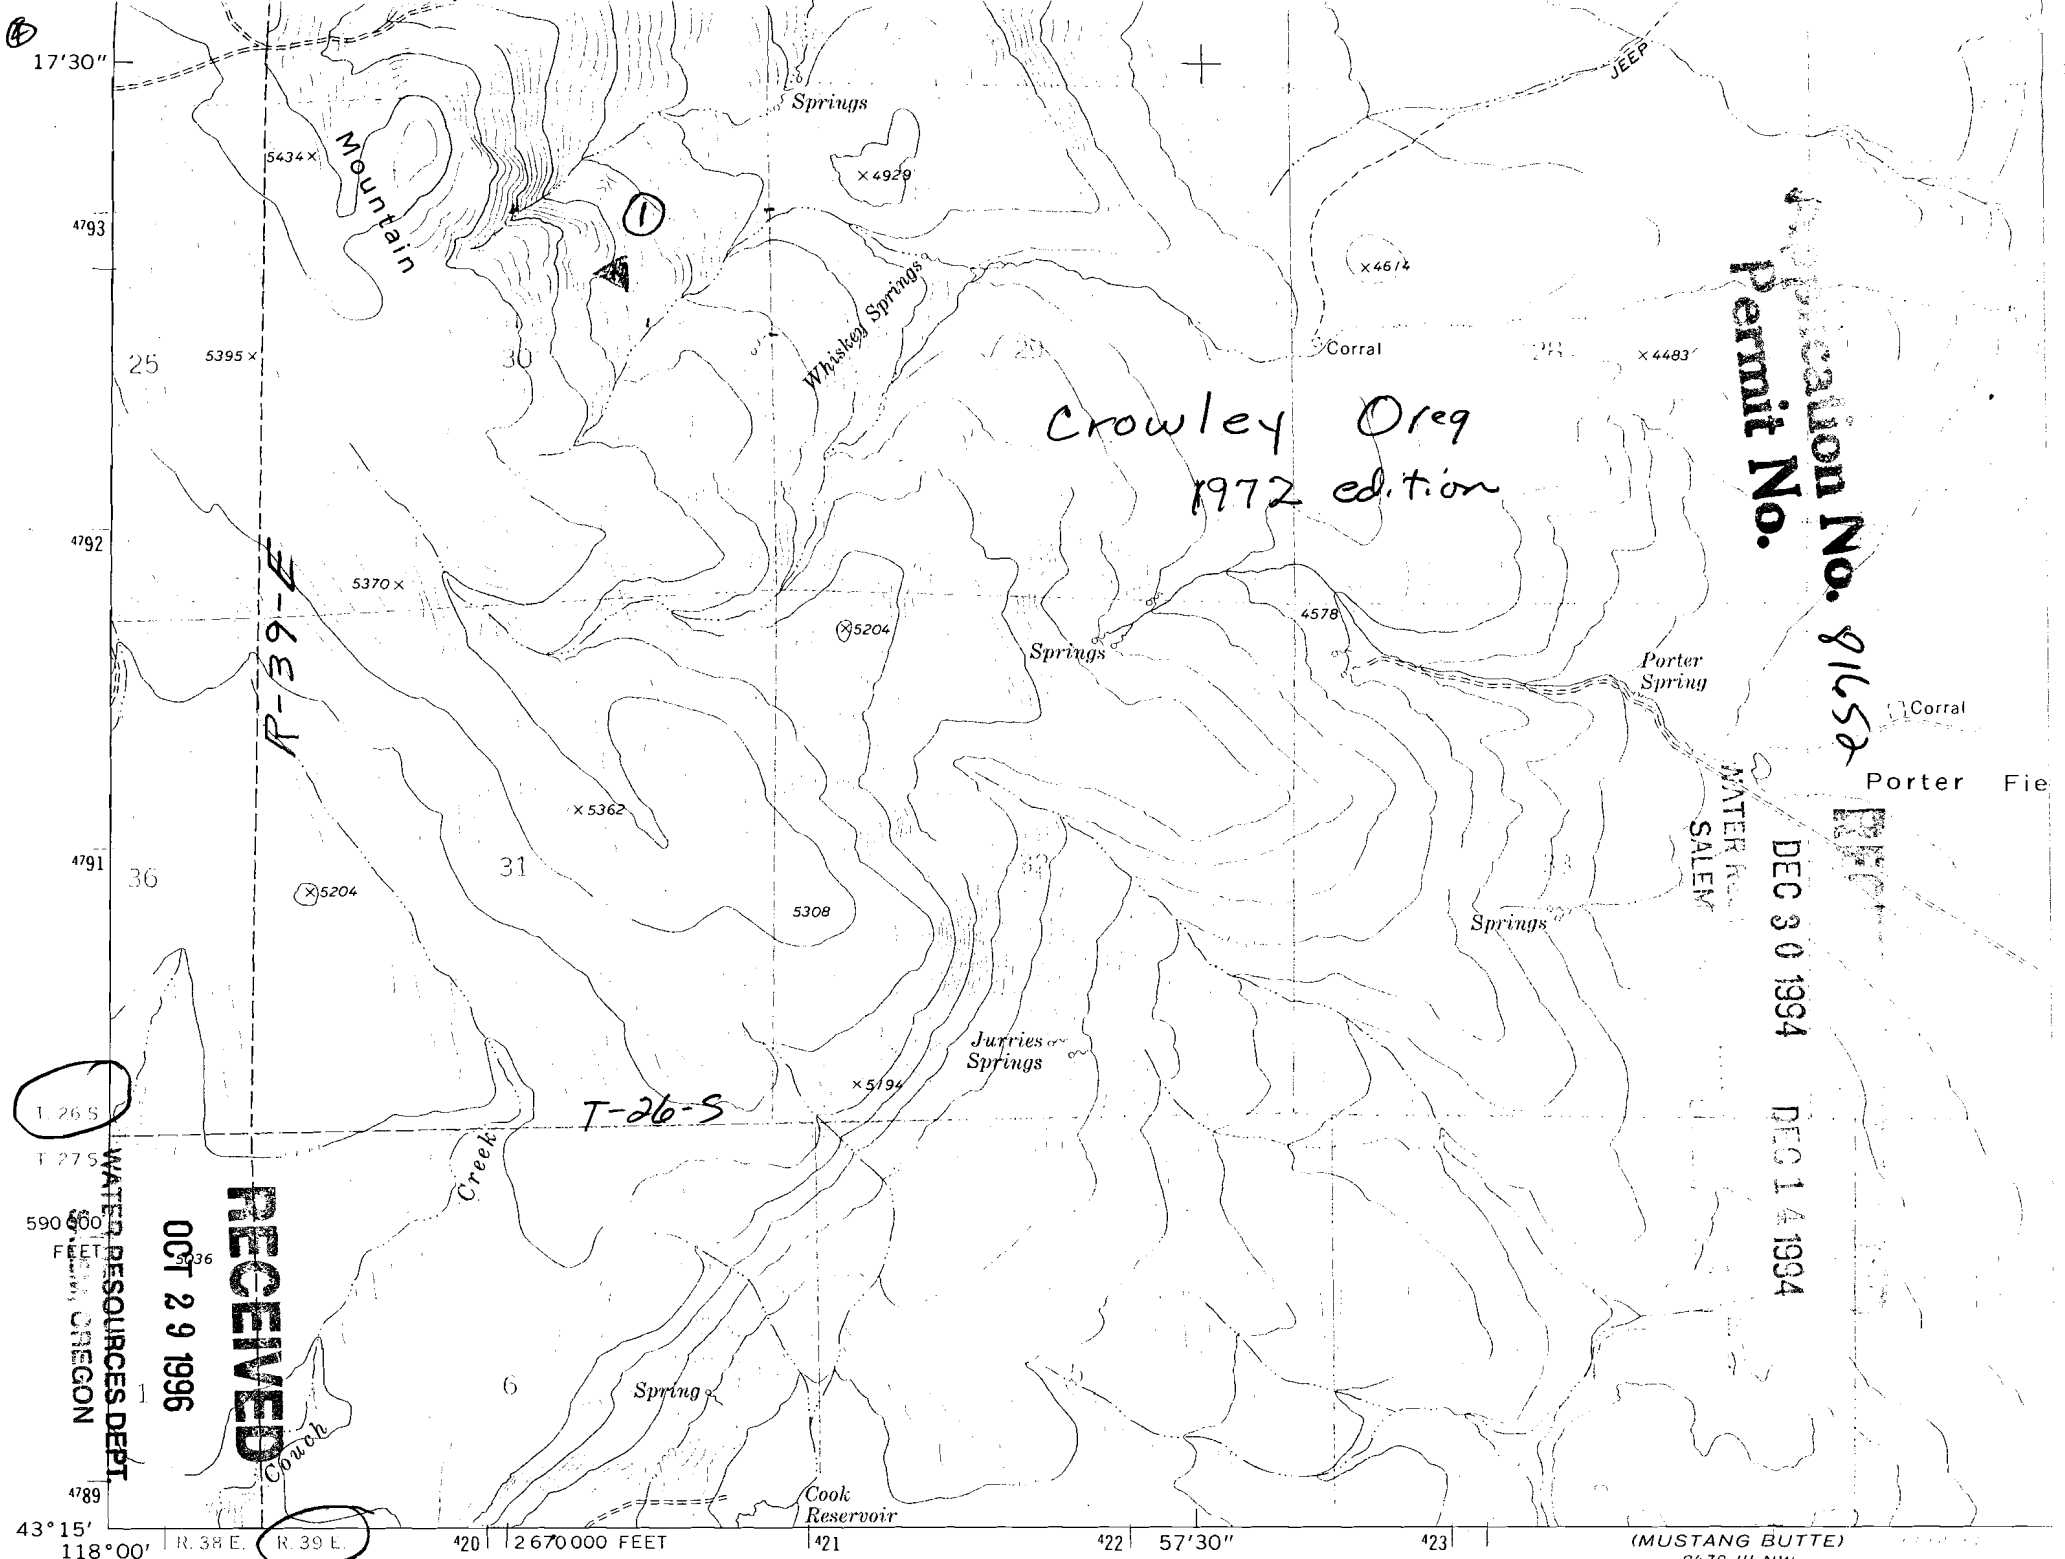

Crowley Oreg
1972 edition

Location No. 81652
Permit No.



WATER RESOURCES
SALEM

RECEIVED

OCT 29 1996

WATER RESOURCES DEPT
OREGON

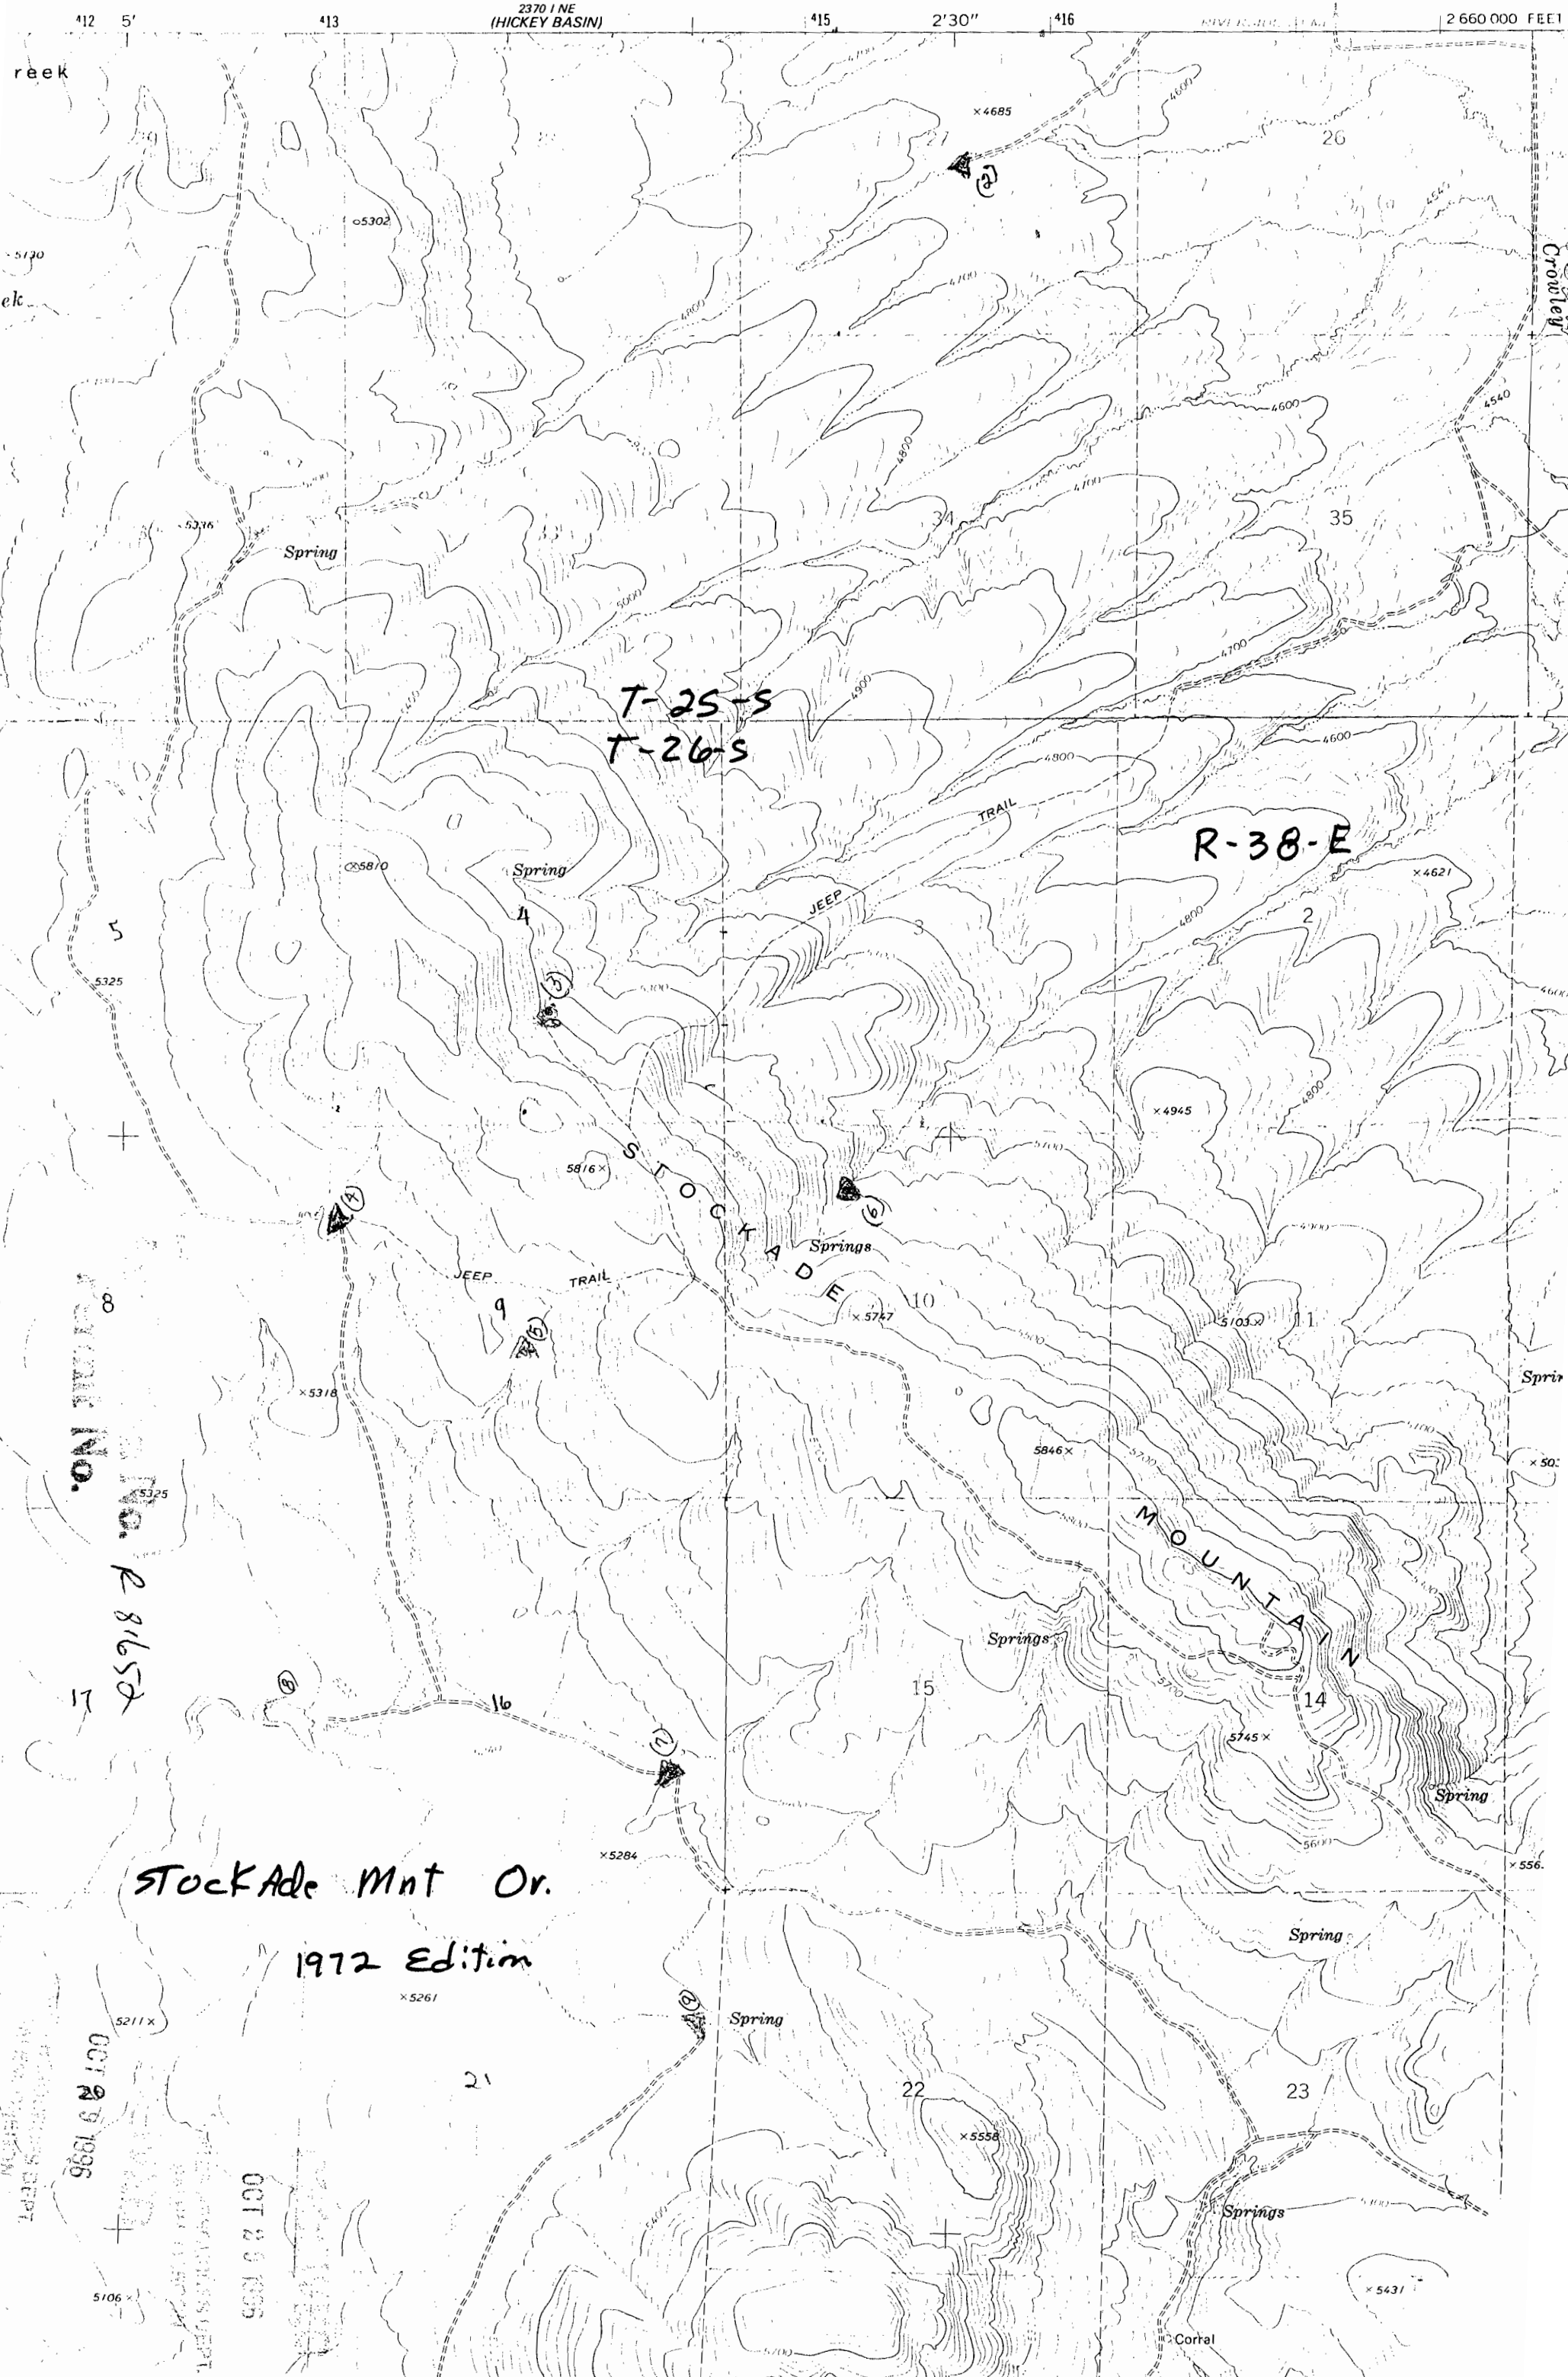

2370' NE
(HICKEY BASIN)

2 660 000 FEET

reek

5120
ek

Crowley

T-25-S
T-26-S

R-38-E

NO. 8
NO. R 81652
17

Stockade Mnt Or.
1972 Edition

OCT 23 1996
OCT 23 1996
5106 X

No Final Proof Map available

No Permit Map available