

RECEIVED

OCT 29 1996

WATER RESOURCES DEPT.
SALEM, OREGON

Application No. K-81653
Permit No.

RECEIVED


DEC 30 1994

WATER RESOURCES DEPT.
SALEM, OREGON

DEC 14 1994

WATER RESOURCES DEPT.
SALEM, OREGON

Hickey Basin 11
1972 Edition

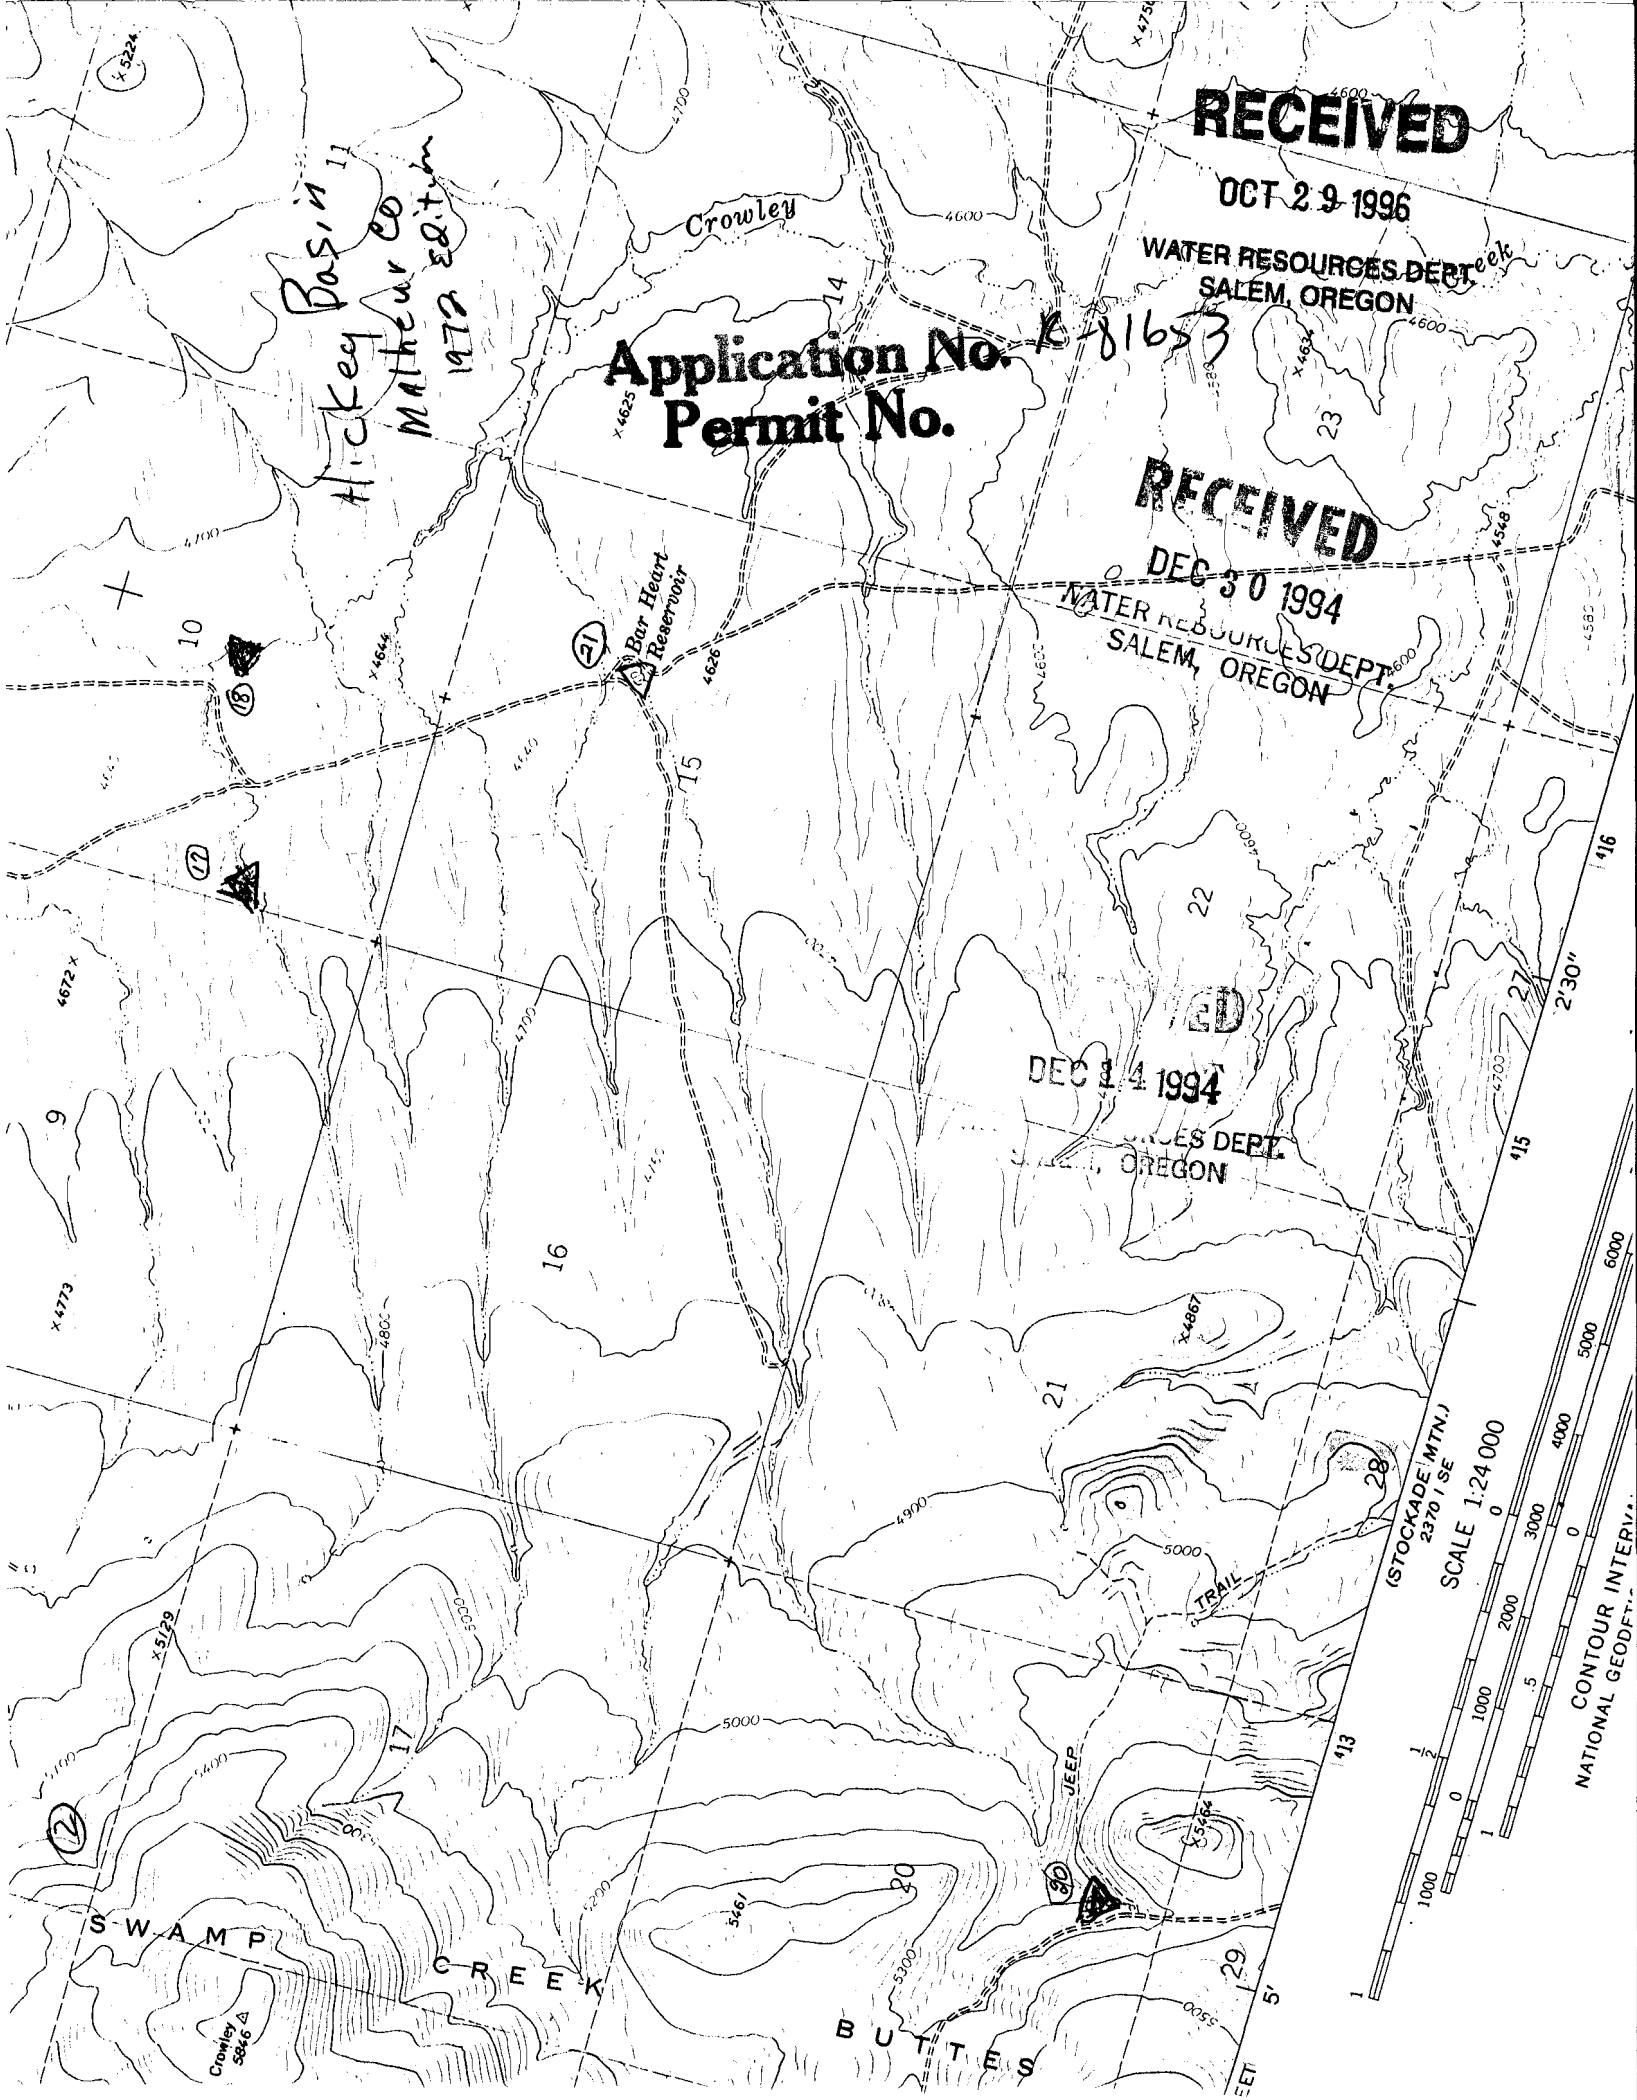

No Final Proof Map available

No Permit Map available