

BECKER CREEK QUAD.
Malheur County

RECEIVED

DEC 29 1994

WATER
SALEM, OREGON

SWSW

SEC. 7

T.5. 14s

R. 43E

Pond # 2


Source: CREEK + RUNOFF

Dam Height: 17.5 ft

Water Depth: 7 ft

Storage Capacity: 3.5 A.F.

Outlet Pipe: 12" Not USED
Spillway - USED

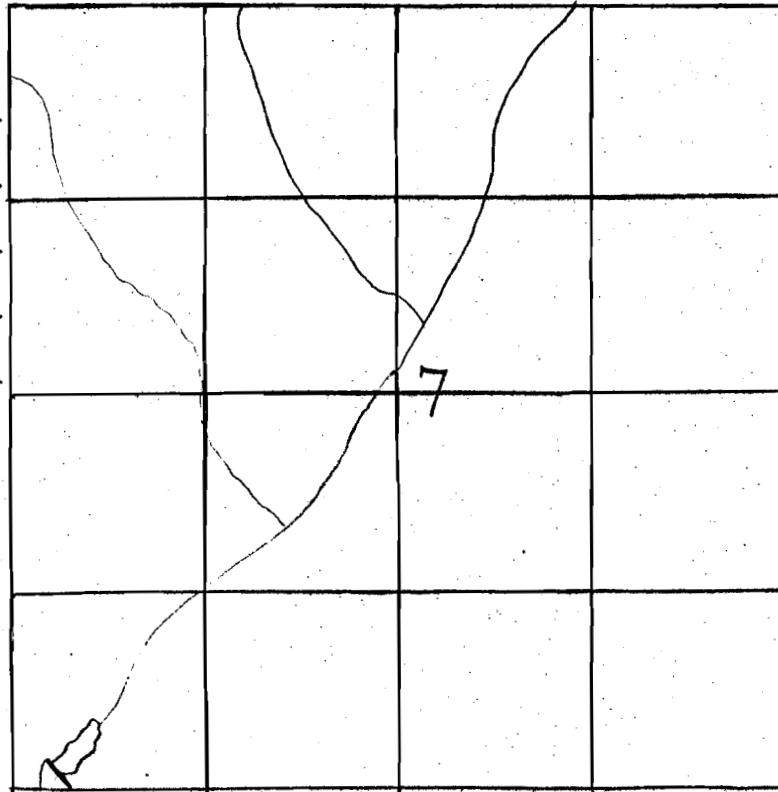

Application No. 81719

Permit No.

2153

RECEIVED

AUG 26 1996

WATER RESOURCES DEPT.
SALEM, OREGON

BECKER CREEK QUAD.

Malheur County

RECEIVED

DEC 29 1994

WATER RESOURCES
SALEM, OREGON

NWSW

SEC 26

T.S. 14S

R. 42E

Pond #3

Source: Runoff

Dam Height: 6 ft

Water Depth: 5 ft

Storage Capacity: .42 AF

Outlet Pipe: NONE

		26	

N ↑

2153

RECEIVED

AUG 26 1996

WATER RESOURCES DEPT.
SALEM, OREGON

BECKER CREEK Quad.
Malheur County

R

DEC 29 1994

WATER
SALEM, OREGON

SWSW
NW SW

SEC 36 T.S. 14S R. 42E

Pond # 4

Becker

Source: CREEK + Runoff

Dam Height: 10 ft

Water Depth: 4 ft

Storage Capacity: 2 AF

Outlet Pipe: NONE

Rocky overflow runs
back into Becker Creek

		36	

N ↑

2153

RECEIVED

AUG 26 1996


WATER RESOURCES DEPT.
SALEM, OREGON

RECEIVED

AUG 26 1996
WATER RESOURCES DEPT.
SALEM, OREGON

UNITED STATES
DEPARTMENT OF THE INTERIOR
GEOLOGICAL SURVEY

BECKER CREEK QUADRANGLE
OREGON-MALHEUR CO.
7.5 MINUTE SERIES (TOPOGRAPHIC)

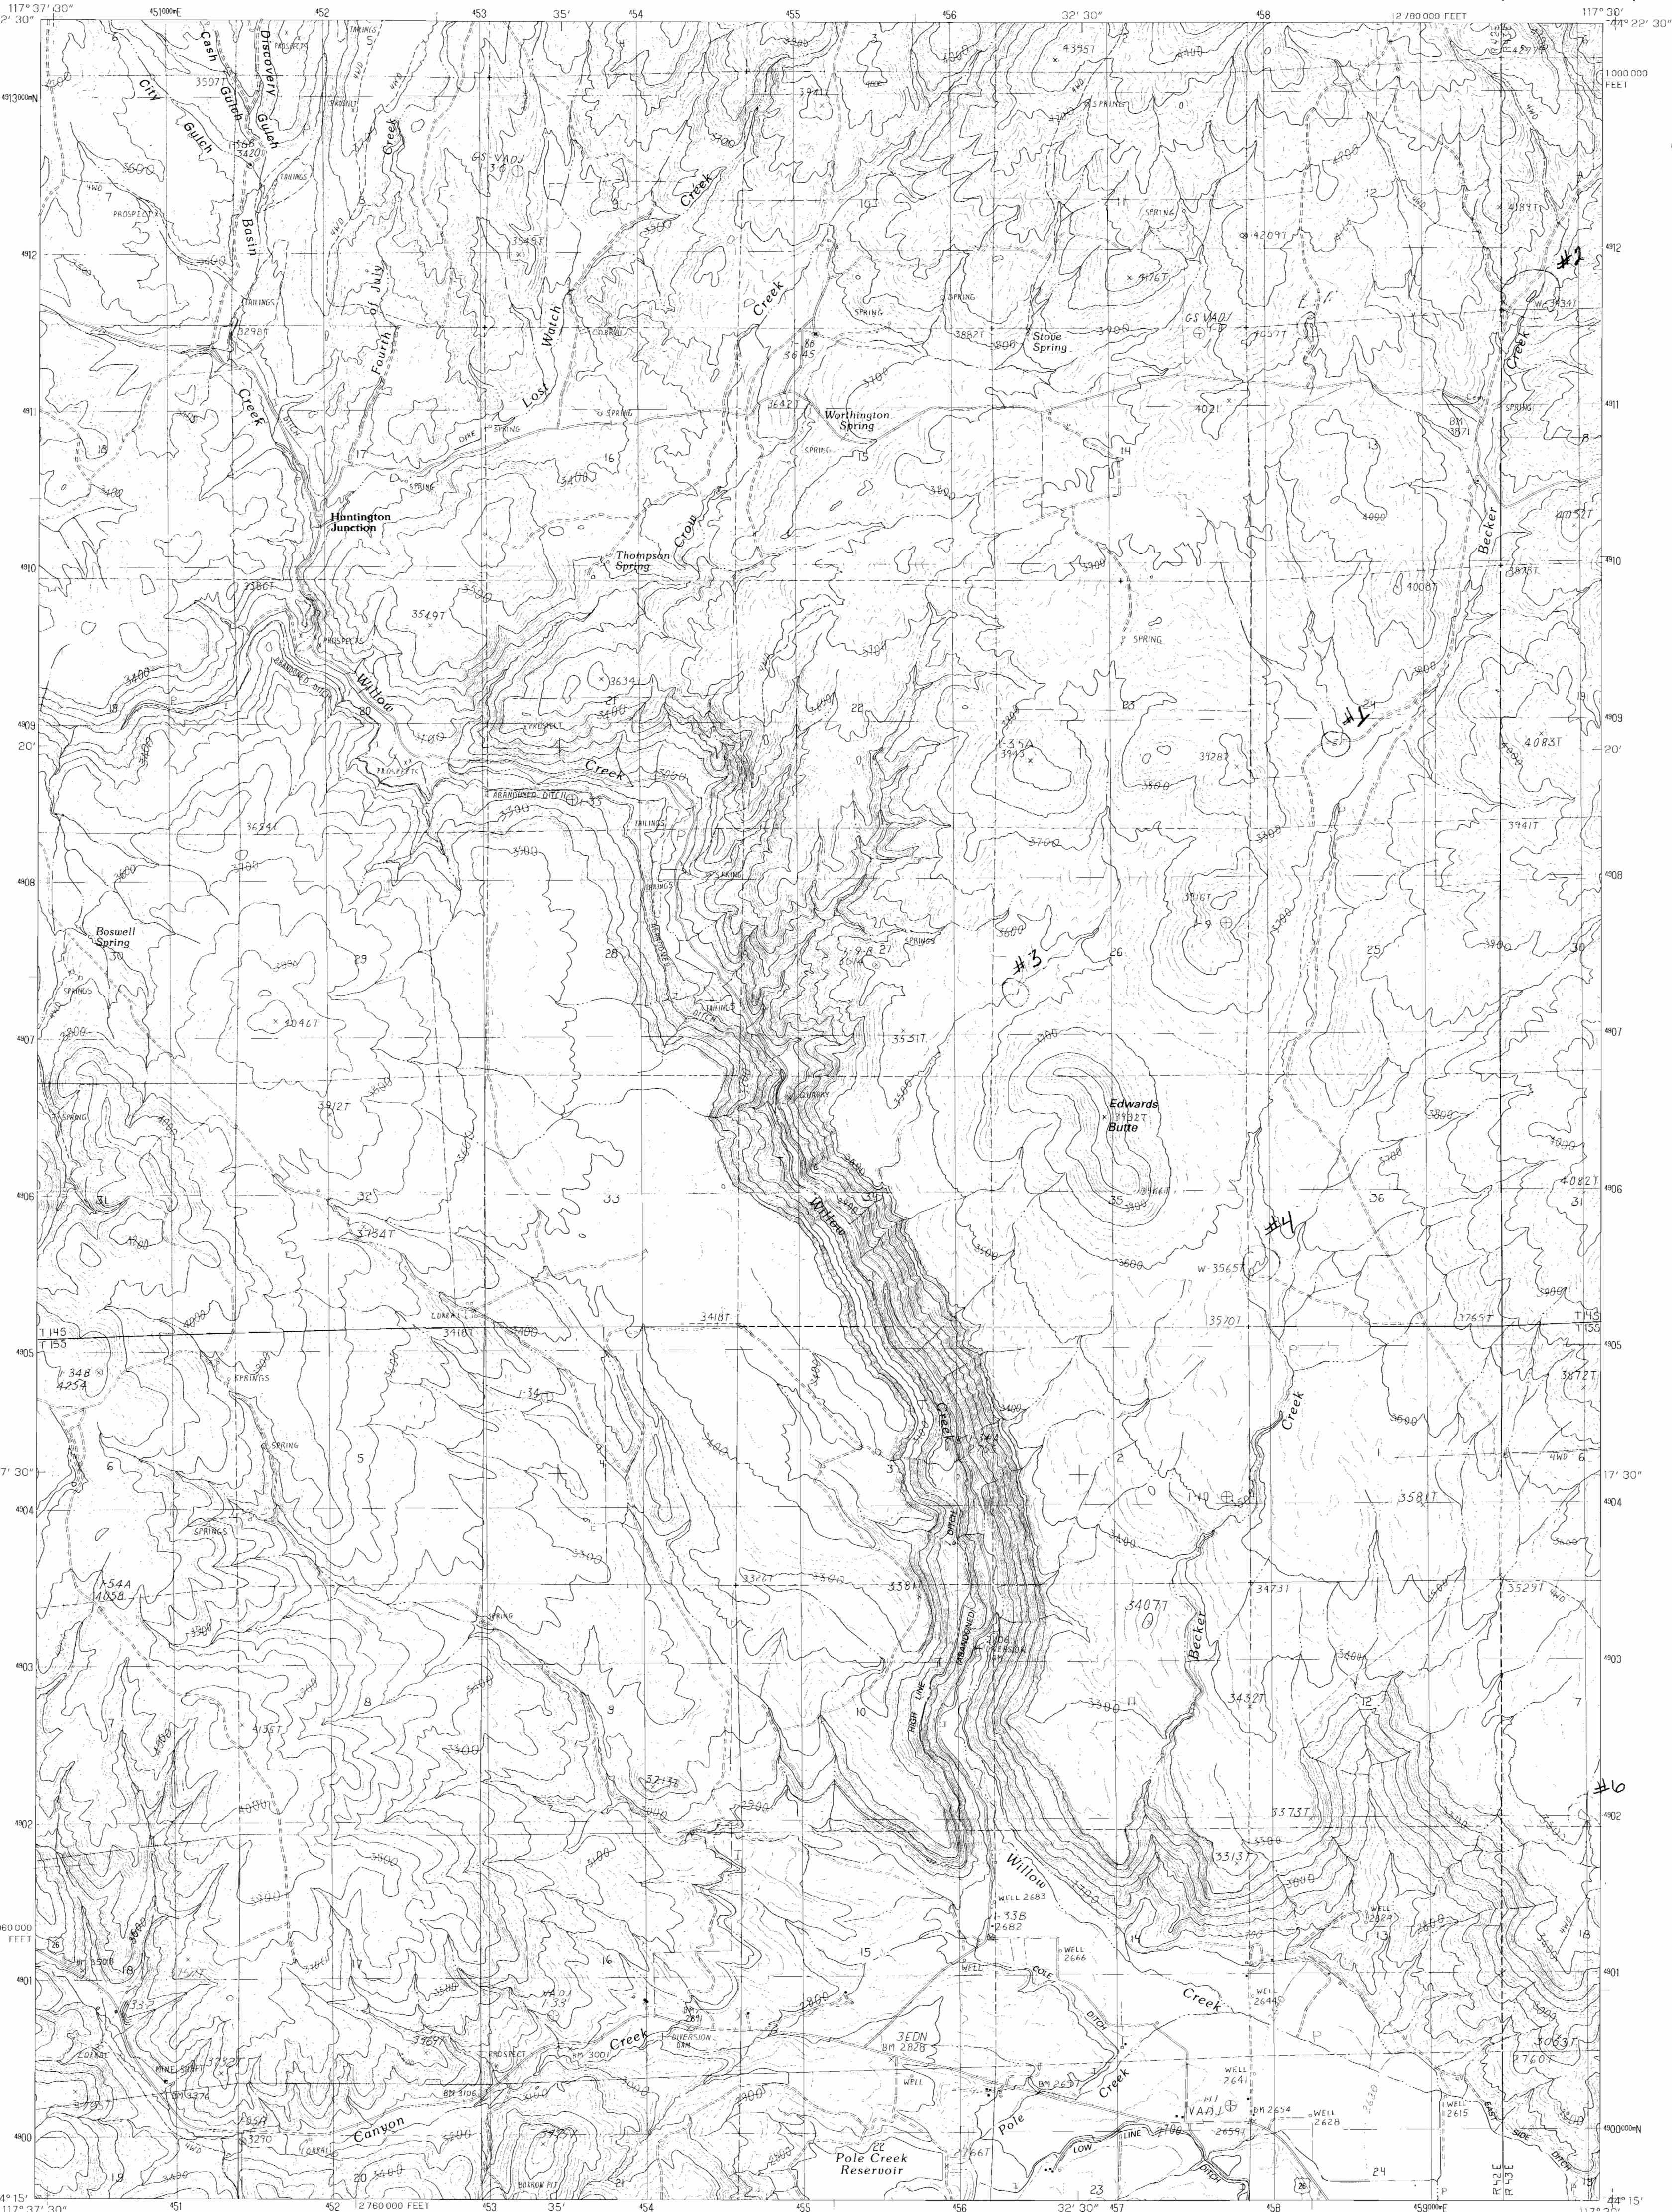

PRODUCED BY THE UNITED STATES GEOLOGICAL SURVEY
CONTROL BY.....USGS AND NOS/NOAA
COMPILED FROM AERIAL PHOTOGRAPHS TAKEN.....1960
REVISED FROM AERIAL PHOTOGRAPHS TAKEN.....1985
FIELD CHECKED.....1987. MAP EDITED.....1990
PROJECTION.....LAMBERT CONFORMAL CONIC
GRID: 1000-METER UNIVERSAL TRANSVERSE MERCATOR.....ZONE 11
10,000-FOOT STATE GRID TICKS.....OREGON, SOUTH ZONE
UTM GRID DECLINATION.....0 24' WEST
1990 MAGNETIC NORTH DECLINATION.....17 00' EAST
VERTICAL DATUM.....NATIONAL GEODETIC VERTICAL DATUM OF 1929
HORIZONTAL DATUM.....1927 NORTH AMERICAN DATUM
To place on the predicted North American Datum of 1983,
move the projection lines as shown by dashed corner ticks
(17 meters north and 80 meters east)
There may be private inholdings within the boundaries of any
Federal or State reservations shown on this map

PROVISIONAL MAP
Produced from original
manuscript drawings. Informa-
tion shown as of date of
field check.

SCALE 1:24 000

1 000 0 1000 2000 3000 4000 5000 6000 7000 8000 9000 10 000
KILOMETERS
METERS
MILES
FEET

CONTOUR INTERVAL 20 FEET

To convert meters to feet multiply by 3.2808
To convert feet to meters multiply by .3048

THIS MAP COMPLIES WITH NATIONAL MAP ACCURACY STANDARDS
FOR SALE BY U. S. GEOLOGICAL SURVEY
DENVER, COLORADO 80225, OR RESTON, VIRGINIA 22092

ROAD LEGEND

Improved Road.....
Unimproved Road.....
Trail.....

Interstate Route U. S. Route State Route

QUADRANGLE LOCATION

1	2	3	1 Bridgeport
			2 Mormon Basin
			3 Blue Valley
4		5	4 Cow Valley East
			5 Birch Creek Meadow
			6 Brady Creek
6	7	8	7 Brogan
			8 Jamieson

ADJOINING 7.5 QUADRANGLE NAMES

BECKER CREEK, OREGON
PROVISIONAL EDITION 1990

44117-C5-TF-024

No Final Proof Map available

No Permit Map available