

Rye Valley Quad
Baker County

REC

DEC 28 1994

WATER RES.
SALEM, OREGON

SENE

SEC 32 T.S. 13S. R. 43E

Pond #8

Source: CREEK + Runoff

Dam Height: 4 ft

Water Depth: 4 ft

Storage Capacity: .03 AF

Outlet Pipe: NONE

		32	D

N ↑

Application No. 81726
Permit No.

RECEIVED

AUG 26 1996

WATER RESO. DEPT.
SALEM, OREGON

Rye Valley Quad.
BAKER County

RECEIVED
DEC 28 1994
WATER RES. DEPT.
SALEM, OREGON

SENE

SEC. 31

T.S. 13s

R. 43E

Pond #9

Source: Rumoff

Dam Height: 5 ft

Water Depth: 3 ft

Storage Capacity: .31 AF

Outlet Pipe: NONE

		31	

N ↑

Application No. 81720
Permit No. 2153

RECEIVED

AUG 26 1996

WATER RESOURCES DEPT.
SALEM, OREGON

Rye Valley Quad.
Baker County

SW 1/4
d NW 1/4

SEC. 30

T. 5. 13 S

R 43 E

REC

DEC 28 1994

WATER RES.
SALEM, OREGON

Pond #10

Source: CREEK + Runoff

Dam Height: 16 ft

Water Depth: 4 ft

Storage Capacity: .4 AF

Outlet Pipe: NONE

		30	

N ↑

Application No. 81720
Permit No.

file 2153

RECEIVED

AUG 26 1996

WATER RESOURCES DEPT.
SALEM, OREGON

Rye Valley Quad.
Baker County

RF 11111

DEC 2 1994

WATER R.
SALEM, OREGON

SWNE

SEC. 20

T.S. 13S

R. 43E

Ponds # 11

Source: CREEK + Runoff

Dam Height: 4ft Each

Water Depth: 3ft Each

Storage Capacity: .1 AF Each

Outlet Pipe: NONE

Application No. 81720
Permit No.

2153

RECEIVED

AUG 26 1996

WATER RESOURCES DEPT.
SALEM, OREGON

Rye Valley Quad.
Baker County

RECEIVED

DEC 29 1994

WATER RESOURCES DEPT.
SALEM, OREGON

NWSW

SEC. 19

T.S. 13S

R. 43E

Pond # 12

Source: CREEK + Runoff

Dam Height: 5 ft

Water Depth: 4 ft

Storage Capacity: .8 ft

Outlet Pipe: NONE

Application No. 81720
Permit No.

2153

RECEIVED

AUG 26 1996

WATER RESOURCES DEPT.
SALEM, OREGON

UNITED STATES
DEPARTMENT OF THE INTERIOR
GEOLOGICAL SURVEY

RYE VALLEY QUADRANGLE
OREGON
7.5 MINUTE SERIES (TOPOGRAPHIC)

RECEIVED


DEC 2 1994

WATER RESOURCES DEPT.
SALEM, OREGON

0218 01

WATER RESOURCES DEPT.
SALEM, OREGON


RECEIVED
AUG 26 1996

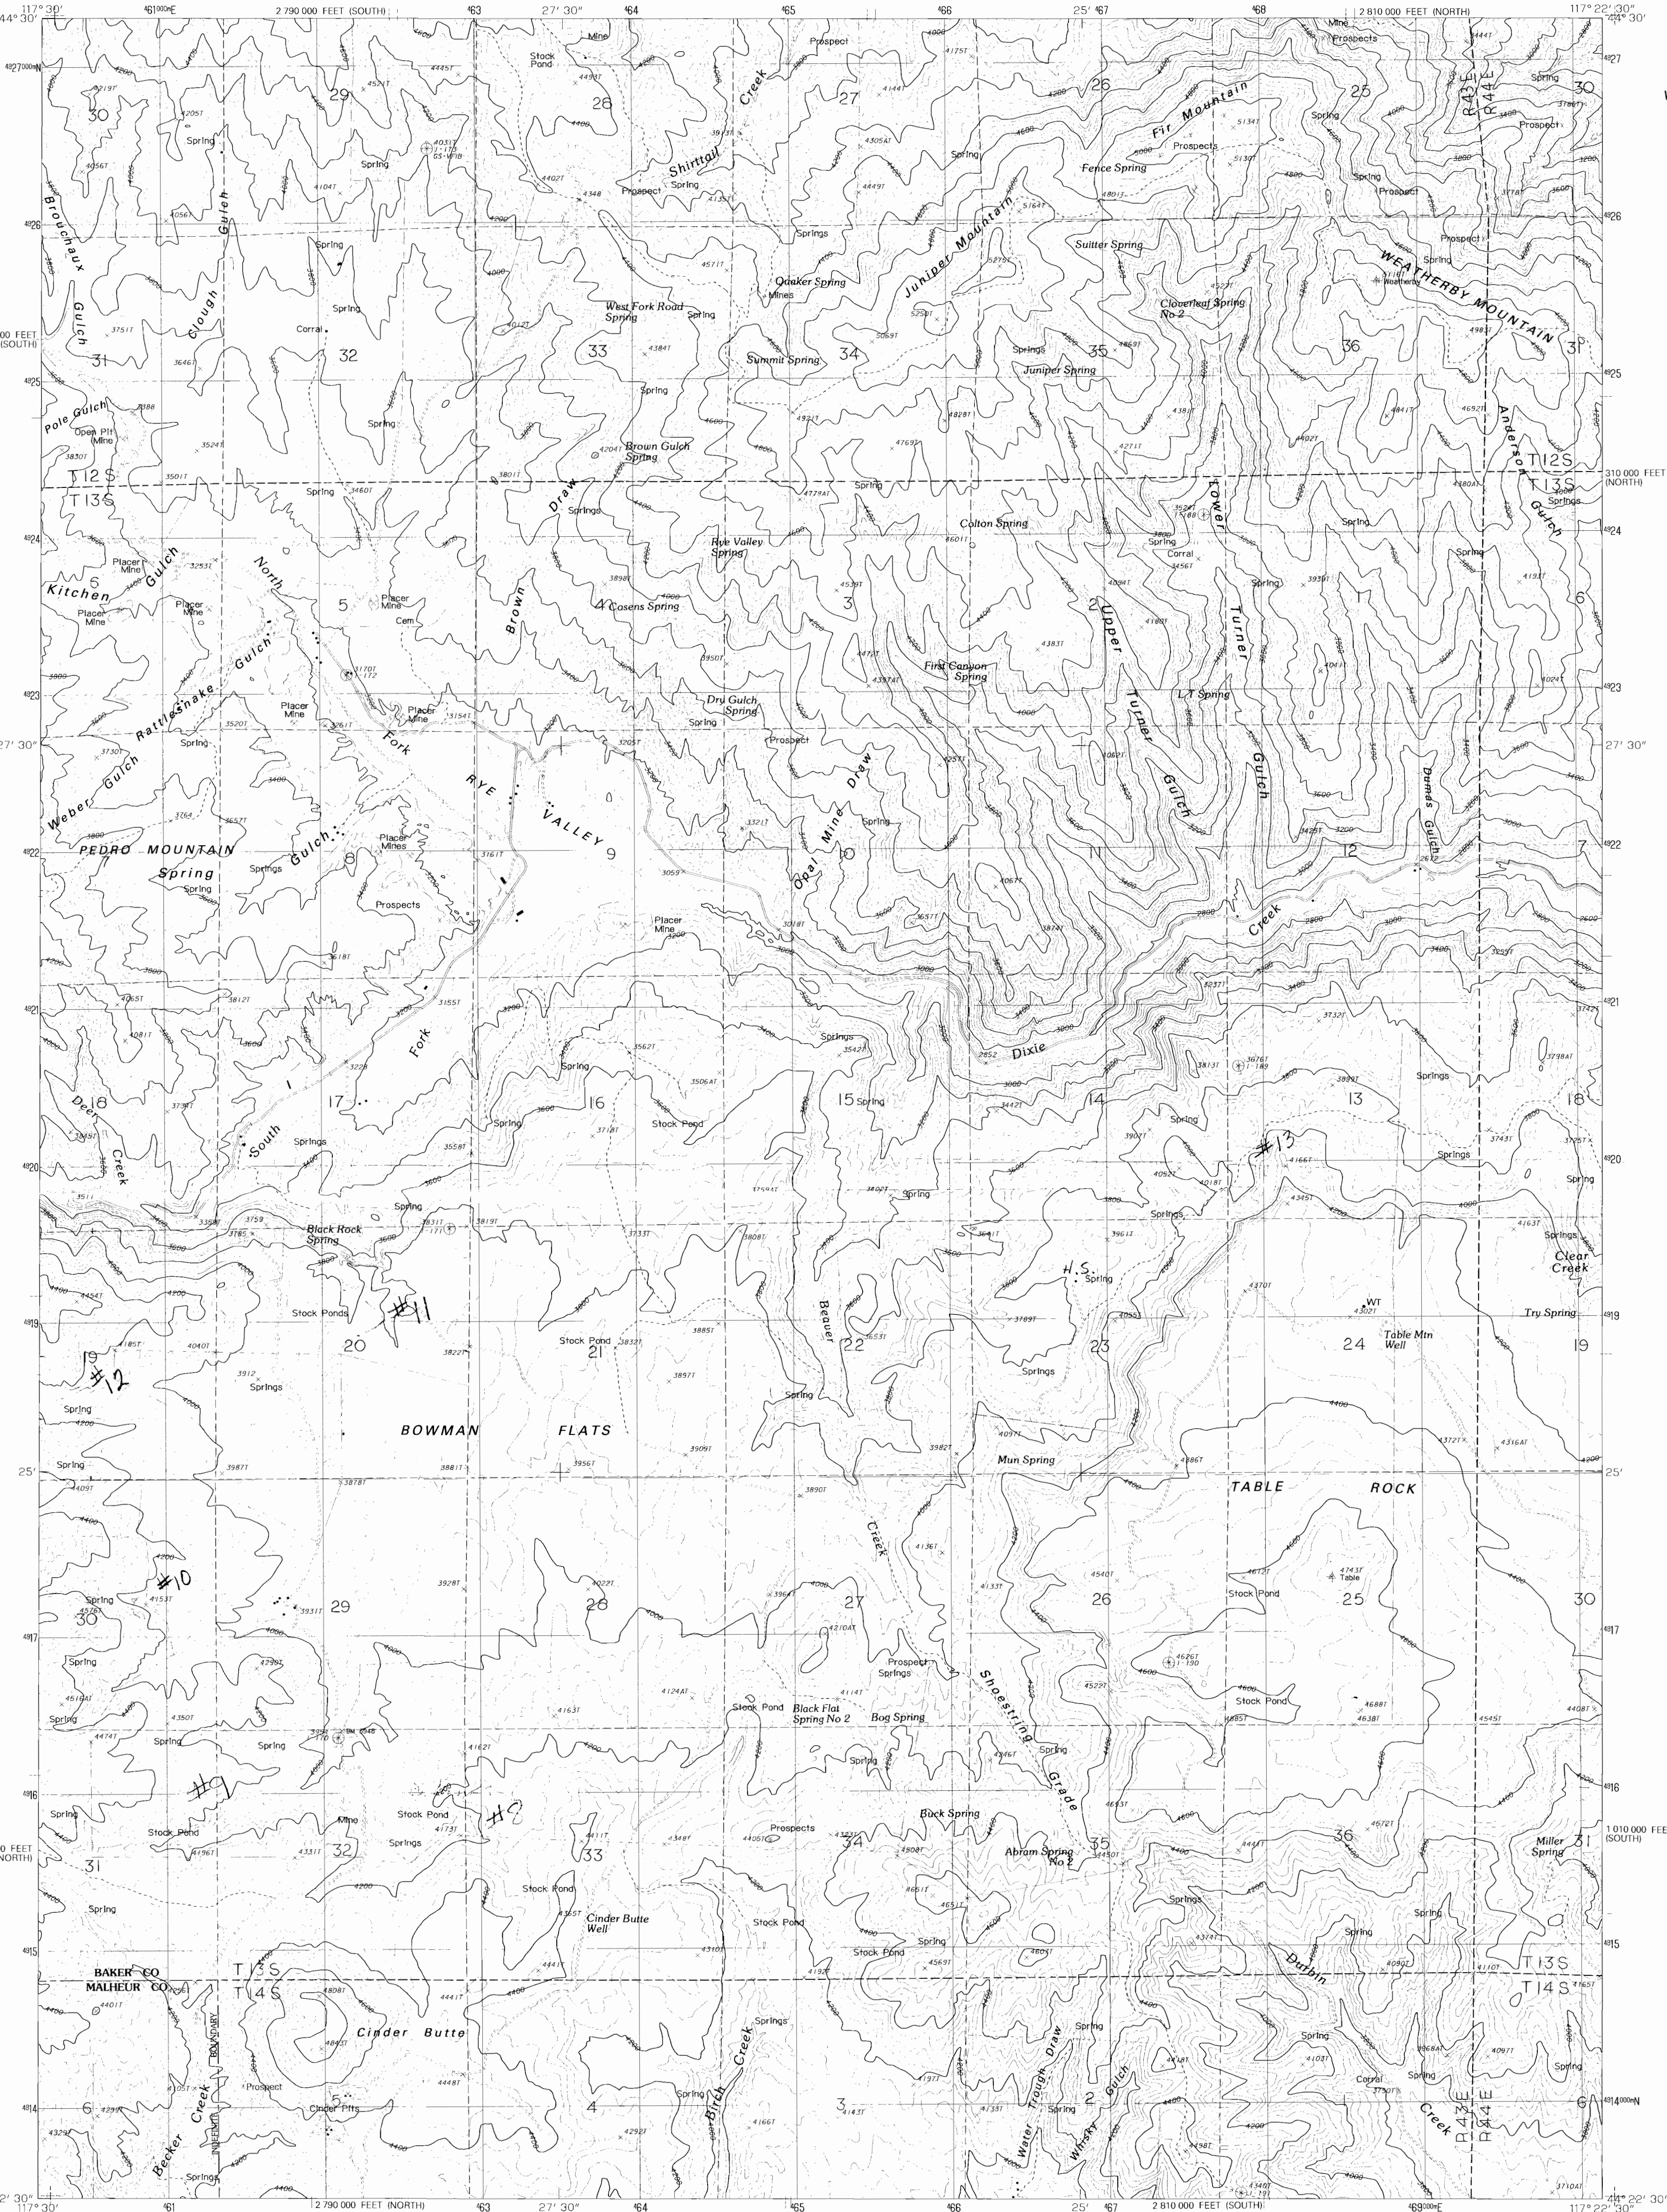

PRODUCED BY THE UNITED STATES GEOLOGICAL SURVEY
CONTROL BY USGS AND NOS/NOAA
COMPILED FROM AERIAL PHOTOGRAPHS TAKEN 1984
FIELD CHECKED 1985. MAP EDITED 1988
PROJECTION LAMBERT CONFORMAL CONIC
GRID 1000-METER UNIVERSAL TRANSVERSE MERCATOR, ZONE 11
10000-FOOT STATE GRID TICKS, OREGON NORTH AND SOUTH ZONES
UTM GRID DECLINATION 018° WEST
1988 MAGNETIC NORTH DECLINATION 17°30' EAST
VERTICAL DATUM NATIONAL GEODETIC VERTICAL DATUM OF 1929
HORIZONTAL DATUM 1927 NORTH AMERICAN DATUM
To place on the predicted North American Datum of 1983,
move the projection lines as shown by dashed corner ticks
(17 meters north and 80 meters east).
There may be private inholdings within the boundaries of any
Federal or State reservations shown on this map.
No distinction made between houses, barns, and other buildings

PROVISIONAL MAP
Produced from original
manuscript drawings. Infor-
mation shown as of date of
photography.

SCALE 1:24 000

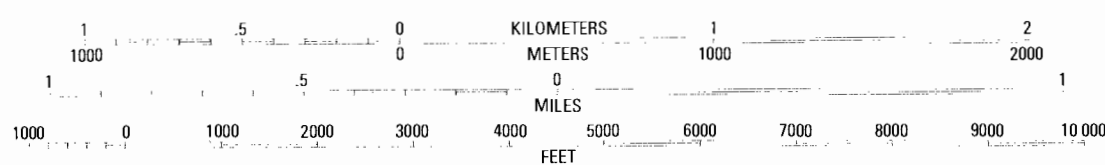

CONTOUR INTERVAL 40 FEET

To convert meters to feet multiply by 3.2808
To convert feet to meters multiply by .3048

THIS MAP COMPLIES WITH NATIONAL MAP ACCURACY STANDARDS
FOR SALE BY U.S. GEOLOGICAL SURVEY
DENVER, COLORADO 80225, OR RESTON, VIRGINIA 22092



QUADRANGLE LOCATION

1	2	3	1 Lost Basin
4	5	2 Durkee	3 Big Lookout Mountain
6	7	4 Mormon Basin	5 Lime
		6 Becker Creek	7 Birch Creek Meadow
		8 Huntington	

ADJOINING 7.5 QUADRANGLE NAMES

ROAD LEGEND

Improved Road
Unimproved Road
Trail
Interstate Route U.S. Route State Route

RYE VALLEY, OREGON
PROVISIONAL EDITION 1988

44117-D4-TF-024


UNITED STATES
DEPARTMENT OF THE INTERIOR
GEOLOGICAL SURVEY

BIRCH CREEK MEADOW QUADRANGLE
OREGON
7.5 MINUTE SERIES (TOPOGRAPHIC)

RECEIVED

DEC 2 1994

WATER RESOURCES DEPT.
SALEM, OREGON

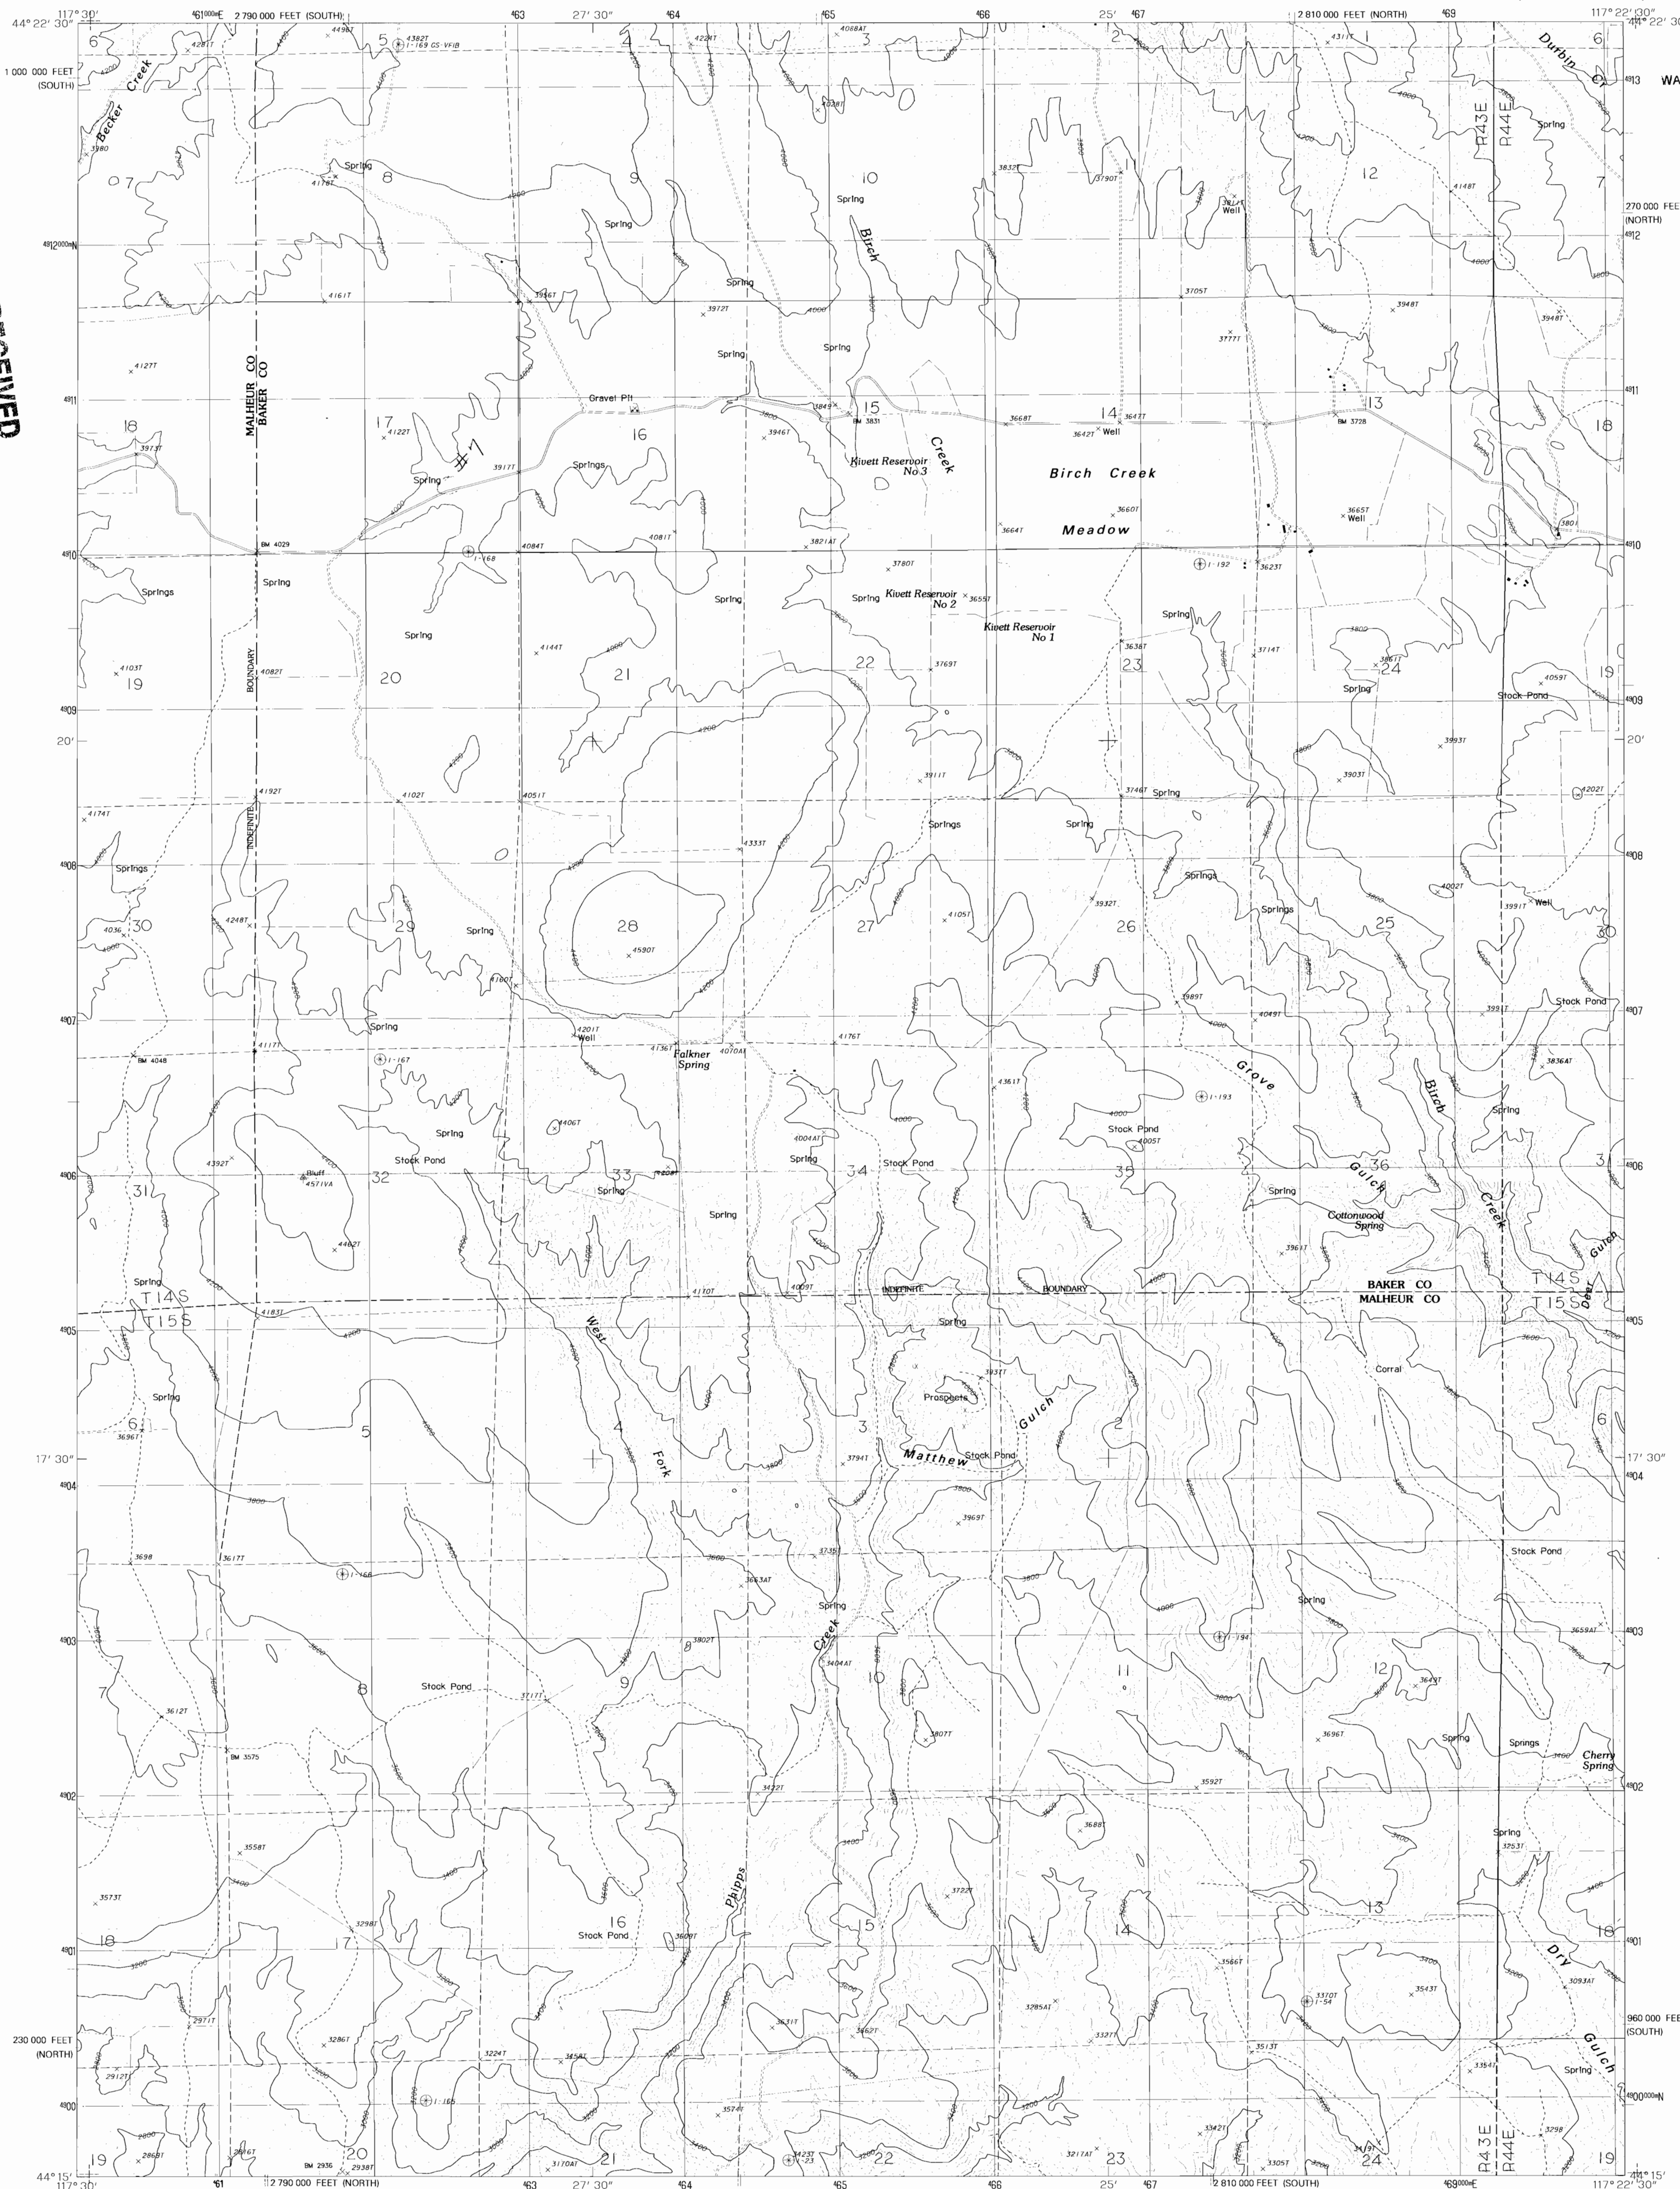

PRODUCED BY THE UNITED STATES GEOLOGICAL SURVEY
CONTROL BY USGS AND NOS/NOAA
COMPILED FROM AERIAL PHOTOGRAPHS TAKEN 1984
FIELD CHECKED 1985 MAP EDITED 1988
PROJECTION LAMBERT CONFORMAL CONIC
GRID: 1000-METER UNIVERSAL TRANSVERSE MERCATOR ZONE 11
10,000-FOOT STATE GRID TICKS: OREGON NORTH AND SOUTH ZONES
UTM GRID DECLINATION 018° WEST
1988 MAGNETIC NORTH DECLINATION 1730° EAST
VERTICAL DATUM NATIONAL GEODETIC VERTICAL DATUM OF 1929
HORIZONTAL DATUM 1927 NORTH AMERICAN DATUM
To place on the predicted North American Datum of 1983,
move the projection lines as shown by dashed corner ticks
(17 meters north and 80 meters east).
There may be private inholdings within the boundaries of any
Federal or State reservations shown on this map.
No distinction made between houses, barns, and other buildings

PROVISIONAL MAP
Produced from original
manuscript drawings. In-
formation shown as of date of
photography.

SCALE 1:24 000
KILOMETERS 0 1 2
METERS 0 1000 2000 3000 4000 5000 6000 7000 8000 9000 10 000
MILES 0 1 2
FEET 0 1000 2000 3000 4000 5000 6000 7000 8000 9000 10 000
CONTOUR INTERVAL 40 FEET
To convert feet to meters multiply by .3048
To convert meters to feet multiply by 3.2808
THIS MAP COMPLIES WITH NATIONAL MAP ACCURACY STANDARDS
FOR SALE BY U.S. GEOLOGICAL SURVEY
DENVER, COLORADO 80225, OR RESTON, VIRGINIA 22092

ROAD LEGEND
Improved Road
Unimproved Road
Trail
Interstate Route U.S. Route State Route
QUADRANGLE LOCATION
ADJOINING 7.5' QUADRANGLE NAMES
1 Mormon Basin
2 Rye Valley
3 Lime
4 Becker Creek
5 Huntington
6 Brogan
7 Jamieson
8 McCarthy Ridge
BIRCH CREEK MEADOW, OREGON
PROVISIONAL EDITION 1988
44117-C4-TF-024

No Final Proof Map available

No Permit Map available