


T. 295., R. 14 & 15 W.W.M

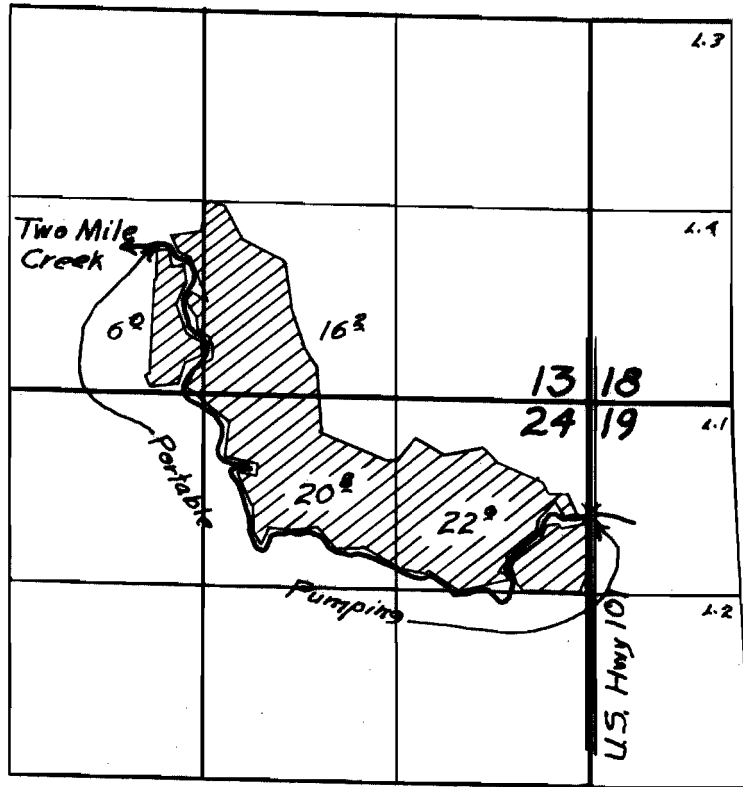

**FINAL PROOF SURVEY**

UNDER

Application No. 22051 Permit No. 17313

IN NAME OF

CHRISTIAN F. RICHERT

Surveyed 17. March 1955, by H.L. Coffman