




T. 41 S., R. 13 W., W.M.

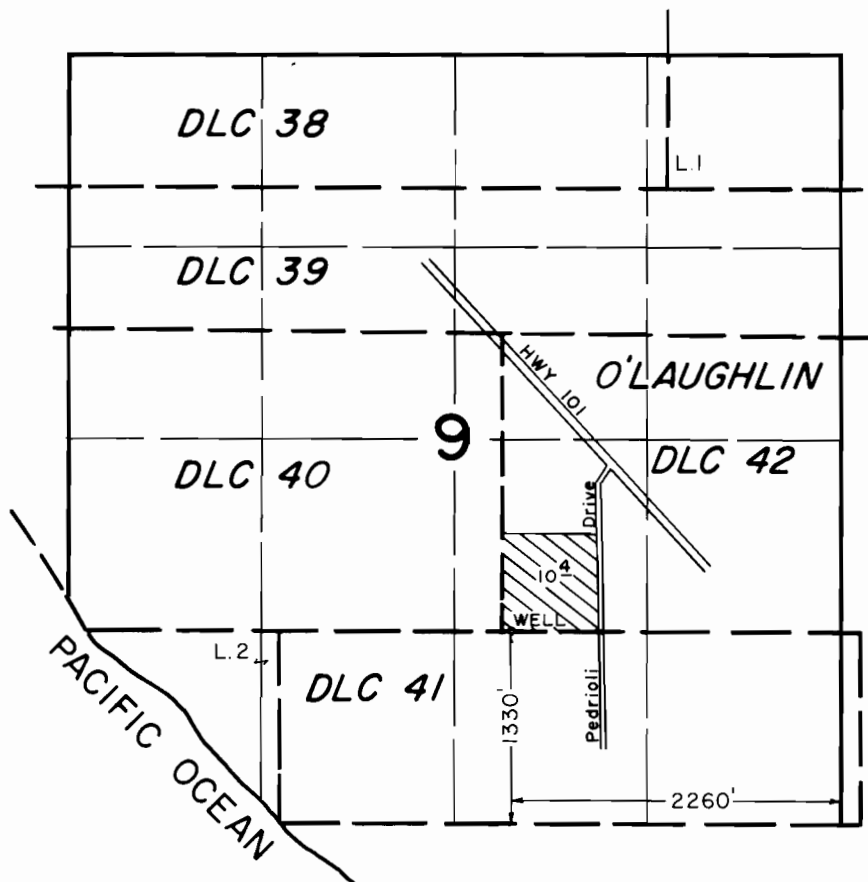

SCALE: 1" = 1320'

FINAL PROOF SURVEY UNDER

Application No. G-11377. Permit No. G-10573...
IN NAME OF

ROBIN W., KELLY B. & HENRY J. ITZEN

Surveyed JULY 24 1989, by B. S. JAMES.....