


T. 35 S., R. 11 W., W. M.

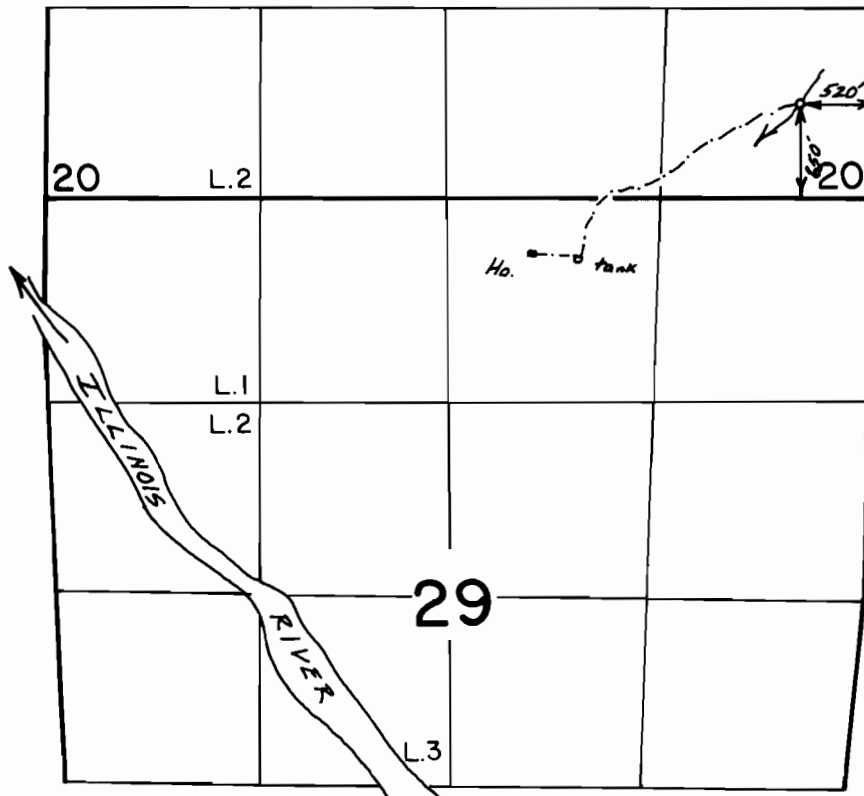

Scale 1" = 1320'

FINAL PROOF SURVEY
UNDER

Application No. 59771 Permit No. 44939
IN NAME OF

MICHAEL A. GAINES

Surveyed July 30, 1989, by B.S. JAMES