



T.37S., R.7W., W.M.

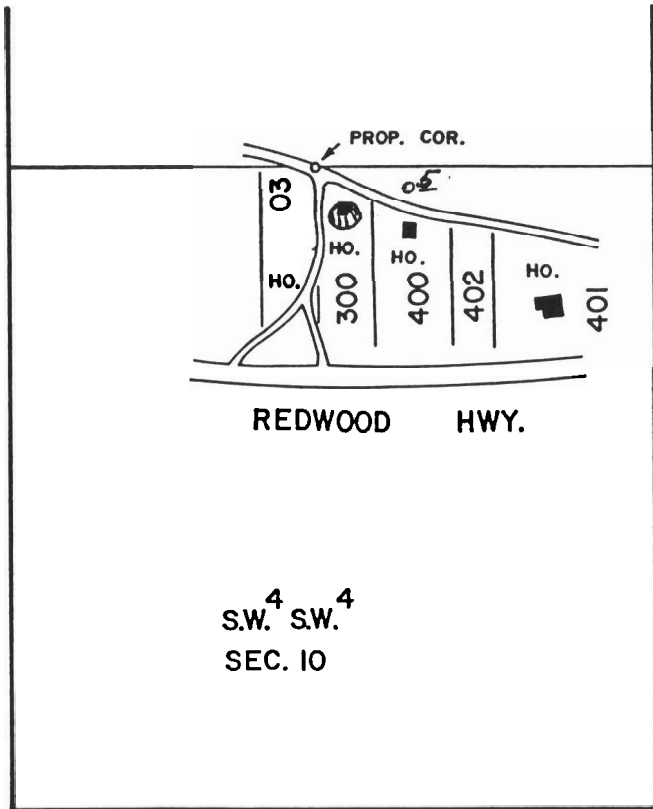

SCALE : 1" = 400 FT.

T.37S., R.7W., W.M.

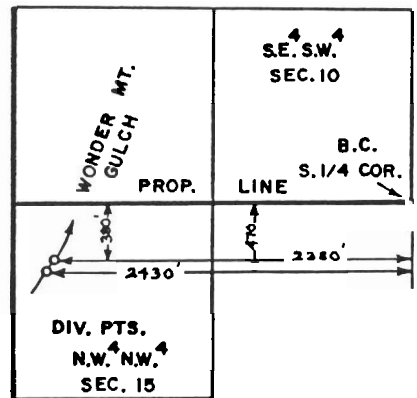

**FINAL PROOF SURVEY**

UNDER

TRANSFER NO. 4493  
 APPLICATION NO. 60078  
 PERMIT NO. 45655  
 ARTIE JAMES & LOIS ANN MARTIN  
 LOT 300

AUGUST 16, 1982; B.S. JAMES  
 SURVEYED: APRIL 25, 1980; B.R. SUND.

D.H.M.  
 P.T.S.-1980-14-A