
T.10S., R.2W., W.M.

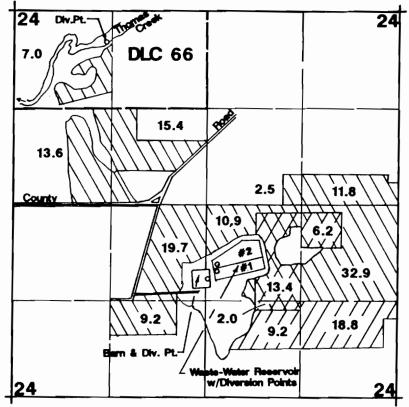


Thomas Creek Div. Pt. located 460'S & 1270'E from NW corner Section 24.

Barn Div. Pt. located 1020'S & 50'E from center Section 24.

Pond Div. Pt.#1 located 880'S & 140'E from center Section 24.

Pond Div. Pt.#2 located 860'S & 155'E from center Section 24.



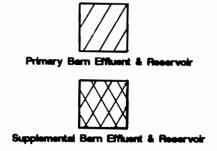



Final Proof Survey

R-69817

R-11107

Application #:

69818

Permit #:

50670

In Name Of

Ray Ruby

Surveyed on February 26, 1994 by JM Schuette

Getified Water Right Example
#117

James M. Schwette
Nov. 19: 19:87

TE OF OREGOT

THIS MAP WAS PREPARED FOR THE PURPOSE OF IDENTIFYING THE LOCATION OF A WATER RIGHT ONLY AND IS NOT INTENDED TO PROVIDE LEGAL DIMENSIONS OR LOCATION OF PROPERTY OWNERSHIP LINES.