T.10S., R.2W., W.M.

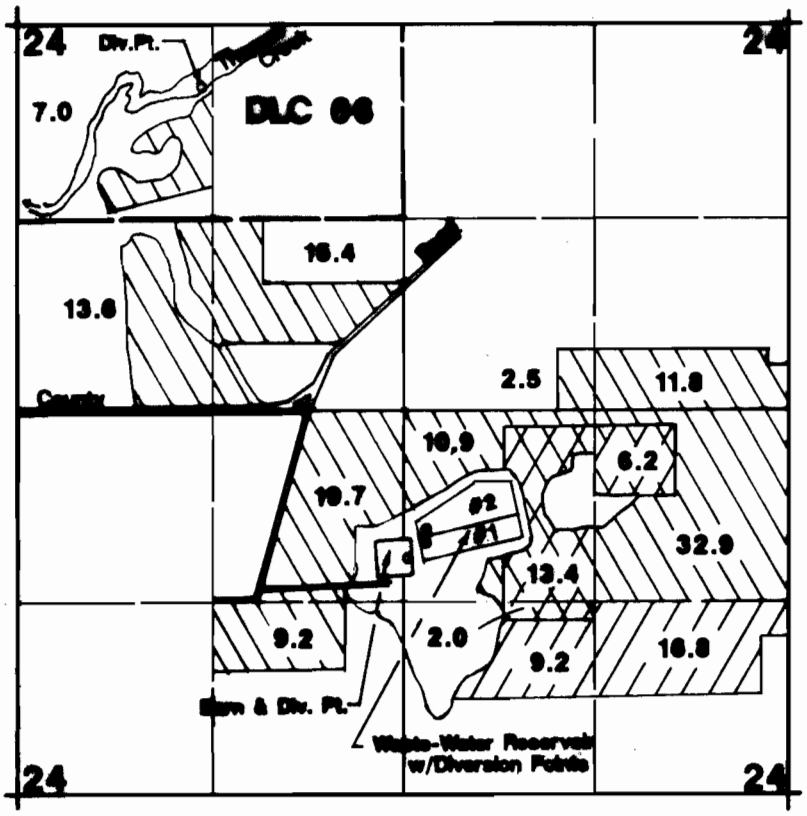

1" = 1320'

Primary Barn Effluent & Reservoir

Supplemental Barn Effluent & Reservoir

Primary Thomas Creek
Supplemental Barn Effluent & Reservoir

Thomas Creek Div. Pt. located 460'S & 1270'E from NW corner Section 24.
Barn Div. Pt. located 1020'S & 50'E from center Section 24.
Pond Div. Pt.#1 located 860'S & 140'E from center Section 24.
Pond Div. Pt.#2 located 860'S & 195'E from center Section 24.

Final Proof Survey

R-69817 R-11107

Application #: 69818 Permit #: 50670

In Name Of

Ray Ruby

Surveyed on February 26, 1994 by JM Schuette

Certified Water Right Examiner
#117
James M. Schuette
Nov. 19, 1987
STATE OF OREGON

THIS MAP WAS PREPARED FOR THE PURPOSE OF IDENTIFYING THE LOCATION OF A WATER RIGHT ONLY AND IS NOT INTENDED TO PROVIDE LEGAL DIMENSIONS OR LOCATION OF PROPERTY OWNERSHIP LINES.