


# T. 4 S., R. 4 S., W.M.

Location: The NE 1/4 of the NW 1/4 of  
Section 23, T. 4 S., R. 4 W., W.M.,  
part of the Vincent Snelling D.L.C.  
No. 52, Yamhill County, Oregon.

Date: 21 March 1996

By: Matt Dunckel & Assoc.  
19010 Baker Creek Road  
McMinnville, OR 97128  
Phone: 472-7904

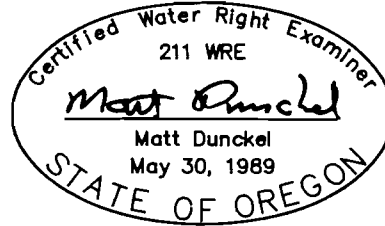

Scale: 1" = 400'

15 14

22 23

SE corner of the Madison  
Malone DLC #49, a referenced  
1" IP is North 33.49 feet.

**RECEIVED**

**MAR 28 1996**

WATER RESOURCES DEPT  
SALEM, OREGON

N 64°47'07" W  
4571.61'

LOOP

Swale

Reservoir

RIVERSIDE

ASH AVE.

(vacated)

## FINAL PROOF SURVEY

UNDER

Application No. R-73415 Permit No. R-11497

IN NAME OF

**CHRISTIAN & DEANNE MAJEWSKI**

Surveyed March 20, 1996