


NW Cor. Sec. 53 NW Quarter of 33 2 North 17 East Willamette M.

1994

Scott Canyon Rd


Beginning point of legal description to Road

Diversion Point 1110 FT in stream Bottom
Down Stream From culvert under
county RD

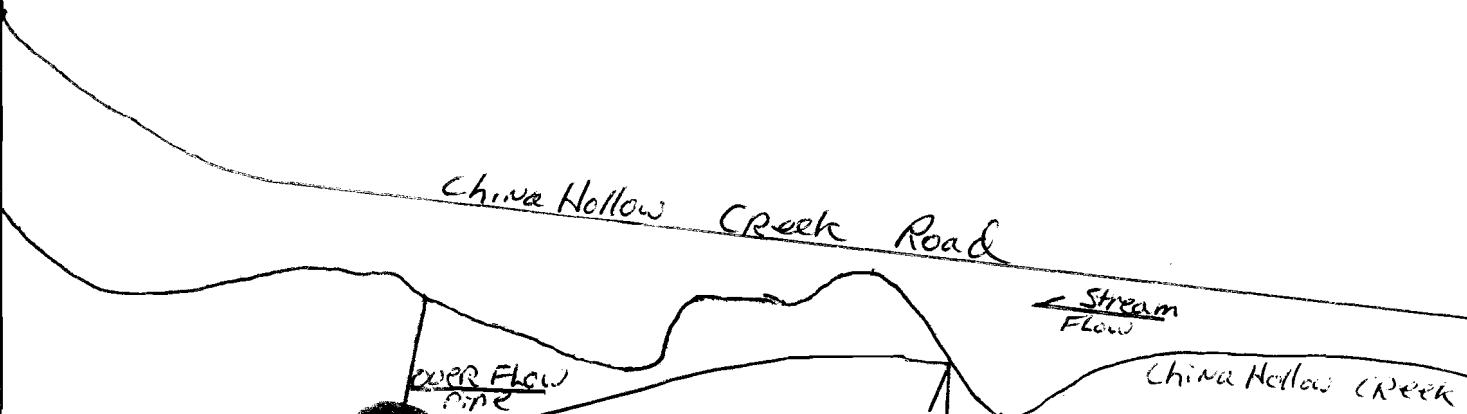

OVER FLOW
PIPE
EARTH DAM

DIVERSION
POINT

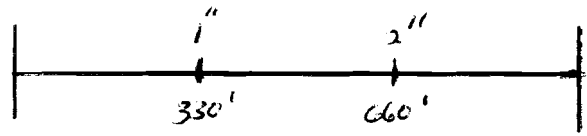

Scale = 1 inch = 330 FT

No. 73967

No.

"CERTIFICATE NO. 00105"

73969

CERTIFICATE NO. 00105

MAY 23 1994

WATER RESOURCES UNIT
SALEM, OREGON

1
N

29 28
32 33

T92

2
523

HEL

1 Pond
746

NHEL

T210

NHEL

T56

2
654

HEL

NHEL

5
259

NHEL