

RECEIVED

JAN 26 1996

WATER RESOURCES DEPT.
SALEM, OREGON

RECEIVED

MAY 17 1994

WATER RESOURCES DEPT.
SALEM, OREGON

RECORD OF SURVEY FOR KEITH SUMMERALL

IN THE NE 1/4 SECTION 23, T.2 N., R.3 W., W.M., Tax Lot 100
WASHINGTON COUNTY, OREGON

BASIS OF BEARINGS: C. S. 15, 690

SCALE 1"=400'

SET 5/8" X 30" I.R. W/PLASTIC CAP — O

REGISTERED
PROFESSIONAL
LAND SURVEYOR


Johnnie M. Summers

OREGON
AUGUST 22, 1976
JOHNNIE M. SUMMERS
1943

Application No. *R-74052*
Permit No.

JOHNNIE M. SUMMERS P.L.S., INC.
323 S.E. 3rd 648-2019

"CERTIFICATE NO. 69142"
FND. 5/8" I.R.

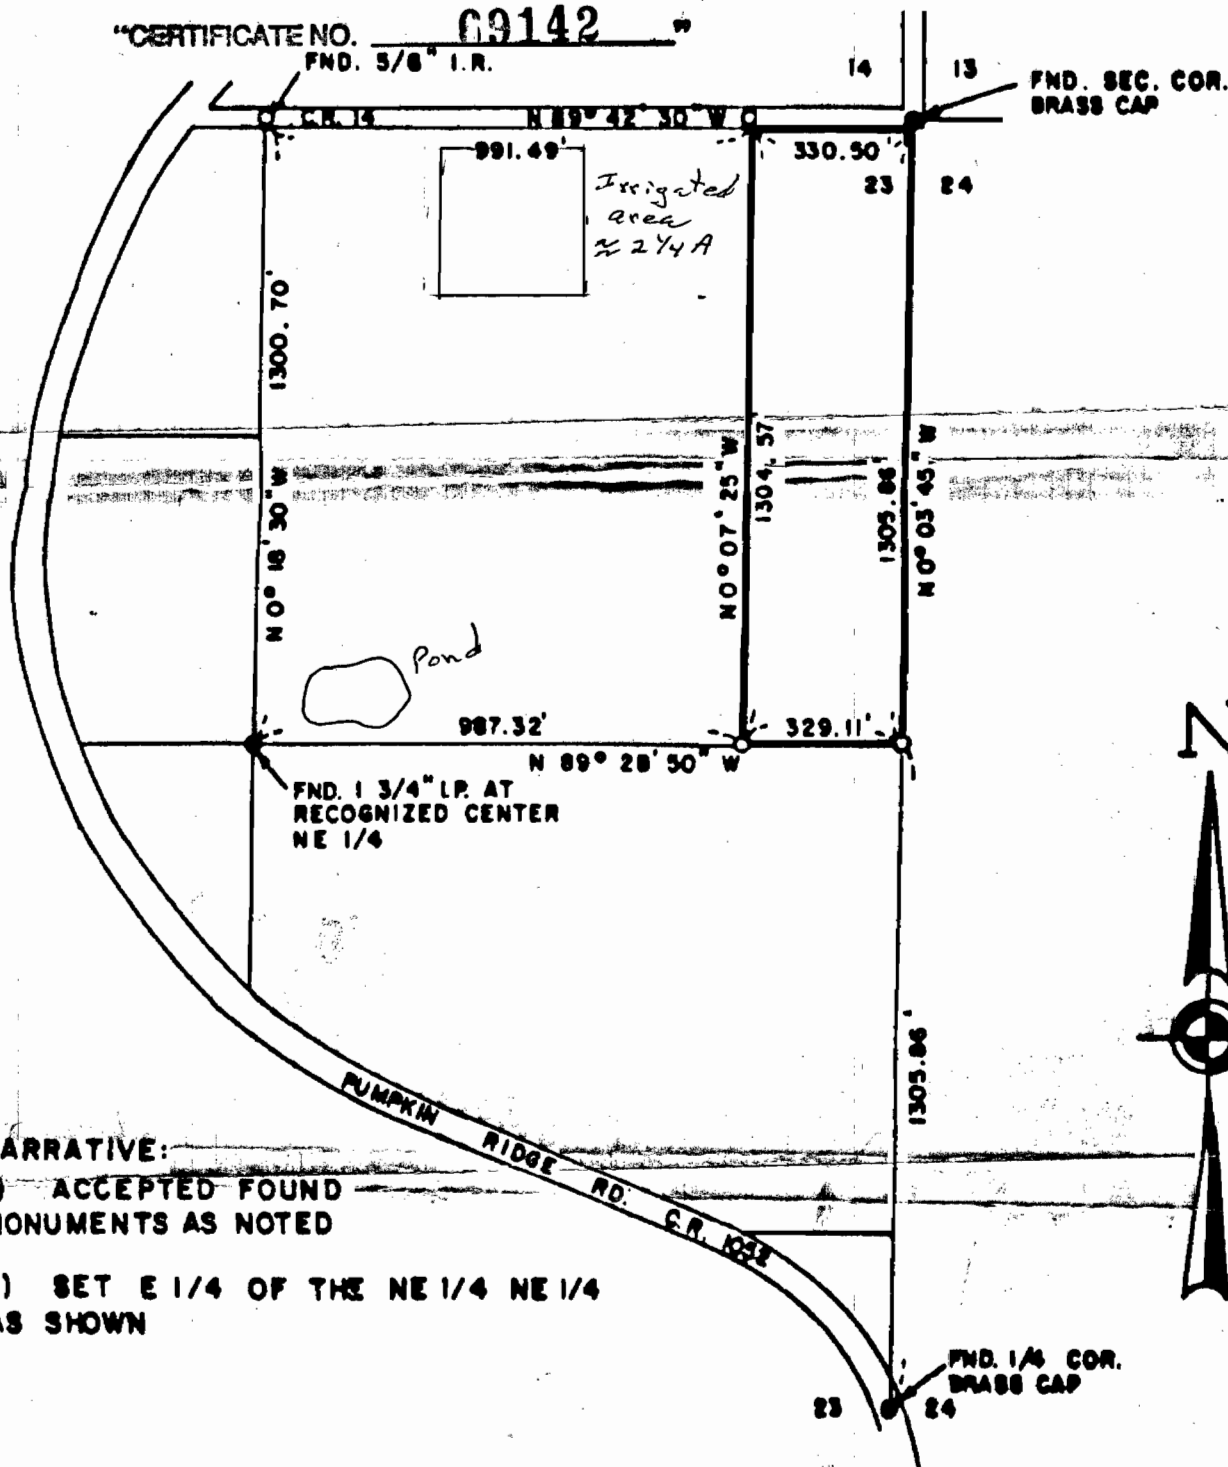

NARRATIVE:

- 1) ACCEPTED FOUND MONUMENTS AS NOTED
- 2) SET E 1/4 OF THE NE 1/4 NE 1/4 AS SHOWN