


UNITED STATES  
DEPARTMENT OF THE INTERIOR  
GEOLOGICAL SURVEY

LAURELWOOD QUADRANGLE  
OREGON  
7.5 MINUTE SERIES (TOPOGRAPHIC)

DATED 1956

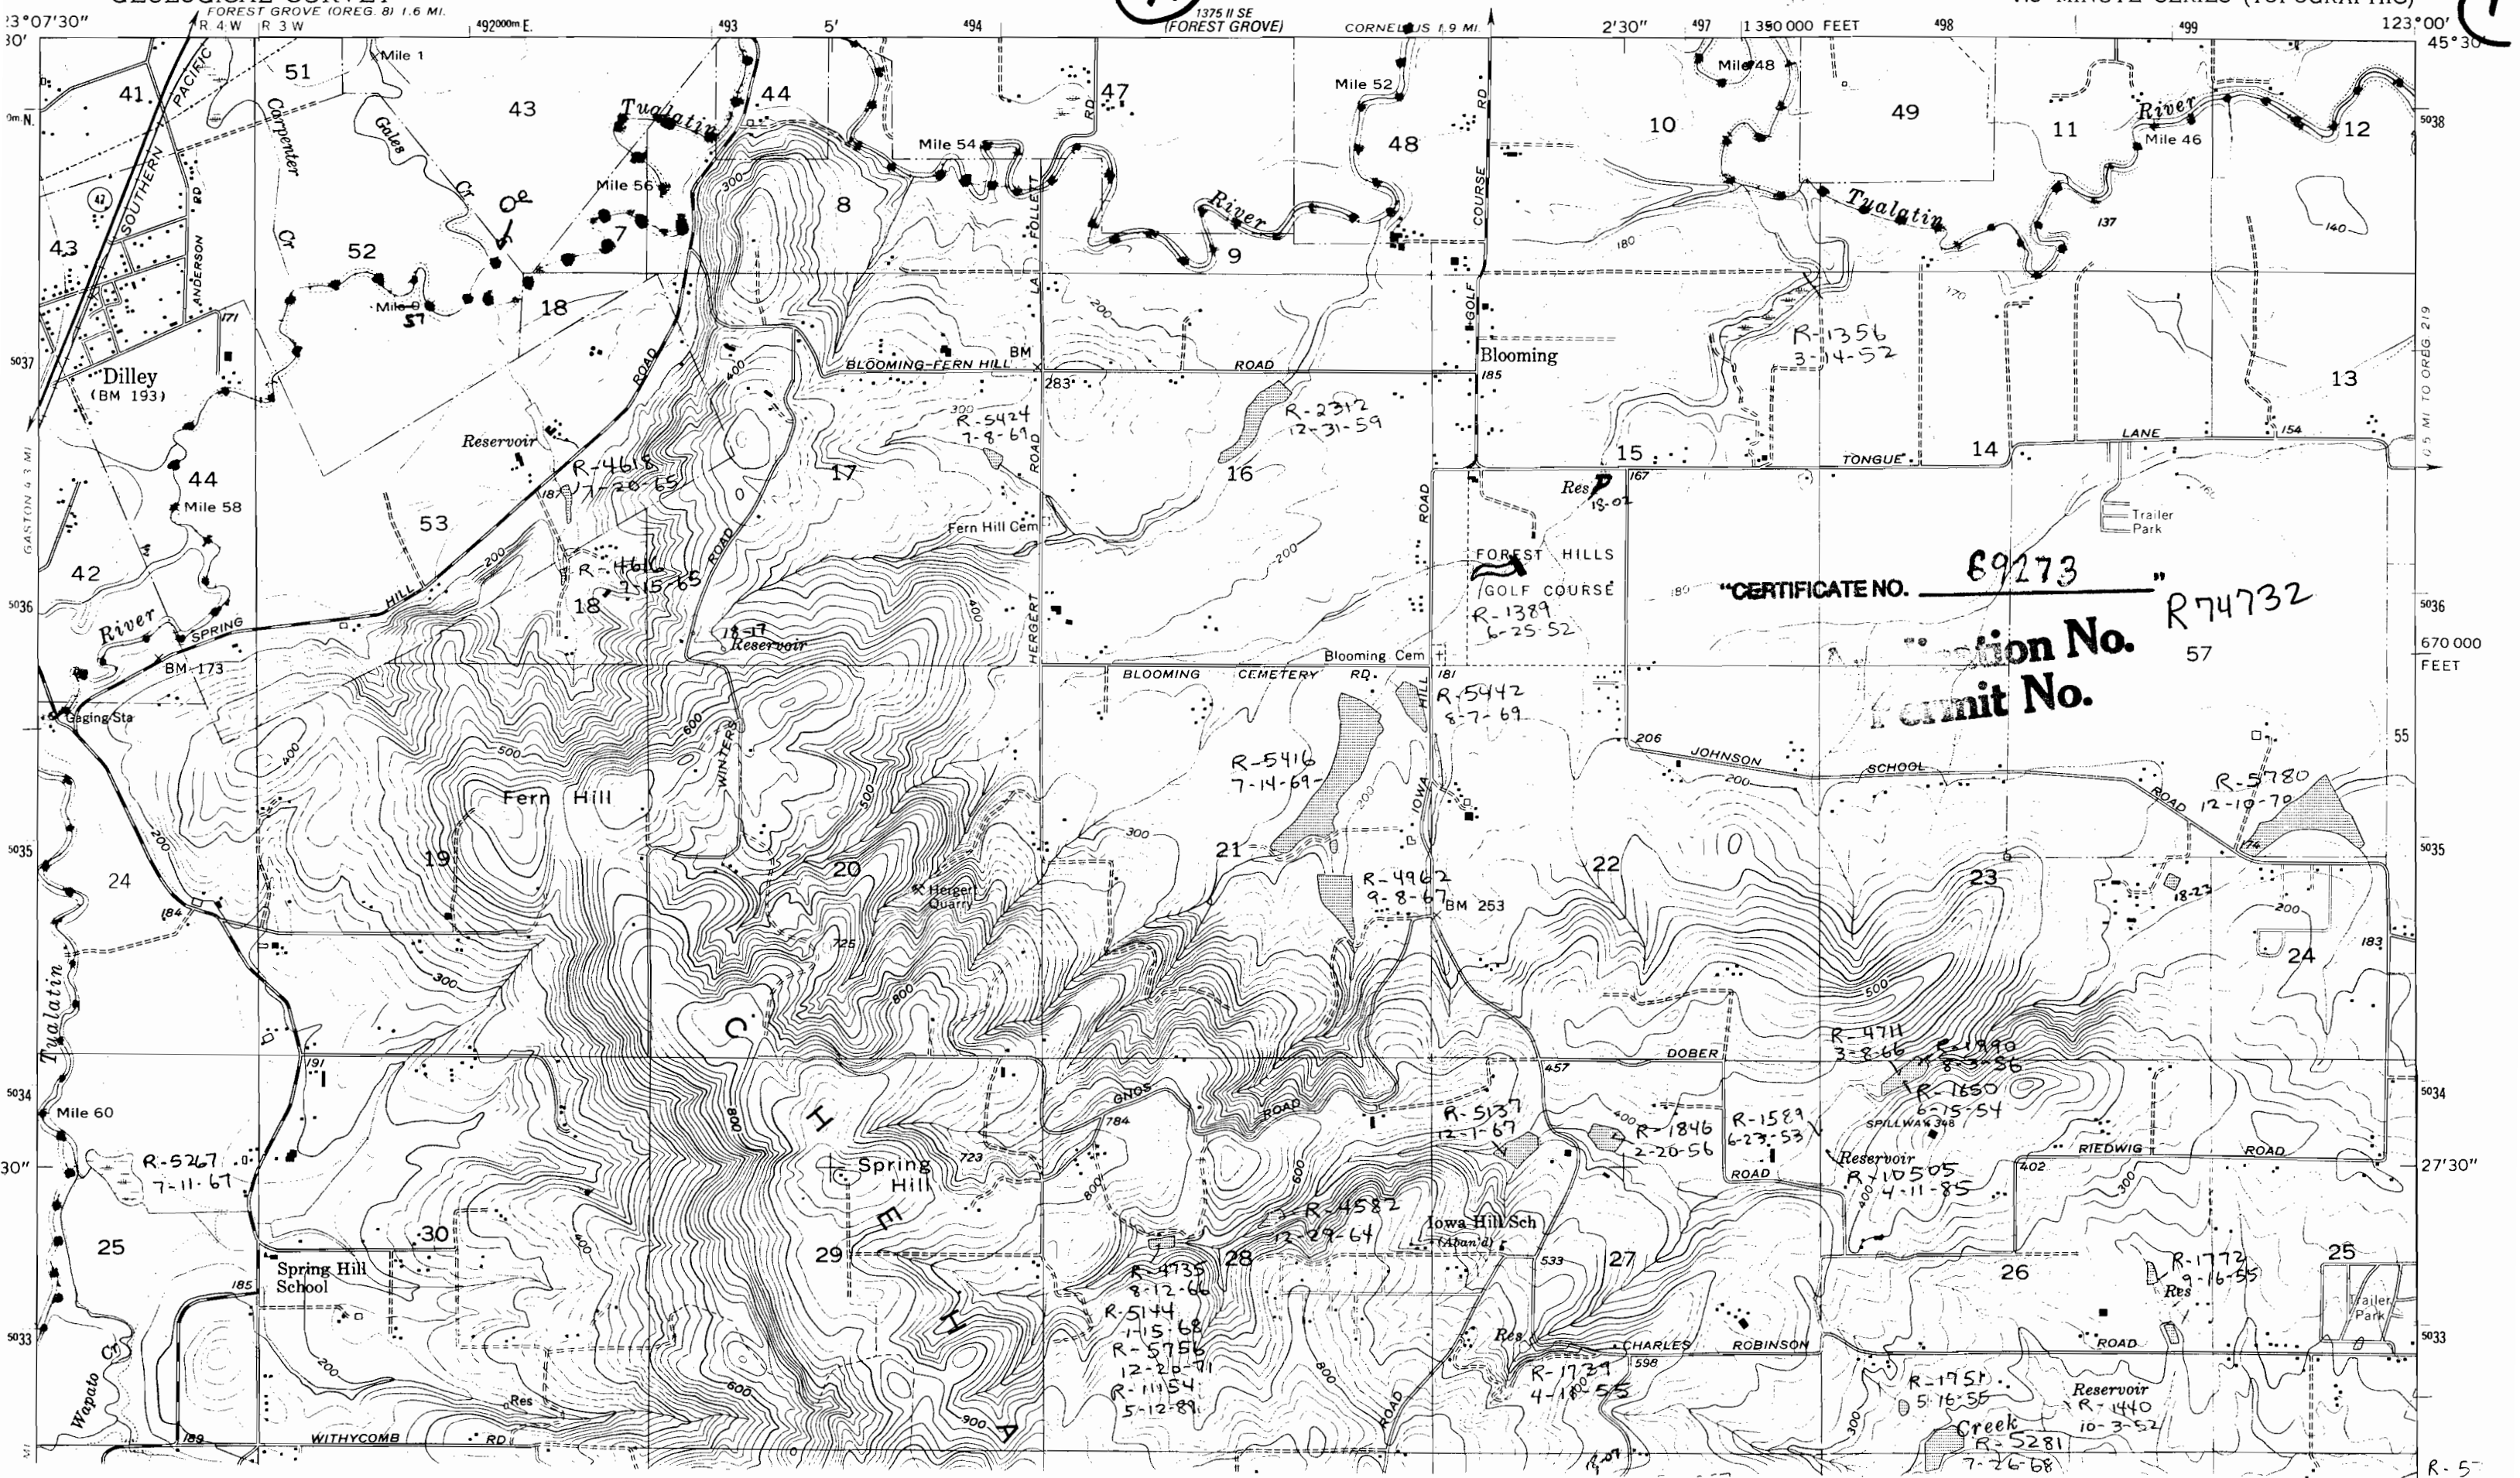

11

1

"CERTIFICATE NO. 69273"  
Permit No. R74732

R-4735 8-12-66  
R-5144 1-15-68  
R-5156 12-20-61  
R-11454 5-12-81

R-471 3-8-66  
R-1650 6-15-54  
R-10505 4-11-85

R-1751 5-16-55  
R-5281 7-26-68

Reservoir R-1440 10-3-52

R-5