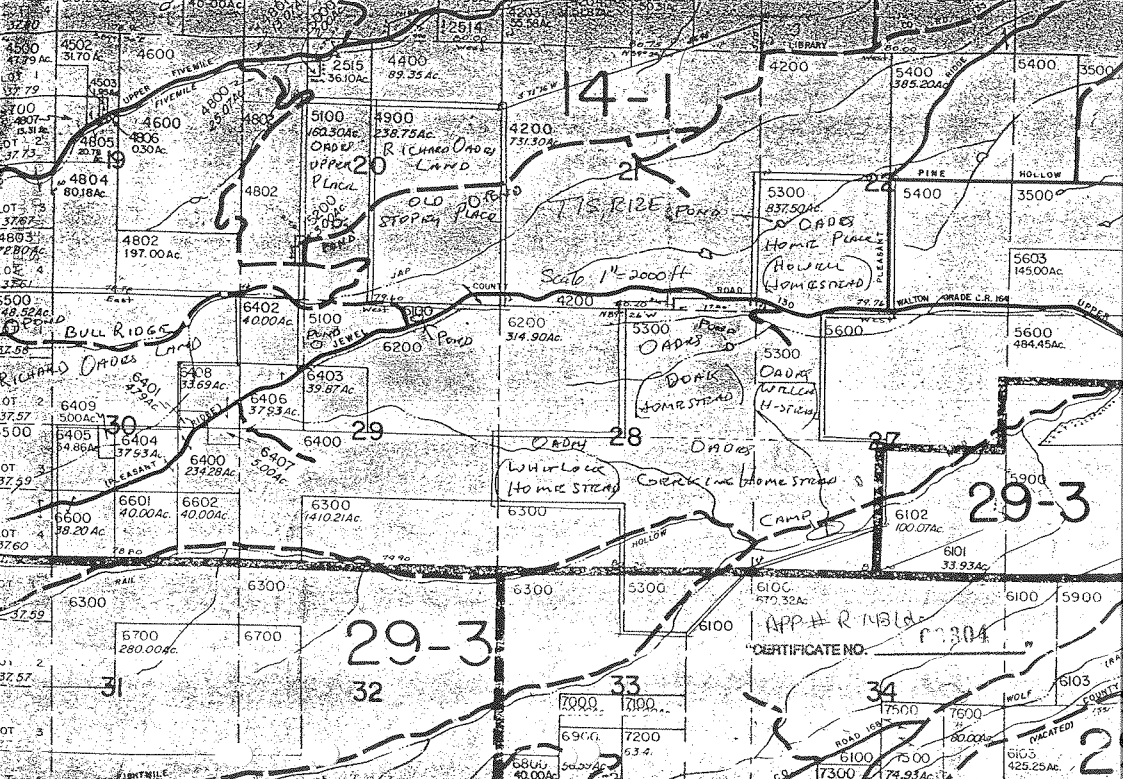
14-1
29-3
29-3
Scale 1"=2000ft
OLD OR STAGE STOPPING PLACE
T.T.S. RIDE (POND)
OADES HOMESTEAD PLACE (HOWELL HOMESTEAD)
BULL RIDGE
RICHARD OADES
OADES
DONK HOMESTEAD
OADES WALLA H-STEAD
OADES WHITLOCK HOMESTEAD
CORRECTING HOMESTEAD
CAMP
APP # R 14 Bld
CERTIFICATE NO. C 304
LIBRARY
PINE HOLLOW
WALTON GRADE C.R. 164
UPPER FIVEMILE
FIVEMILE
WOLF
POND
ROAD
TRAIL
PHEASANT
19
20
21
22
28
29
30
31
32
33
34
4804 80.18Ac.
4802 197.00Ac.
4805 25.73Ac.
4807 15.31Ac.
4503 9.58Ac.
4502 31.70Ac.
4600
4306 0.30Ac.
4803
4802
2515 36.10Ac.
4400 89.35Ac.
12514
5100 160.30Ac. ORDER UPPER PLACE
4900 238.75Ac. RICHARD OADES LAND
4200 731.30Ac.
5300 837.50Ac.
5400 385.20Ac.
5400
3500
5603 145.00Ac.
5600 484.45Ac.
5600
6402 40.00Ac.
5100 POND OF JEWEL
6200 314.90Ac.
6200
6408 33.69Ac.
6401 47.94Ac.
6403 39.87Ac.
6406 37.93Ac.
6409 5.00Ac.
6405 54.86Ac.
6404 37.93Ac.
6400 234.28Ac.
6407 3.00Ac.
6400
6601 40.00Ac.
6602 40.00Ac.
6600 38.20Ac.
6300 141.0.21Ac.
6300
6102 100.07Ac.
6101 33.93Ac.
5900
6100
6300
6700 280.00Ac.
6700
6300
6100
6100 670.32Ac.
6103
7000
7000
6900
7200 63.4
6800 40.00Ac.
7500
7600 80.00Ac.
6100
7300
74.93Ac.
6103 425.25Ac.