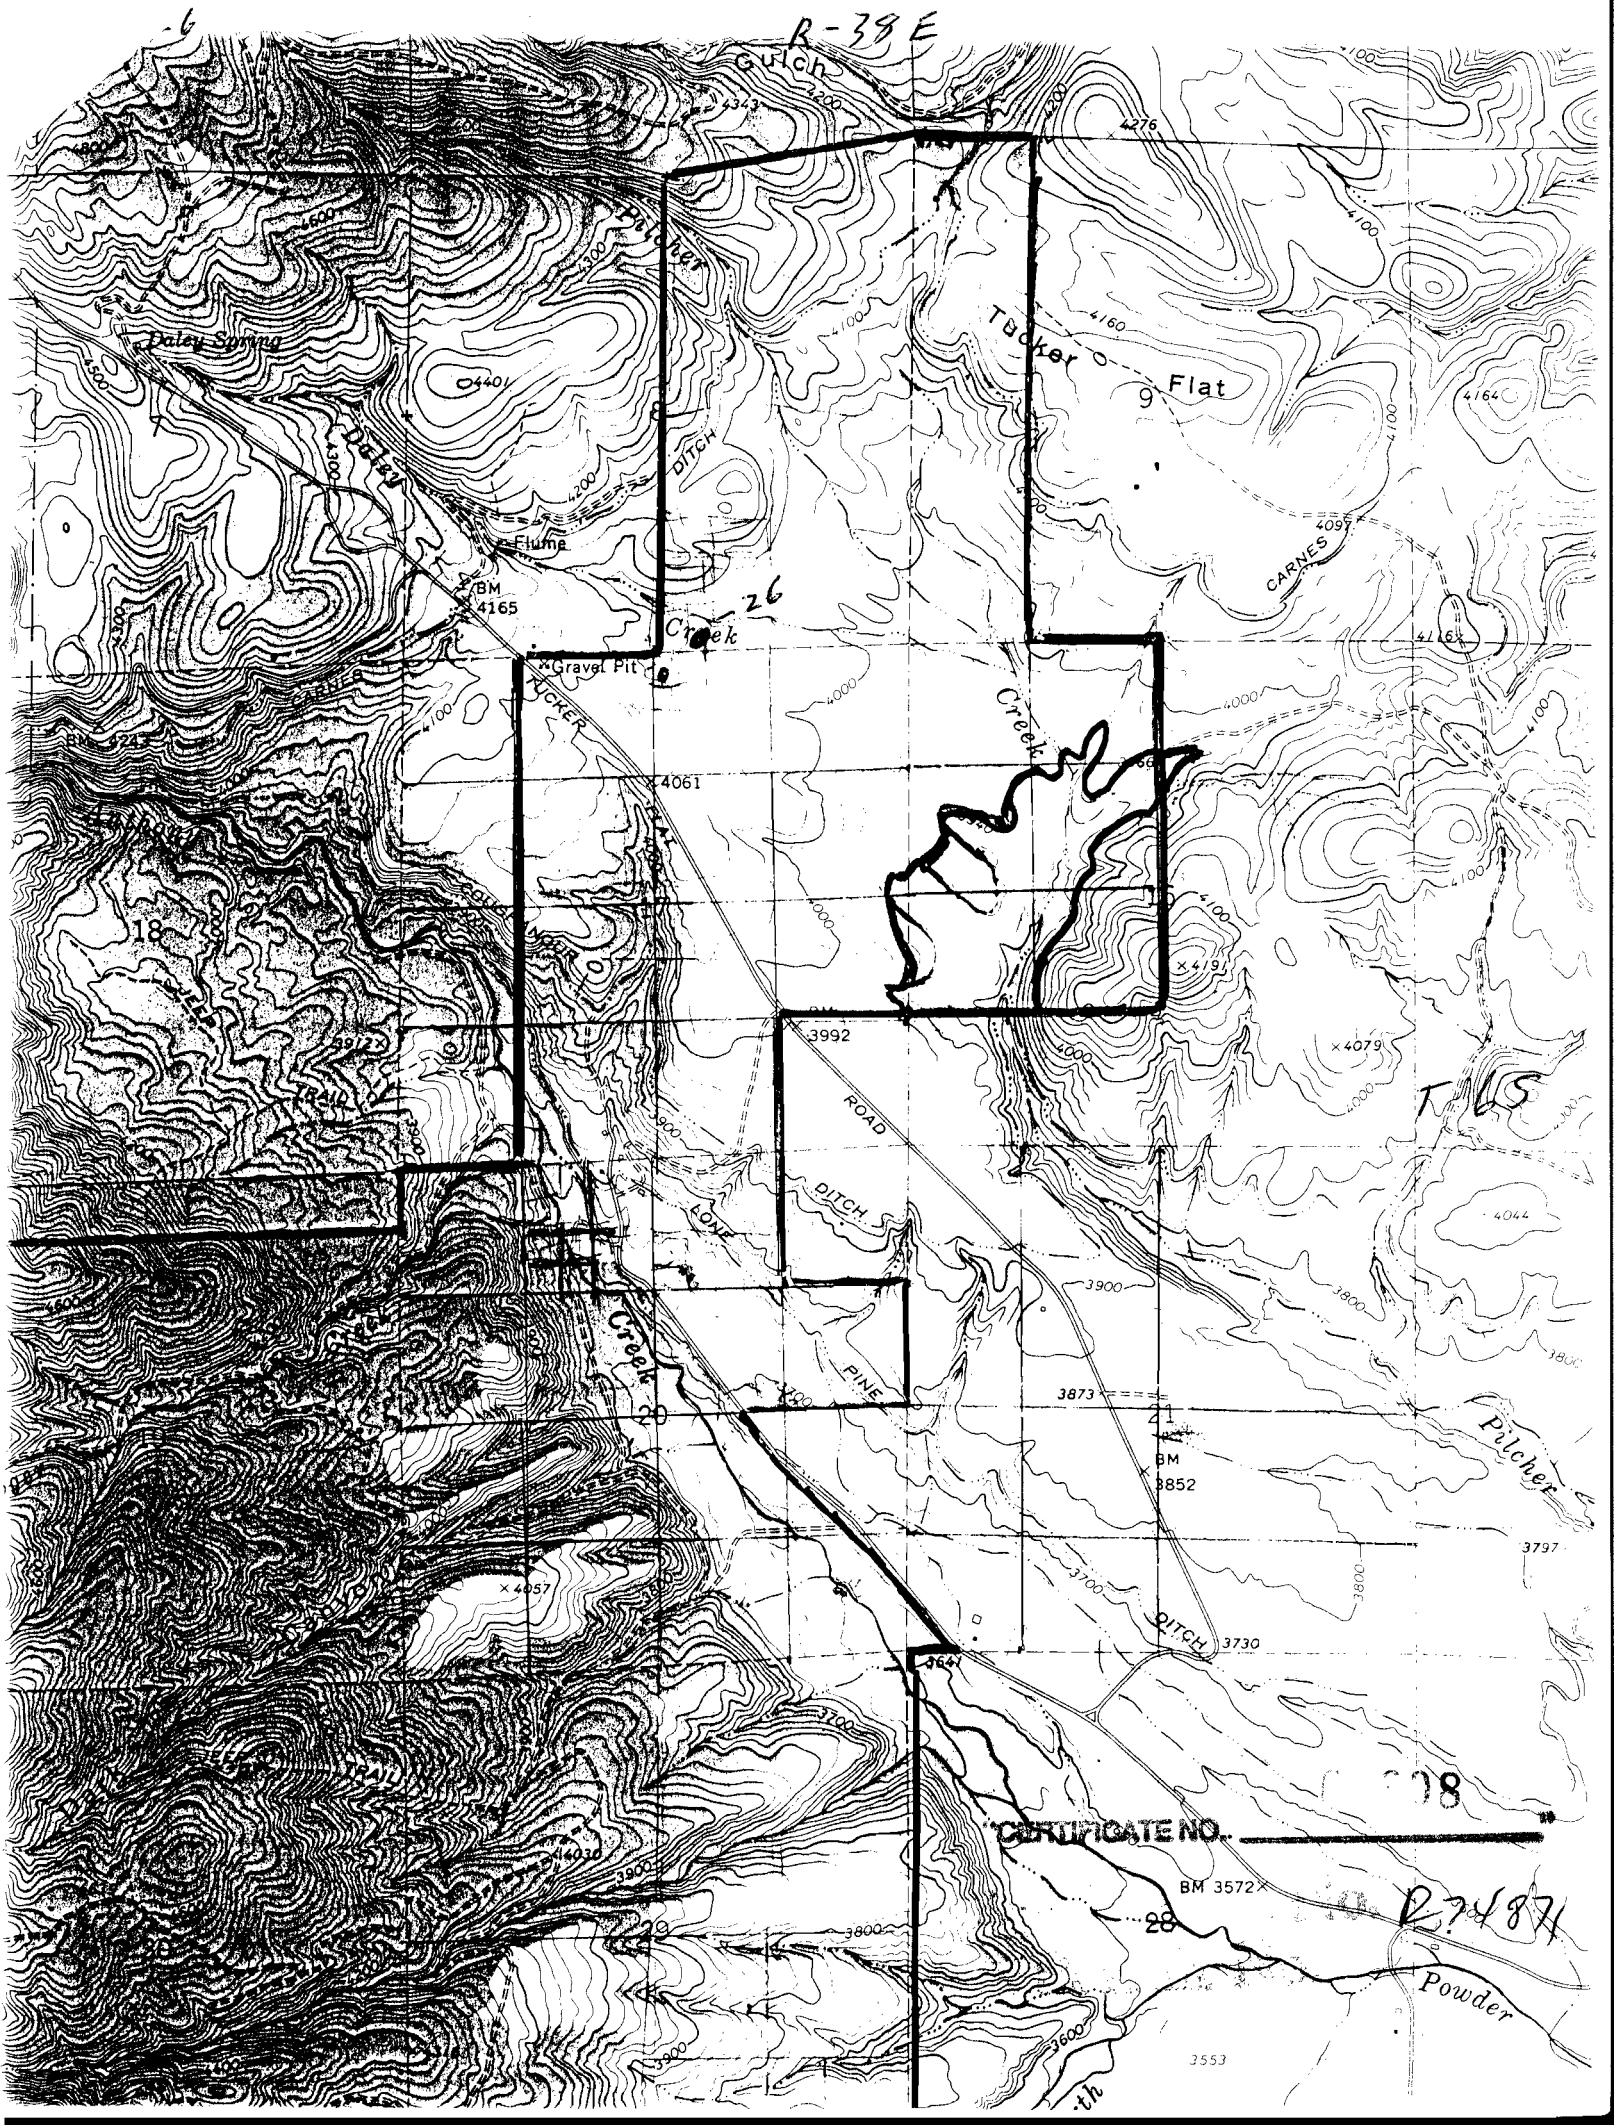
R-38E
Gulch
Pilcher
Daley Spring
Daley
Tucker
Flat
Flume
BM 4165
Creek
Gravel Pit
TUCKER
CARNES
DITCH
4061
3992
ROAD
DITCH
LONE
PINE
Creek
Pilcher
BM 3852
DITCH
3730
BM 3572
Powder
CERTIFICATE NO.
R74871

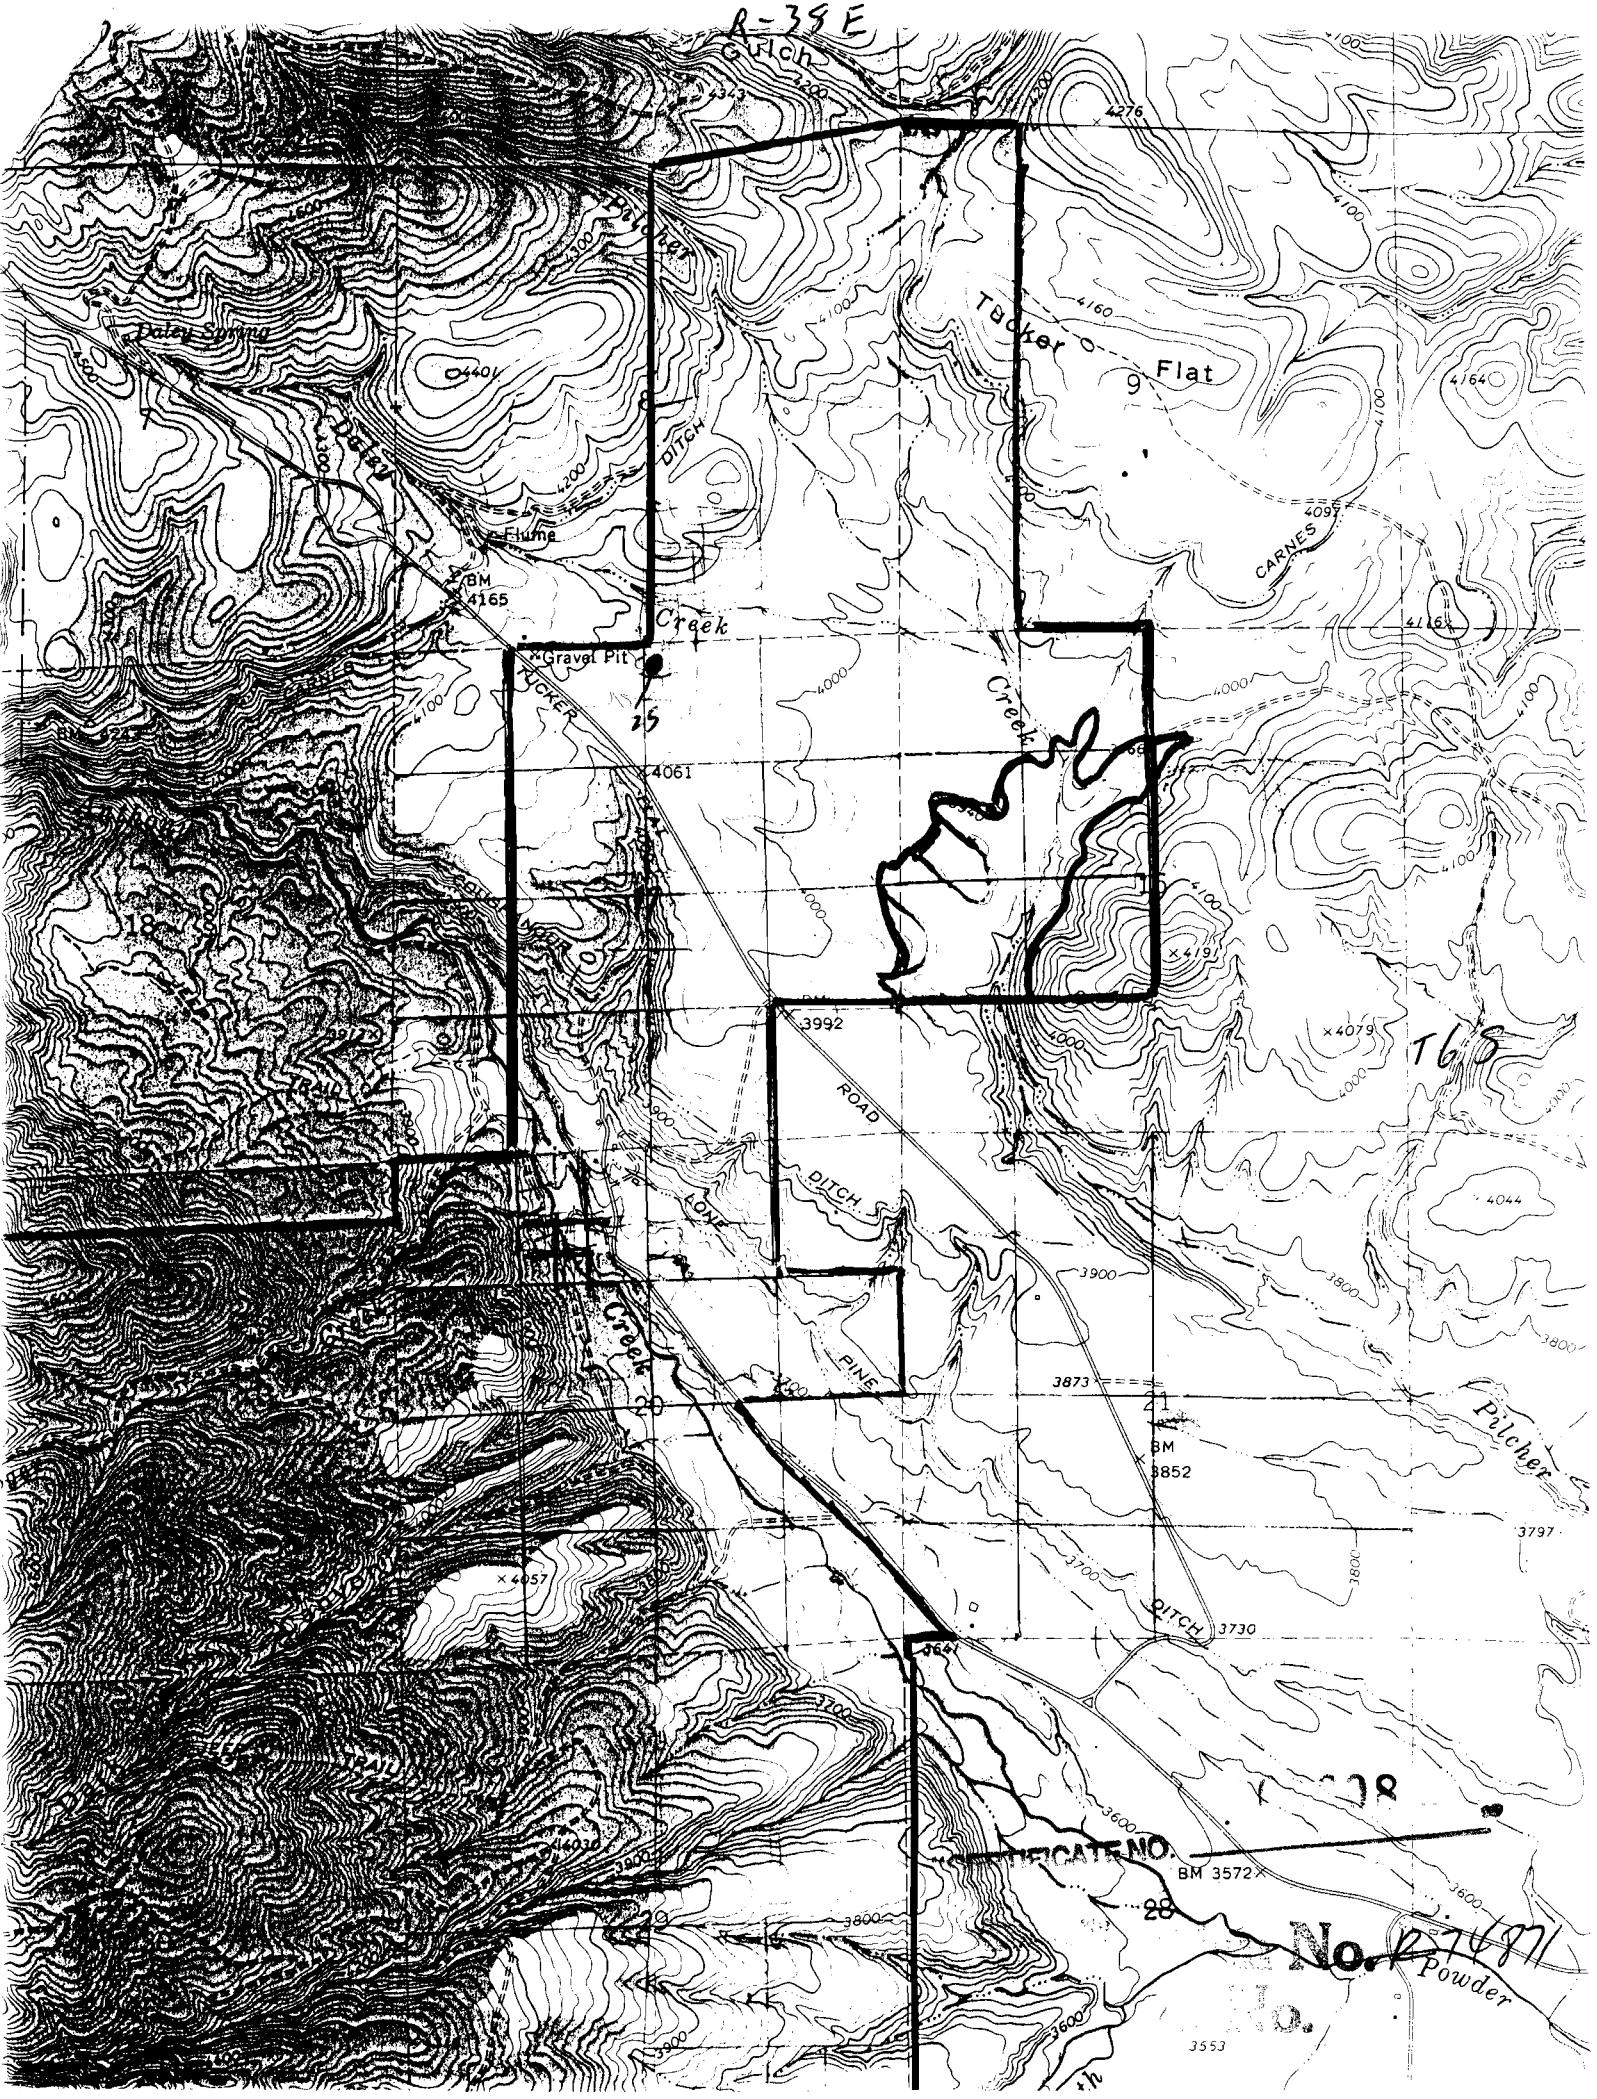
R-38E
Gulch
Pilcher
Daley Spring
Daley
Tucker
Flat
9
DITCH
Flume
BM
4165
Creek
Gravel Pit
TUCKER
25
4061
CARNES
Creek
18
3992
ROAD
DITCH
LONE
PINE
Creek
20
3873
21
BM
3852
Pilcher
3797
DITCH
3730
3641
BM 3572
28
Powder
3553
T6S
No. R74871