

Sec.

33

Tp. 7 S.

R. 19 E


and

Sec. 4

T. 8 S.

R. 19 E

P- 8072
7369

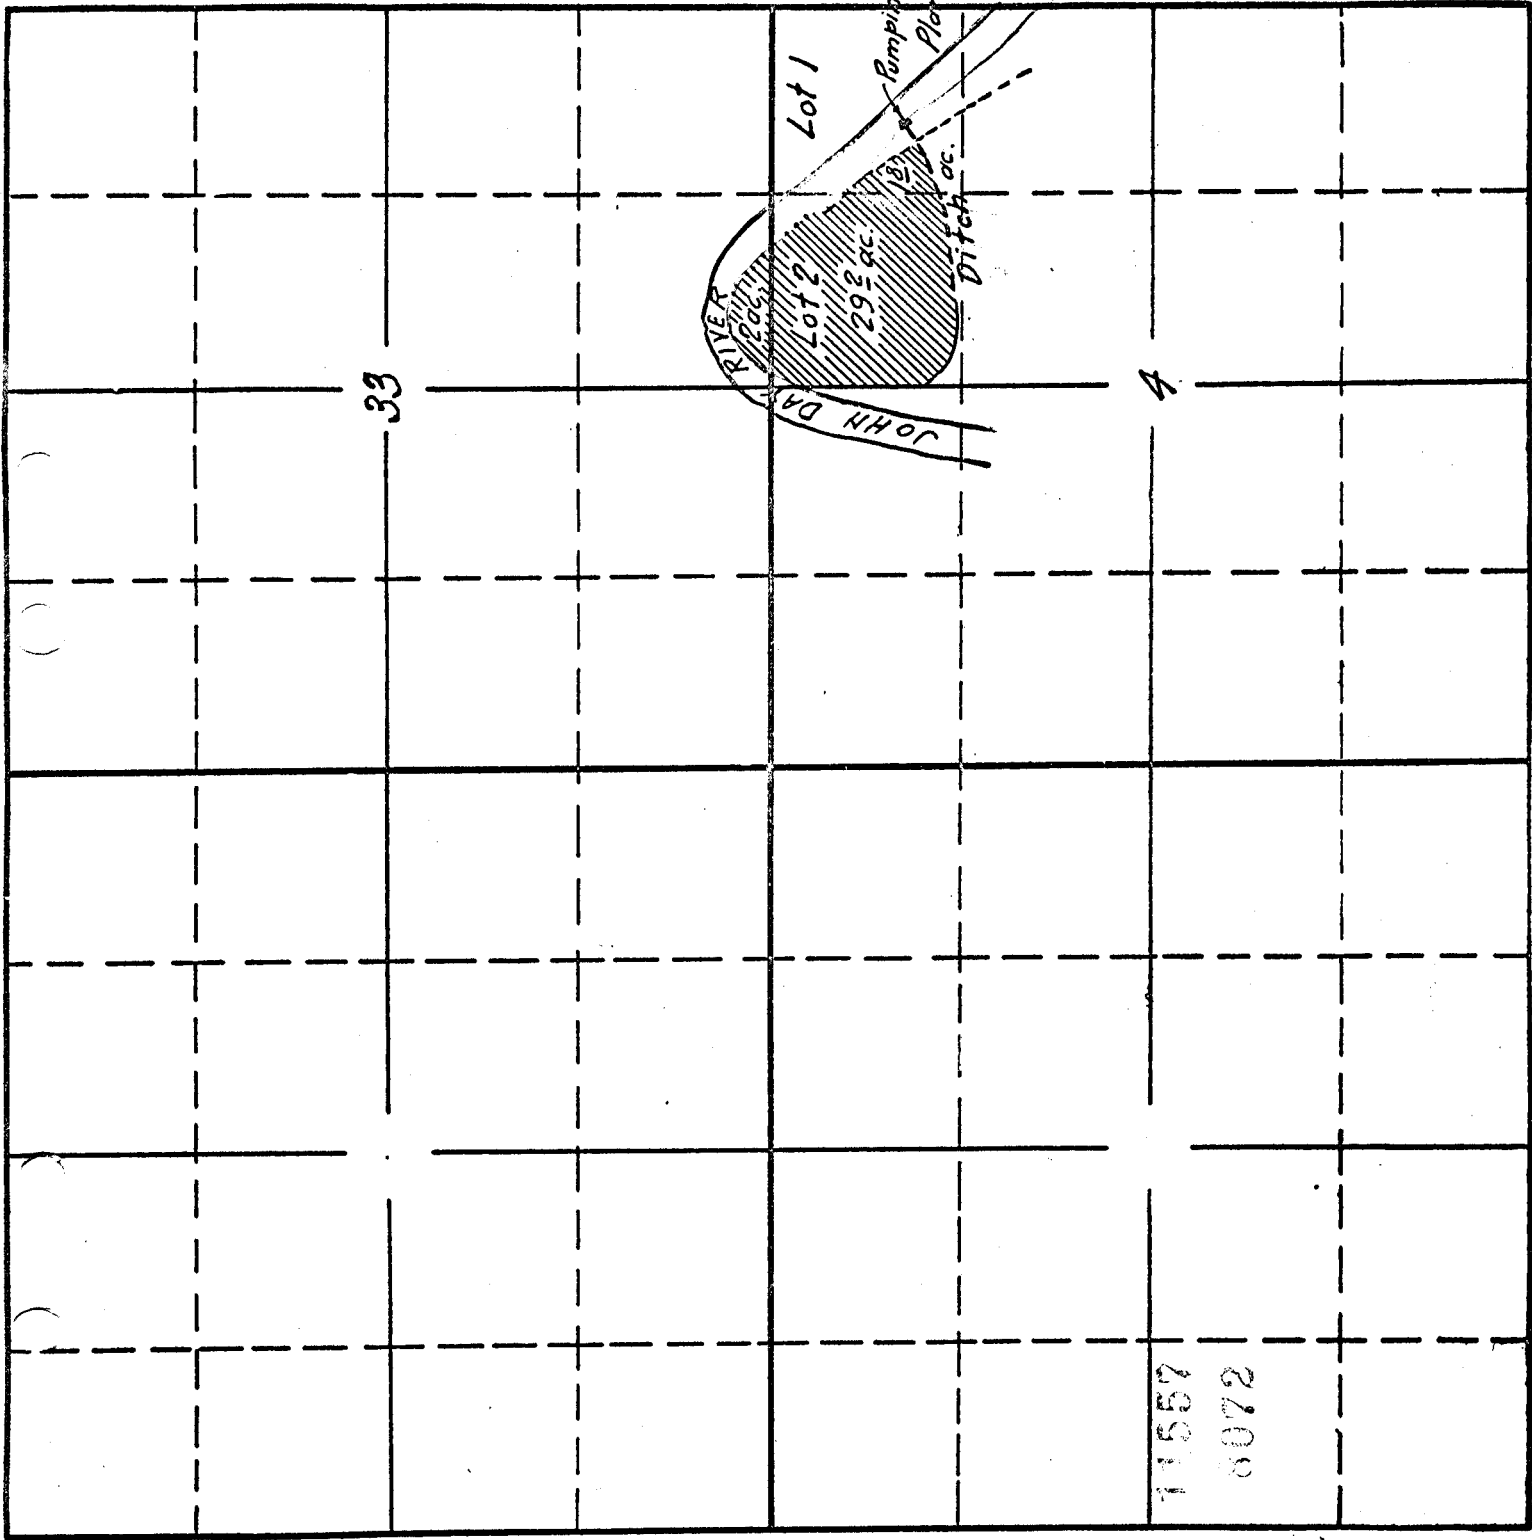

11557

8072

Application No.
Permit No.