

T. I S. R. 4 W. W. M.

RECEIVED


NOV 18 1994

WATER RESOURCES DEPT.  
SALEM, OREGON

"CERTIFICATE NO. 69360"

Application No. R-74943

Permit No.

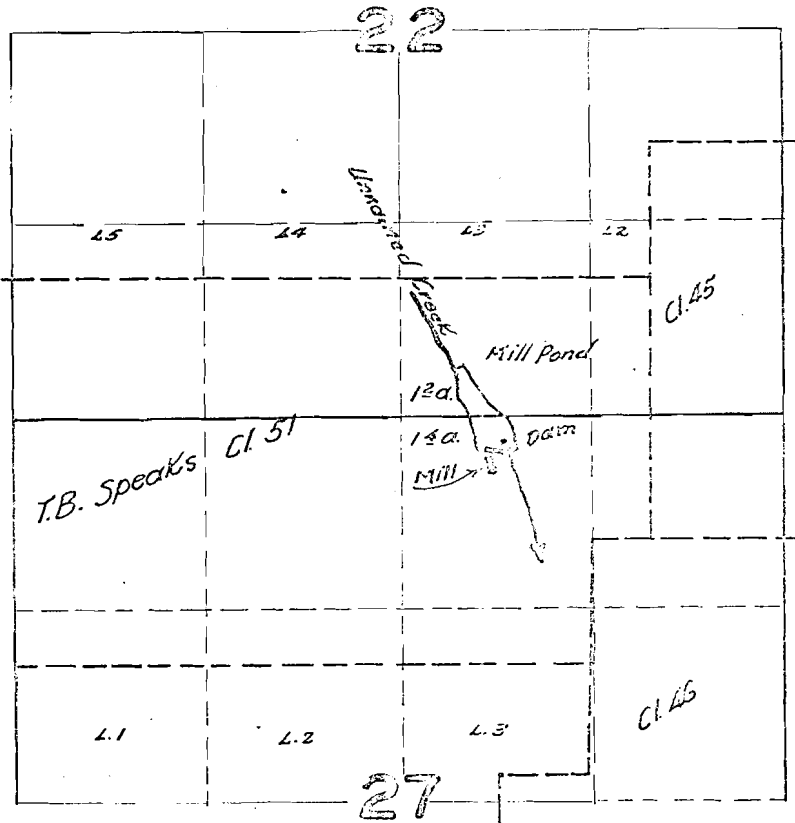

FINAL PROOF SURVEY  
UNDER

Application No. 22934 Permit No. 15070

IN NAME OF

Carl Olson

Surveyed Apr. 8 1953, by H. L. Coffman