

- map of project

SURVEY IN SW 1/4 OF SECTION 21 T3NR3W W.M.
FOR A. E. COOK

14 MAY 1956

SCALE 1 IN = 200 FT

RECEIVED

JUL 28 1977


WATER RESOURCES DEPT.
SALEM, OREGON

R75049

REGISTERED
OREGON
LAND SURVEYOR

A. Robert Sorbel

A. ROBERT SORBEL
314

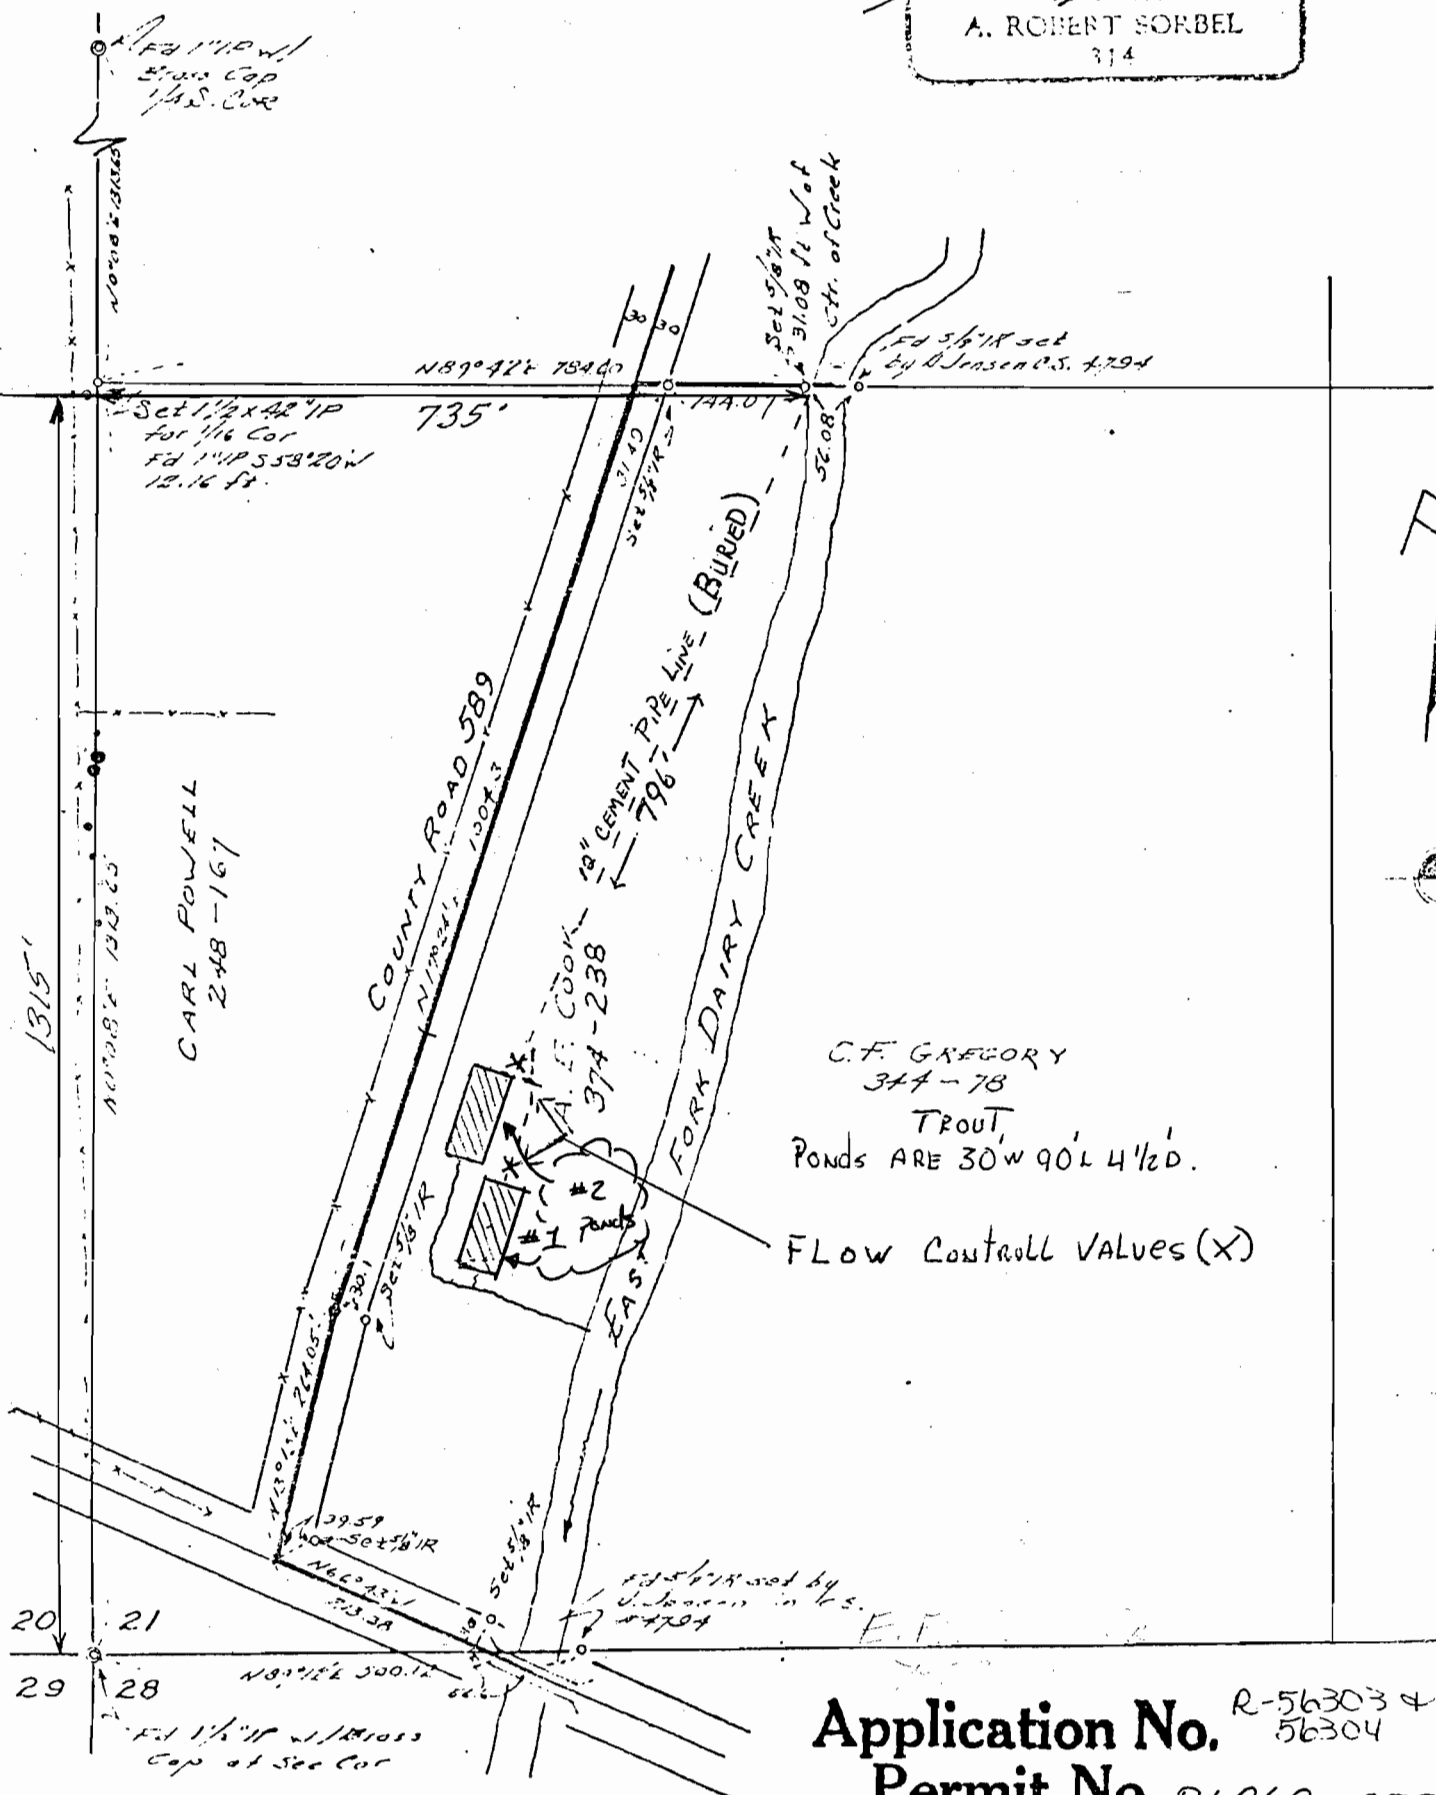

Application No. R-56303 & 56304
Permit No. R6760, 42622
69380

"CERTIFICATE NO. _____"