


Sec. _____

8

Tp. 7S.

R. 19E.

P-8073
7370

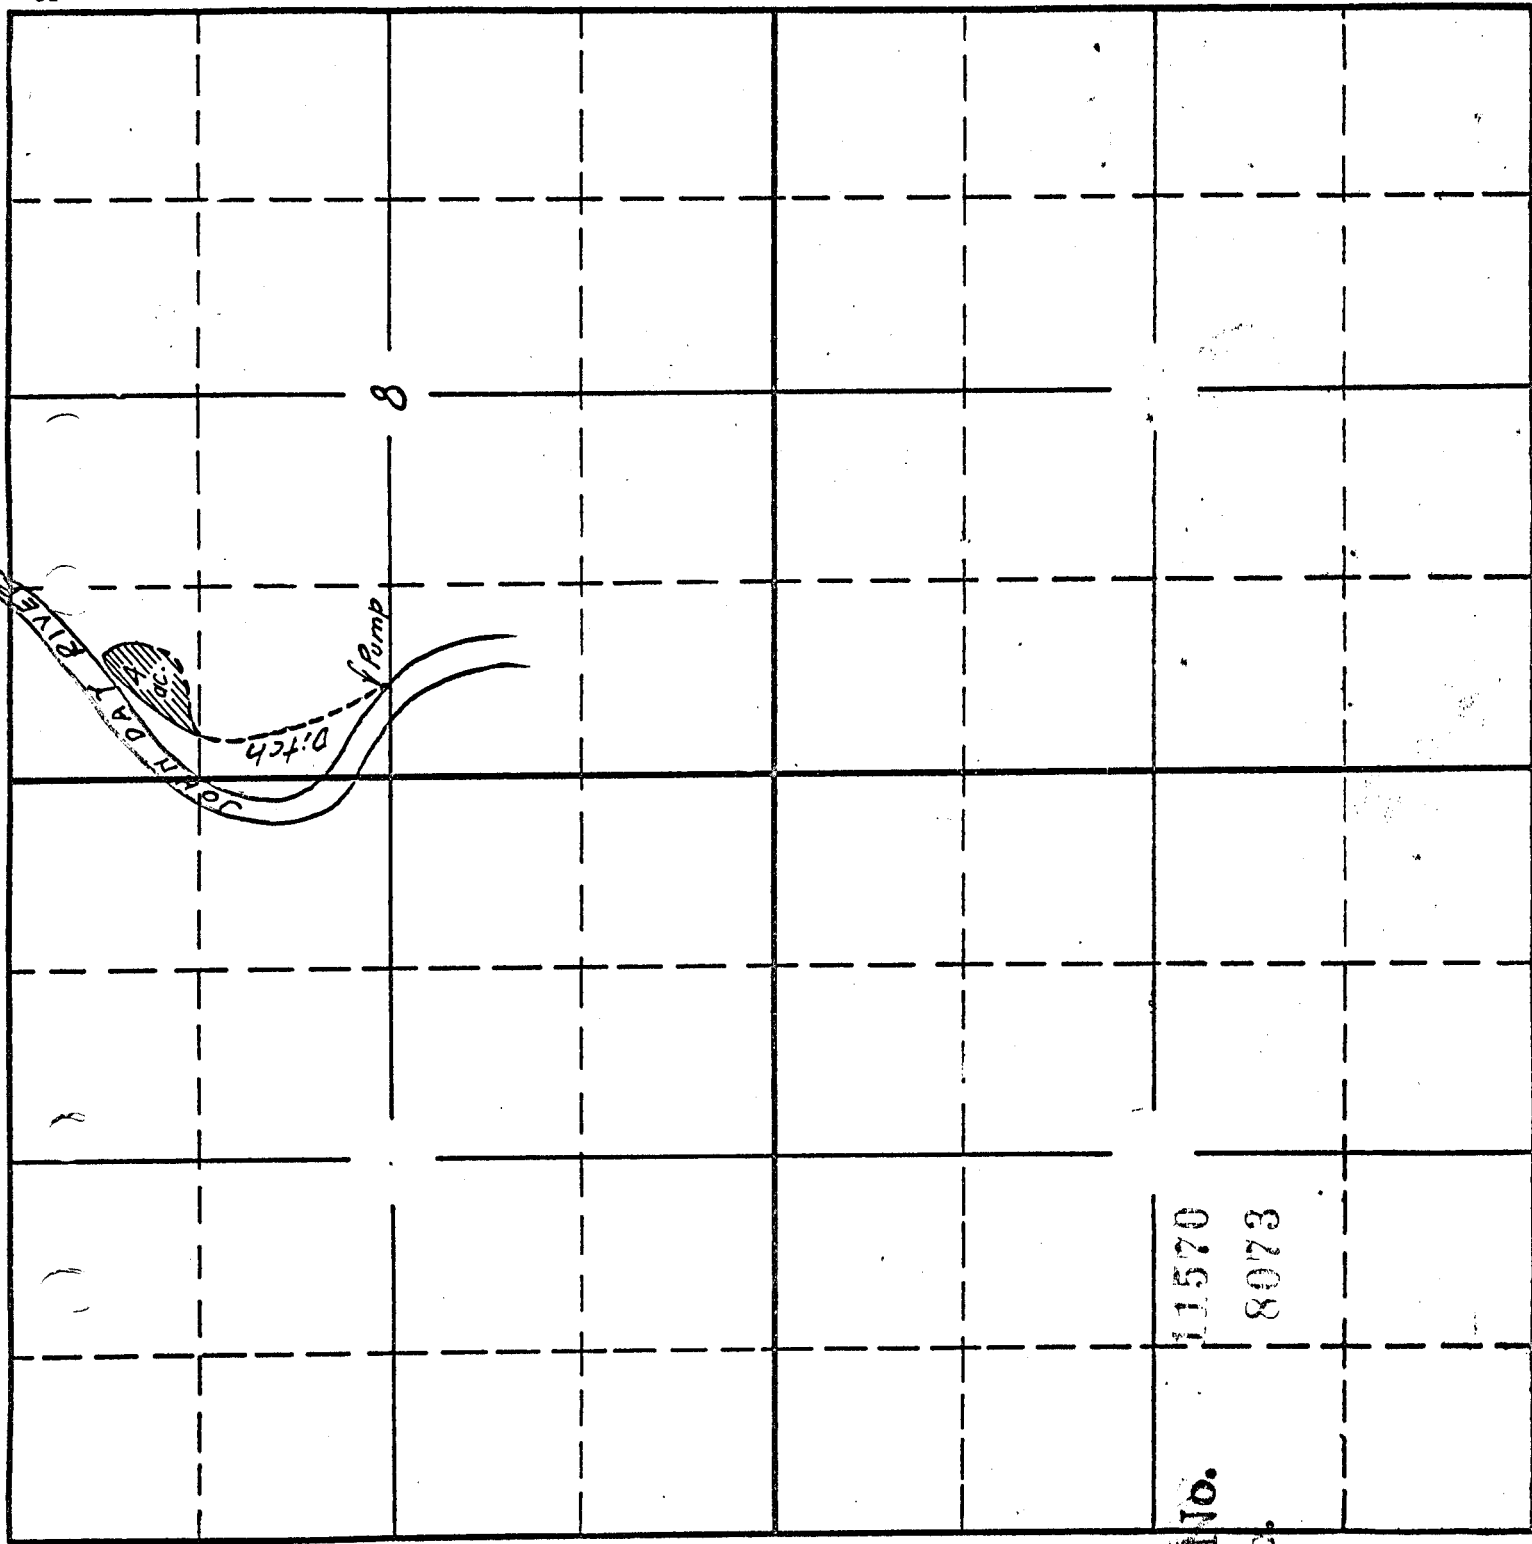

Application No. 11570
 Permit No. 8073

Small illegible handwritten mark or signature.