

**LAURELWOOD, OR**  
**1956**

R 15134

69400

16 Bald Peak  
MAM 1629

BALD PEAK  
STATE PARK

Microwave  
Sta

YCOMB

DIXON 31

SALLE ROAD

Hill Cem

Hill School

WASHINGTON CO  
YAMHILL CO

18

BM 183

Iowa Hill

32

3

Laurelwood

49

Laurelwood Academy

R-1199  
11-10-30

48

56

57

16


47

PEAK  
BM 1114

BALD

Microwave  
Sta

511-3TL770

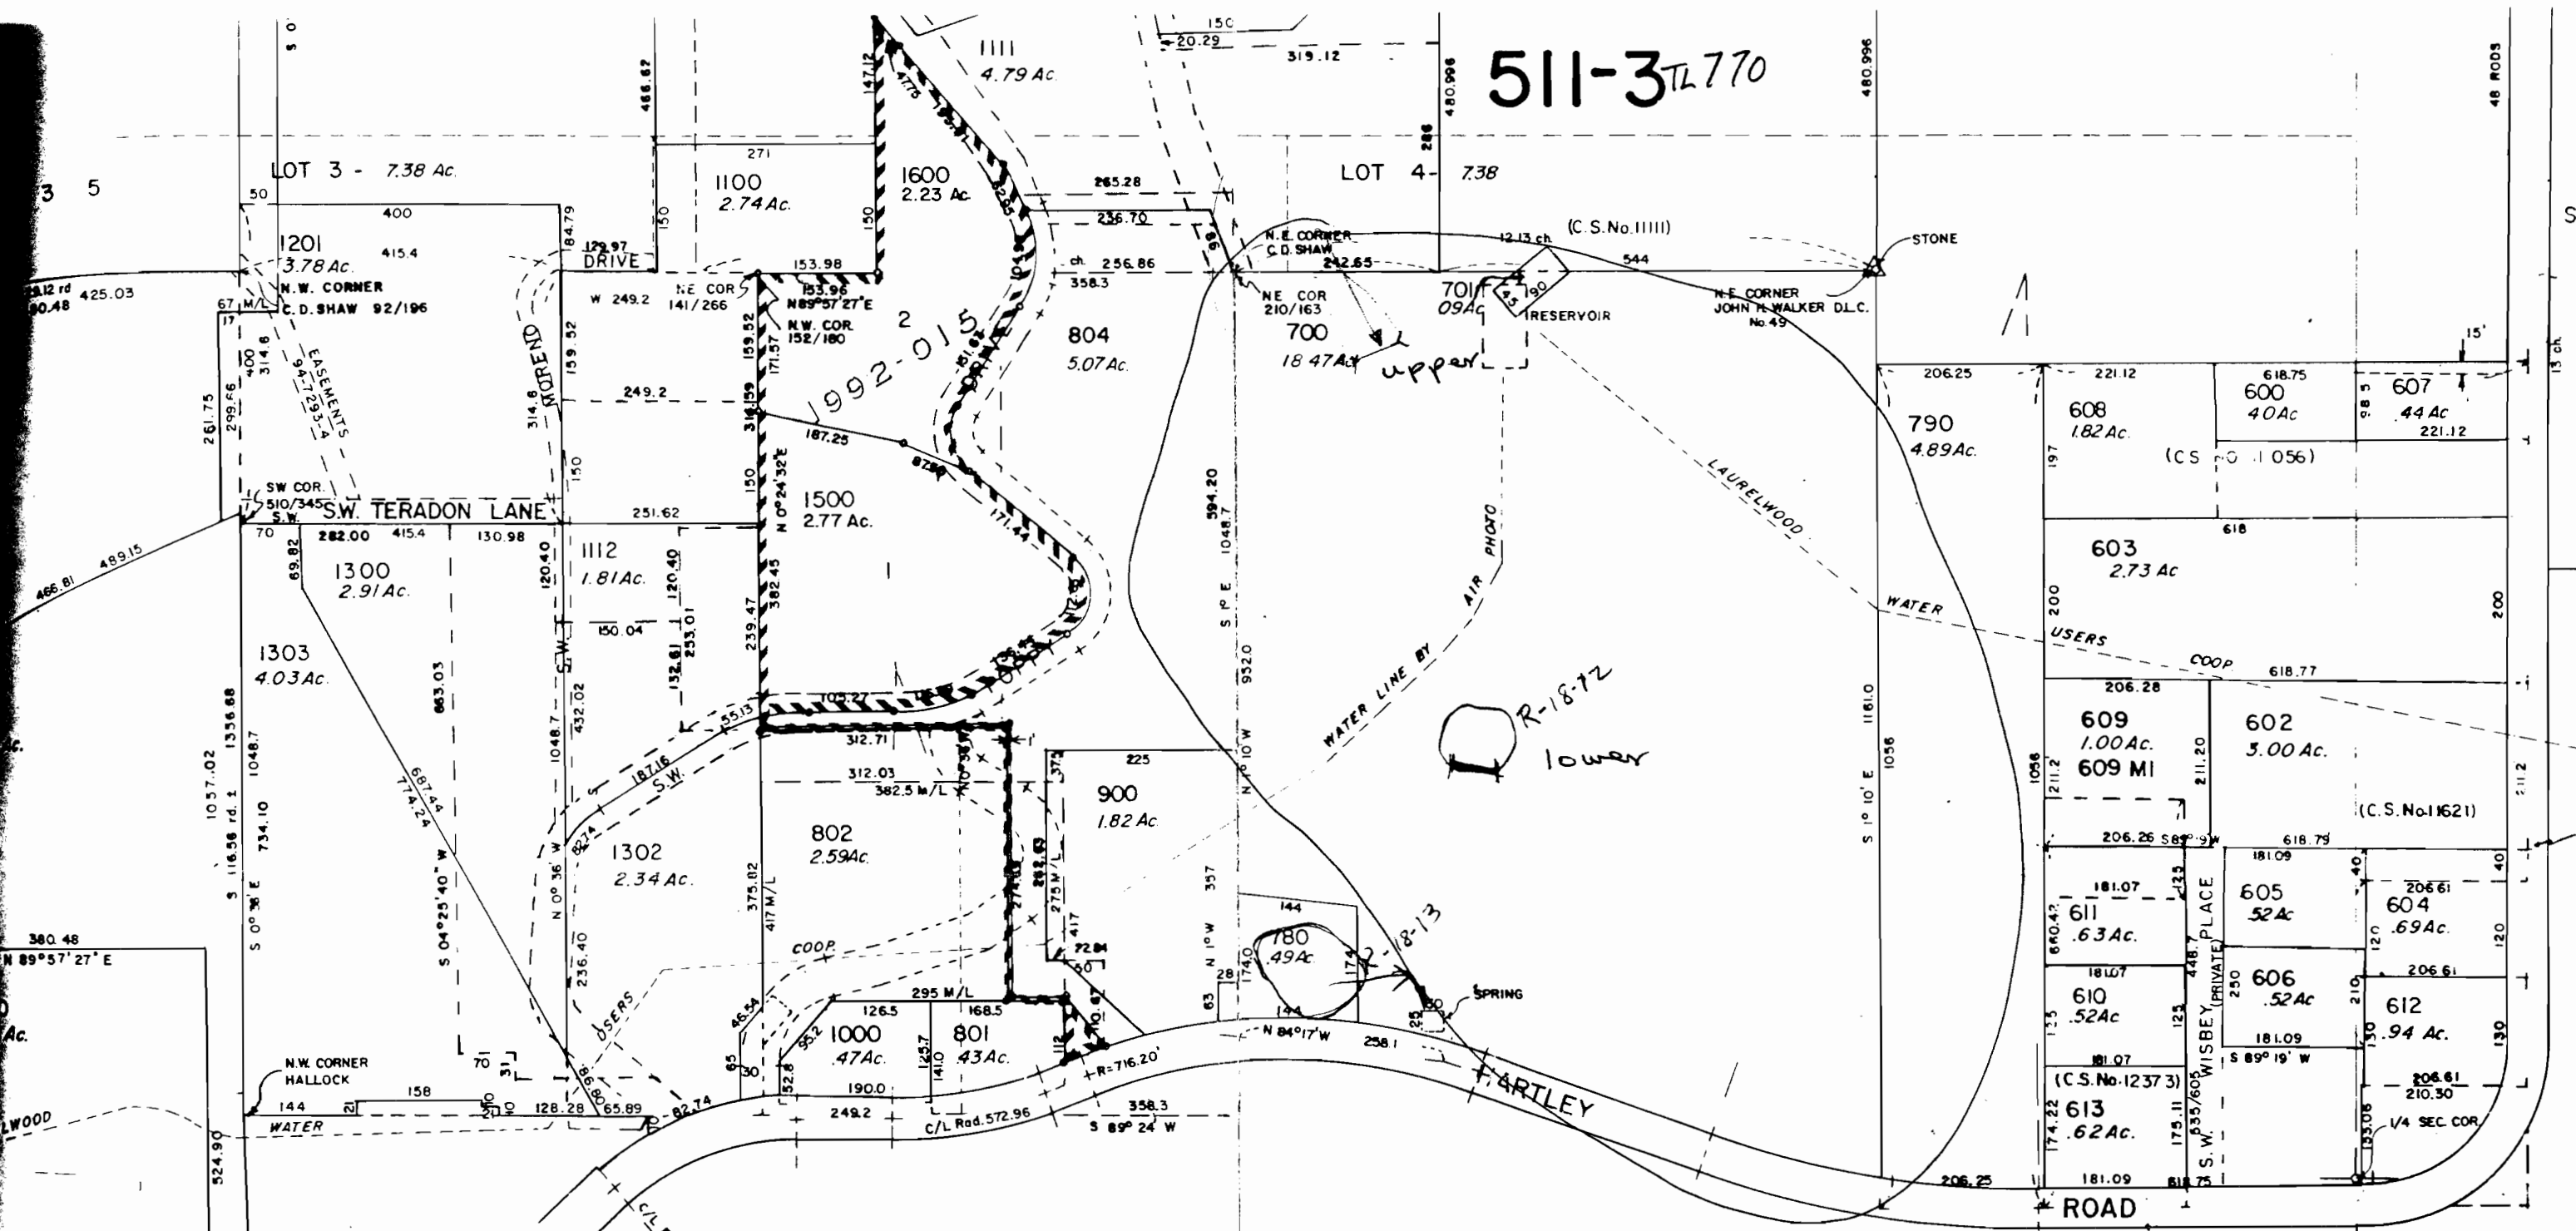

SEE MAP 2S 3 5DB

SEE MAP 2S 3 5

SEE MAP 2S 3 4C

FOR ASSESSMENT PURPOSES ONLY  
DO NOT RELY ON FOR ANY OTHER USE

"CERTIFICATE NO. 69400"

R75134

2S 3 5A

2S