


(BLUEJOINT LAKE WEST)

HART MOUNTAIN NATIONAL ANTELOPE REFUGE

HB2153 POND LOCATIONS



UNITED STATES
DEPARTMENT OF THE INTERIOR
GEOLOGICAL SURVEY

FLOOK LAKE QUADRANGLE
OREGON—LAKE CO.
7.5 MINUTE SERIES (TOPOGRAPHIC)

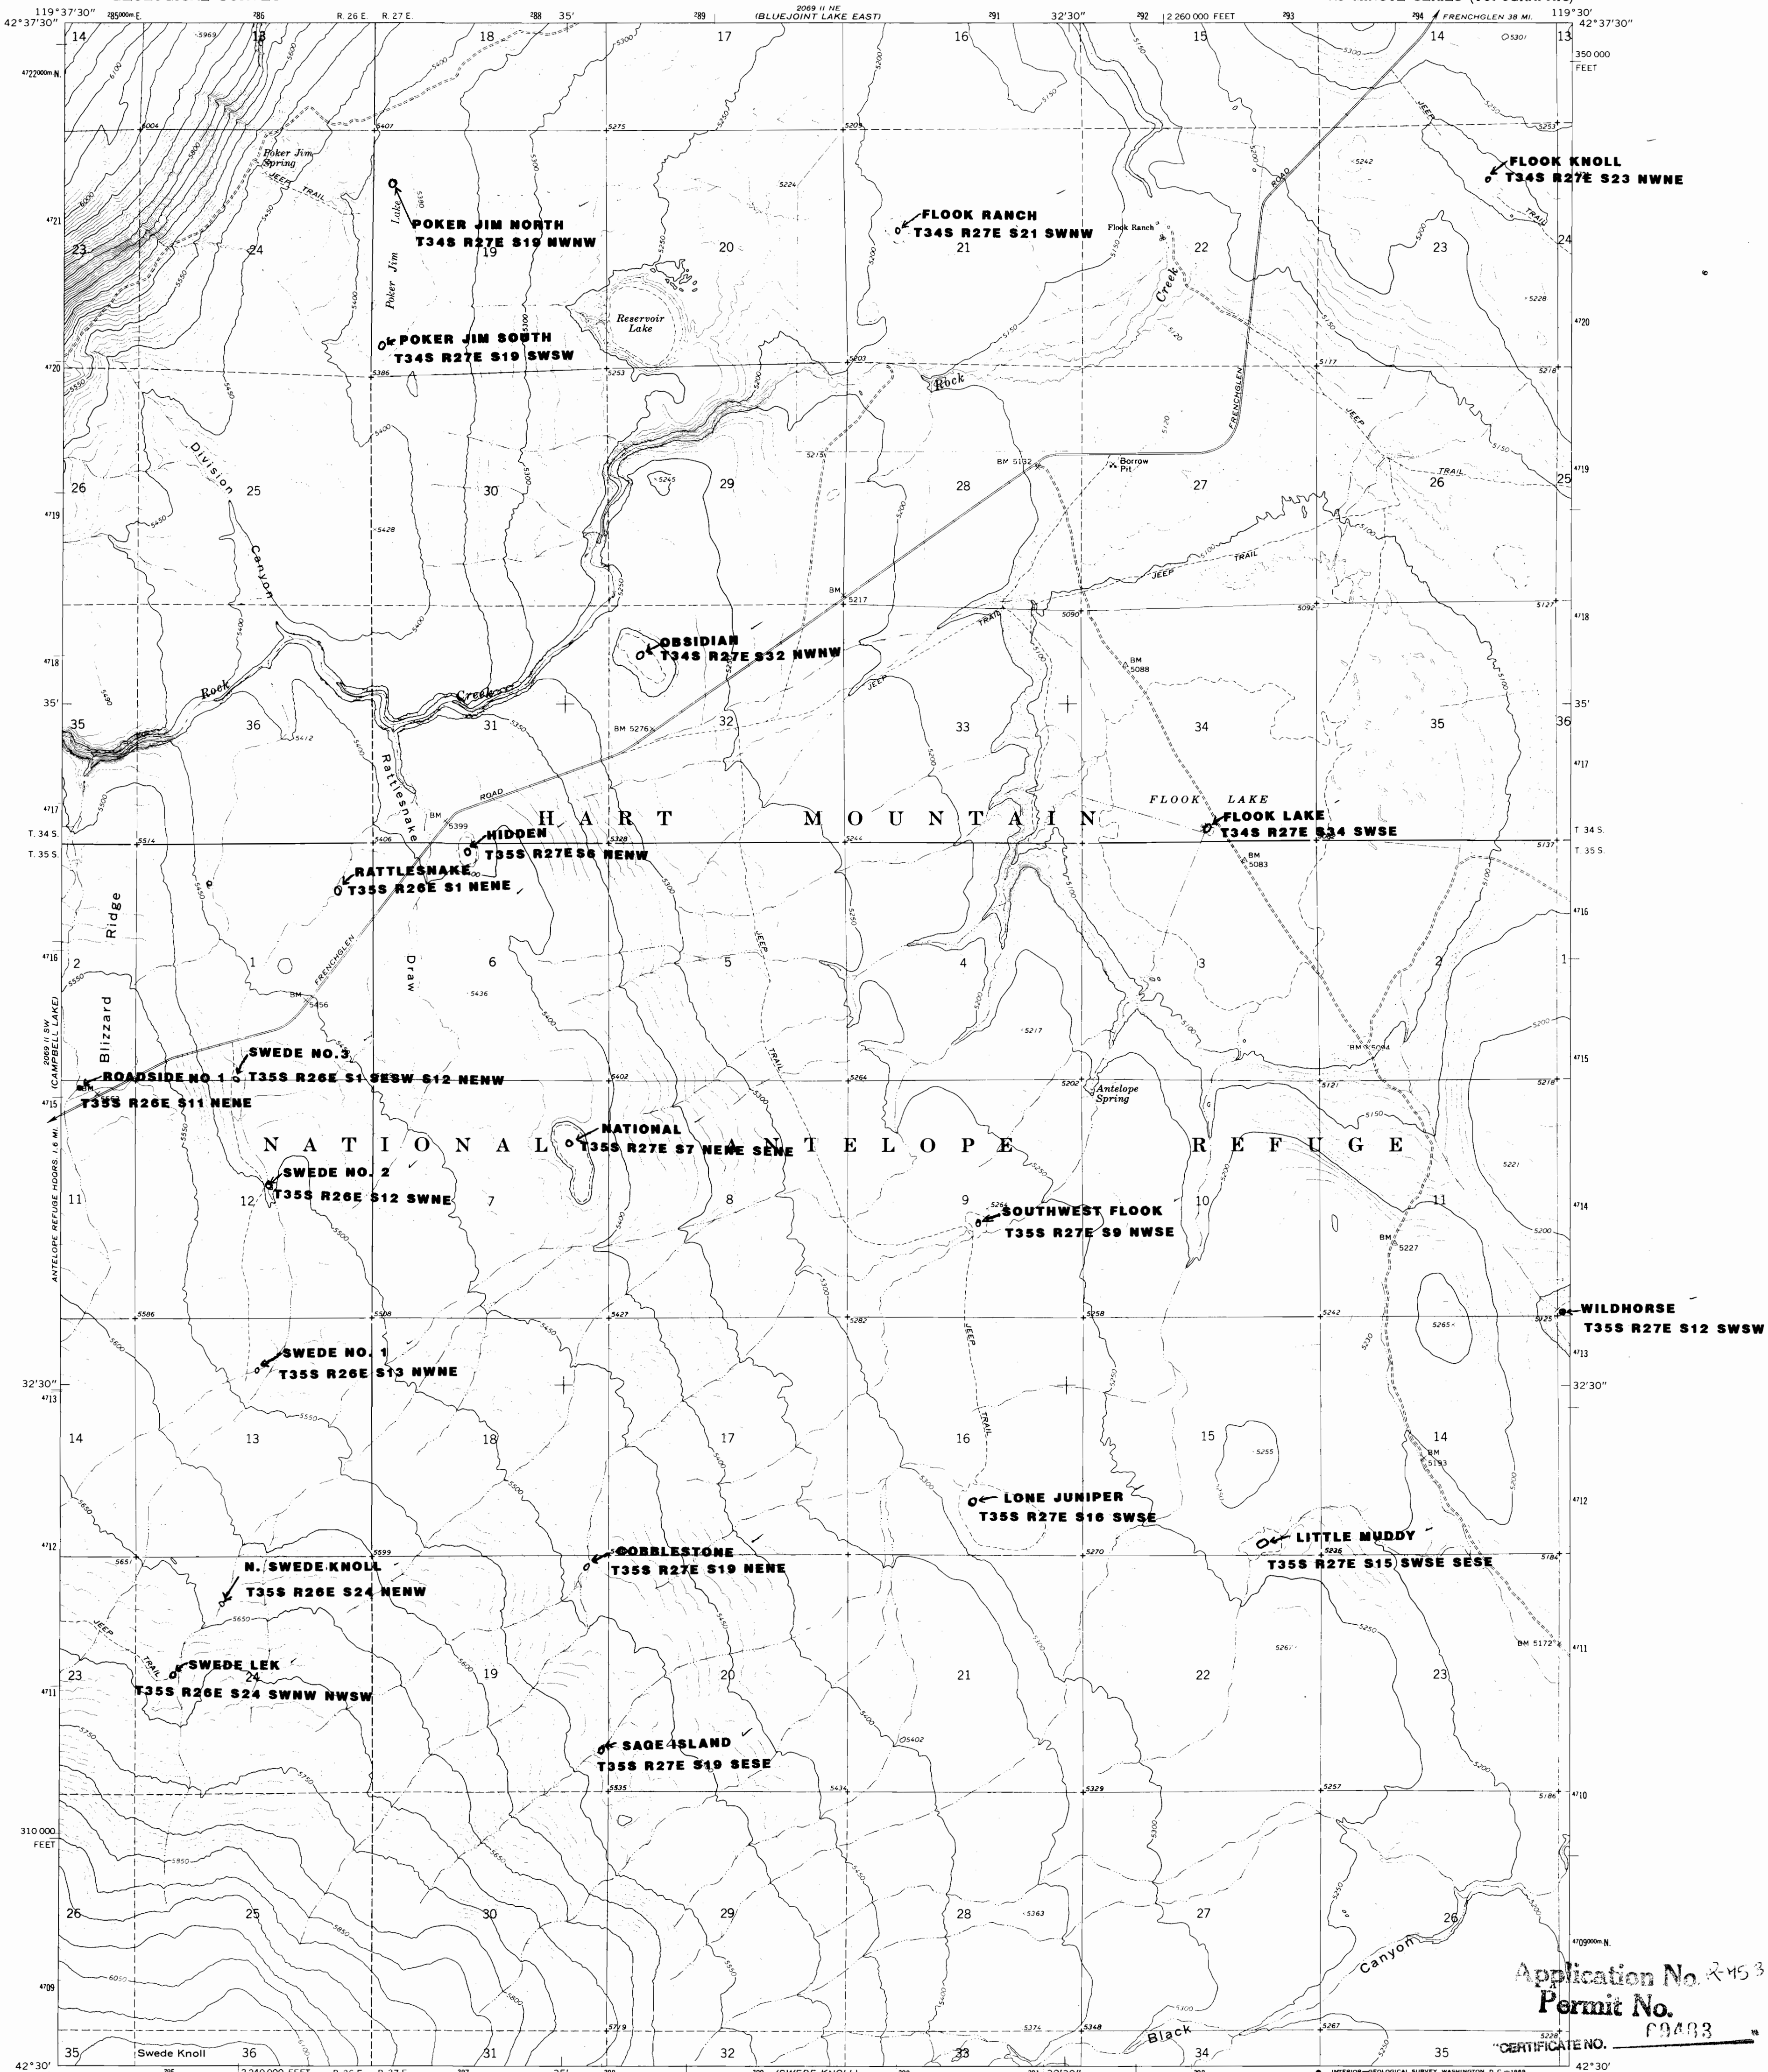

(WARNER PEAK)

Mapped, edited, and published by the Geological Survey
Control by USGS and USC&GS
Topography by photogrammetric methods from aerial
photographs taken 1964. Field checked 1967
Polyconic projection. 1927 North American datum
10,000-foot grid based on Oregon coordinate system,
south zone
1000-meter Universal Transverse Mercator grid ticks,
zone 11, shown in blue
Fine red dashed lines indicate selected fence lines

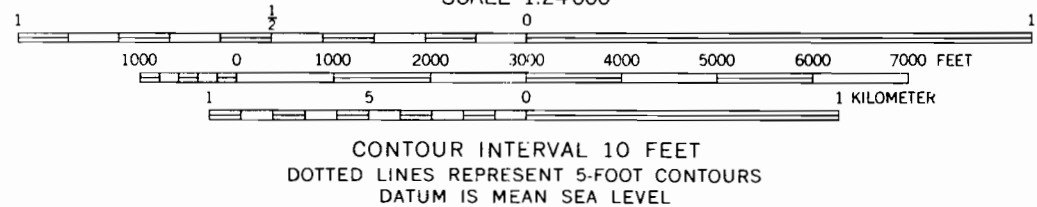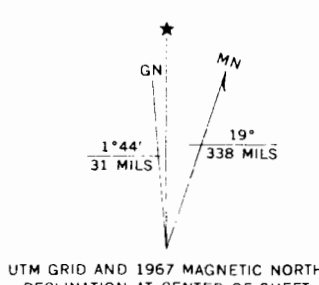

ROAD CLASSIFICATION
Light-duty ————— Unimproved dirt —————

FLOOK LAKE, OREG.
N4230—W11930/7.5

Application No. 24531
Permit No. 69483
CERTIFICATE NO.