


R-15378

CERTIFICATE NO. 69523

58-3

SEE MAP
2S 2 7

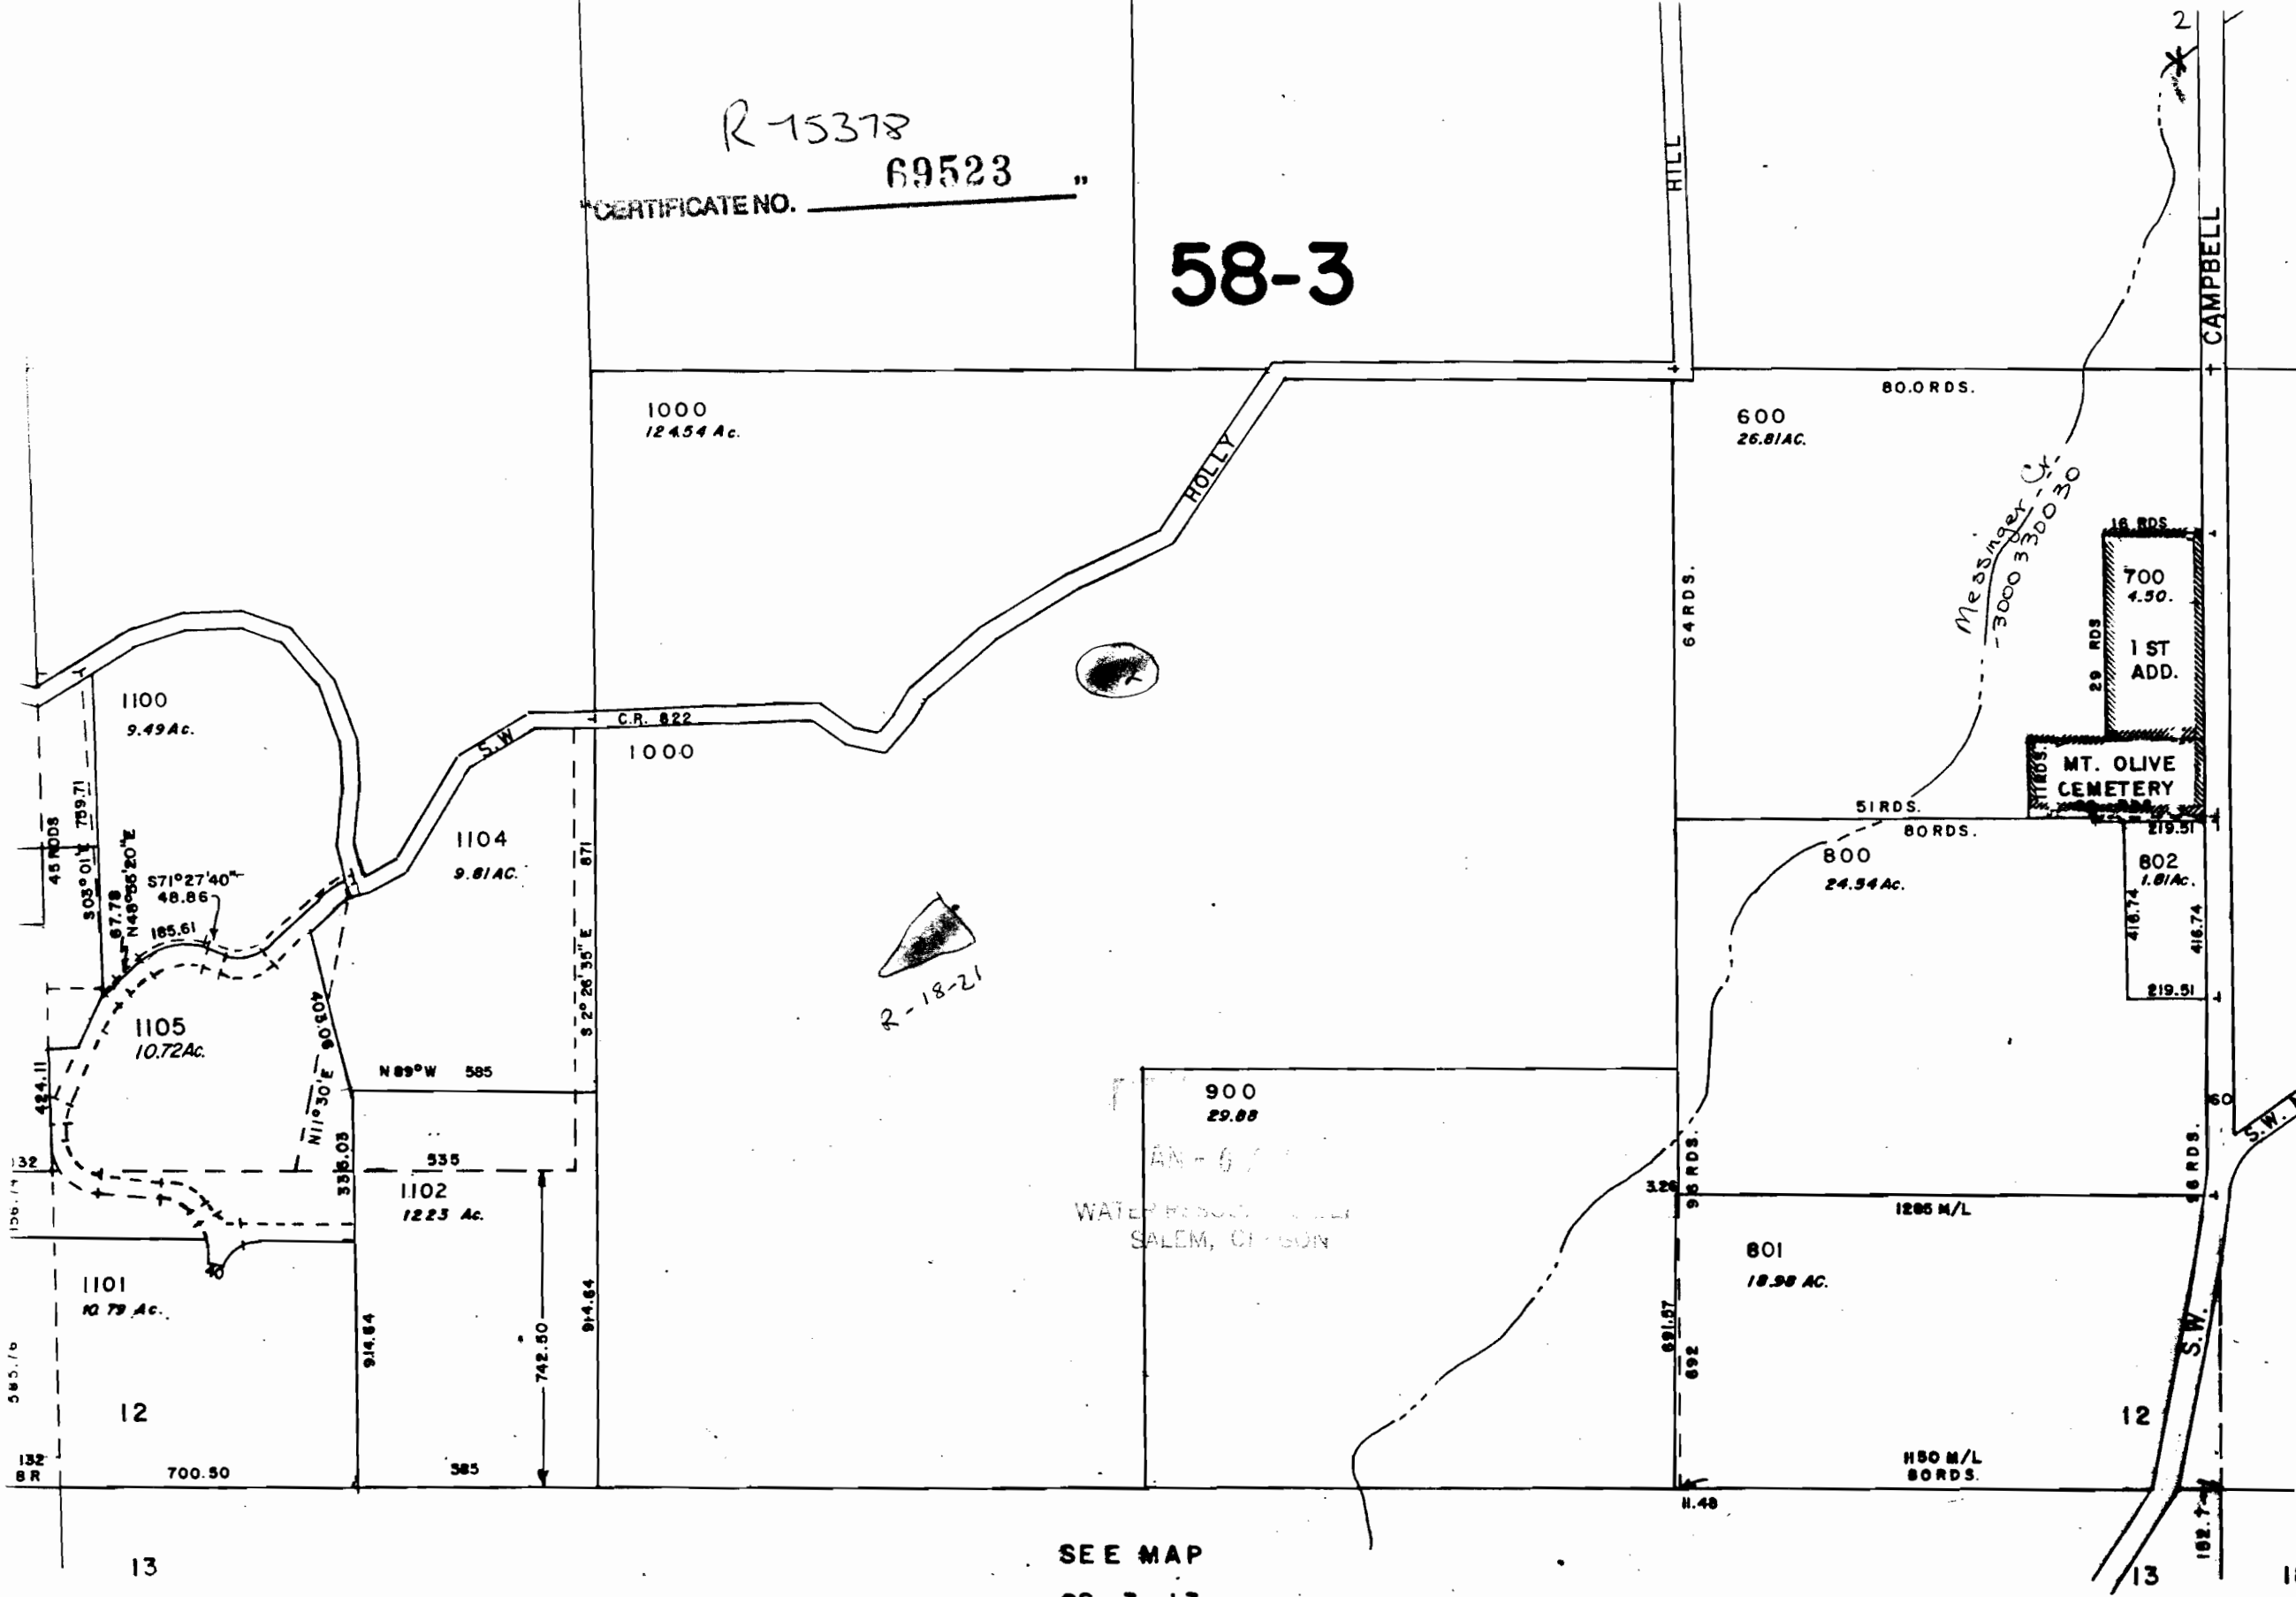

FOR ASSESSMENT
PURPOSES ONLY
DO NOT RELY ON
FOR ANY OTHER USE

SEE MAP
2S 3 13

FOR ASSESSMENT PURPOSES
ONLY - DO NOT RELY ON IT

2S 3 12