


S.E. C. Line - 5

Application No R-15424^H
Permit No.

"CERTIFICATE NO. 69558"

100 1 1504

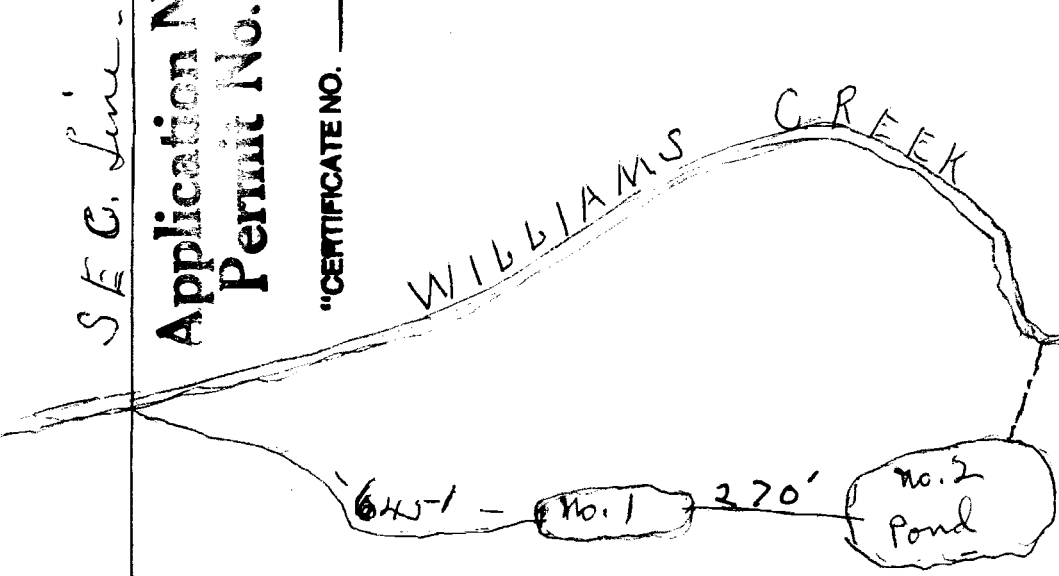

Center of Williams Creek property North line.

No. 1 pond - 90' x 18' - 4 1/2' deep

No. 2 pond - 72' x 156' - 6' deep

H' banks on both ponds

Point of diversion on West section line 755' North of

Corner of sections - H-5-8-9

645' Point of diversion to

No. 1 pond.

Ponds on tax lot - 1H03

SW 1/4 of SW 1/4 - Sec 14 - Twp 39S
R-5W

Ponds used for livestock watering

Wild duck nesting

fish spawning

12" plastic pipe used open ditch overflow at one end of pond

Corner H-5-8-9

- 755'

South line section H