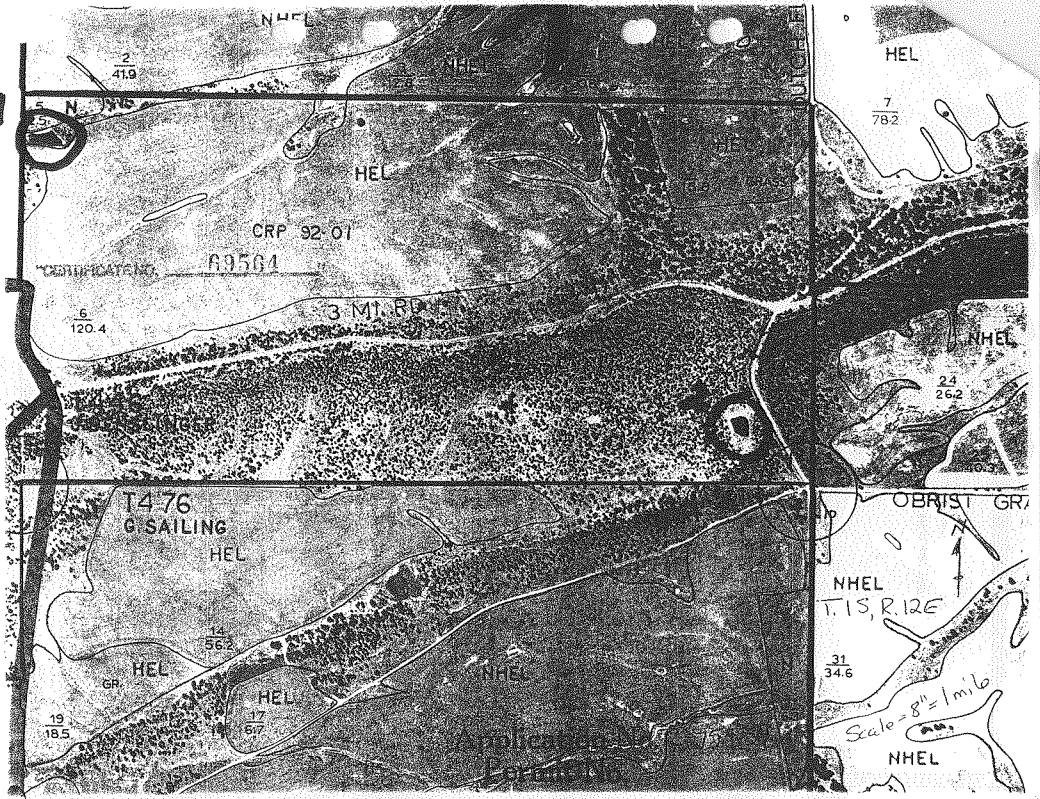
NHEL
2
41.9
HEL
7
78.2
CRP 92-01
CERTIFICATE NO. 60564
3 MI. RD.
6
120.4
NHEL
24
26.2
T4 76
G SAILING
HEL
14
56.2
HEL
NHEL
19
18.5
17
61.7
OBRIST GR
NHEL
T. 1S, R. 12E
31
34.6
Scale - 8" = 1 mi
NHEL
Applicant
Permit No.