


USGS Beaverton, OR QUAD

1961

Photorevised 1984

UNITED STATES
DEPARTMENT OF THE INTERIOR
GEOLOGICAL SURVEY

122°52'30" 510 R 2 W 1 R 1 W 51 1000 E 512 50'

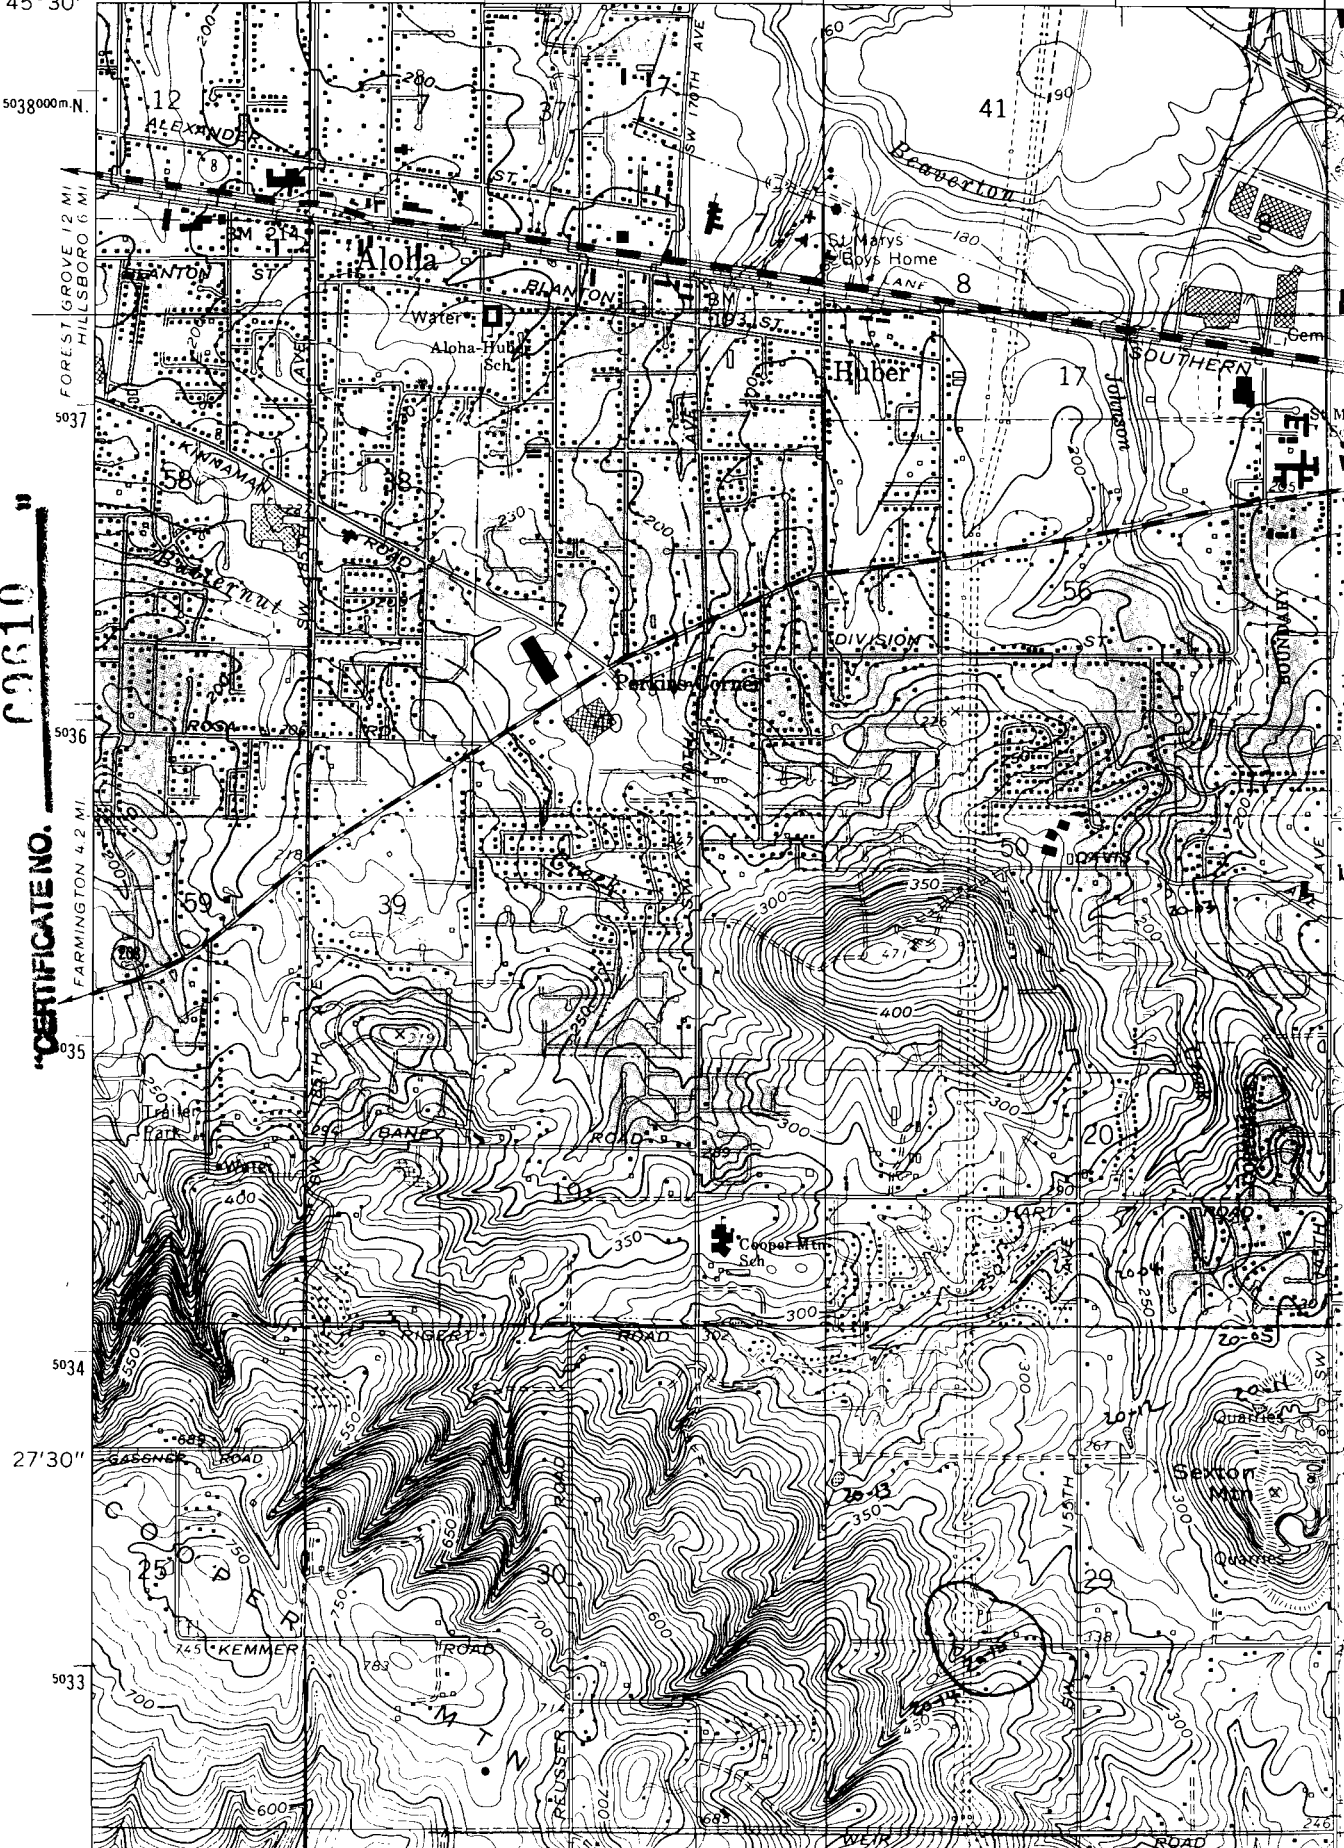

Application No. R-75499
Permit No.

CERTIFICATE NO. 09610

1475 III SW
(HILLSBORO)
12

5038000 N.
5037
5036
5035
5034
27'30"
5033

FOREST GROVE 12 MI.
HILLSBORO 6 MI.
FARMINGTON 4.2 MI.