


3 N 3 32 D - 01100

SEE MAP 3 N 3 32

70-2 AND OR 70-13

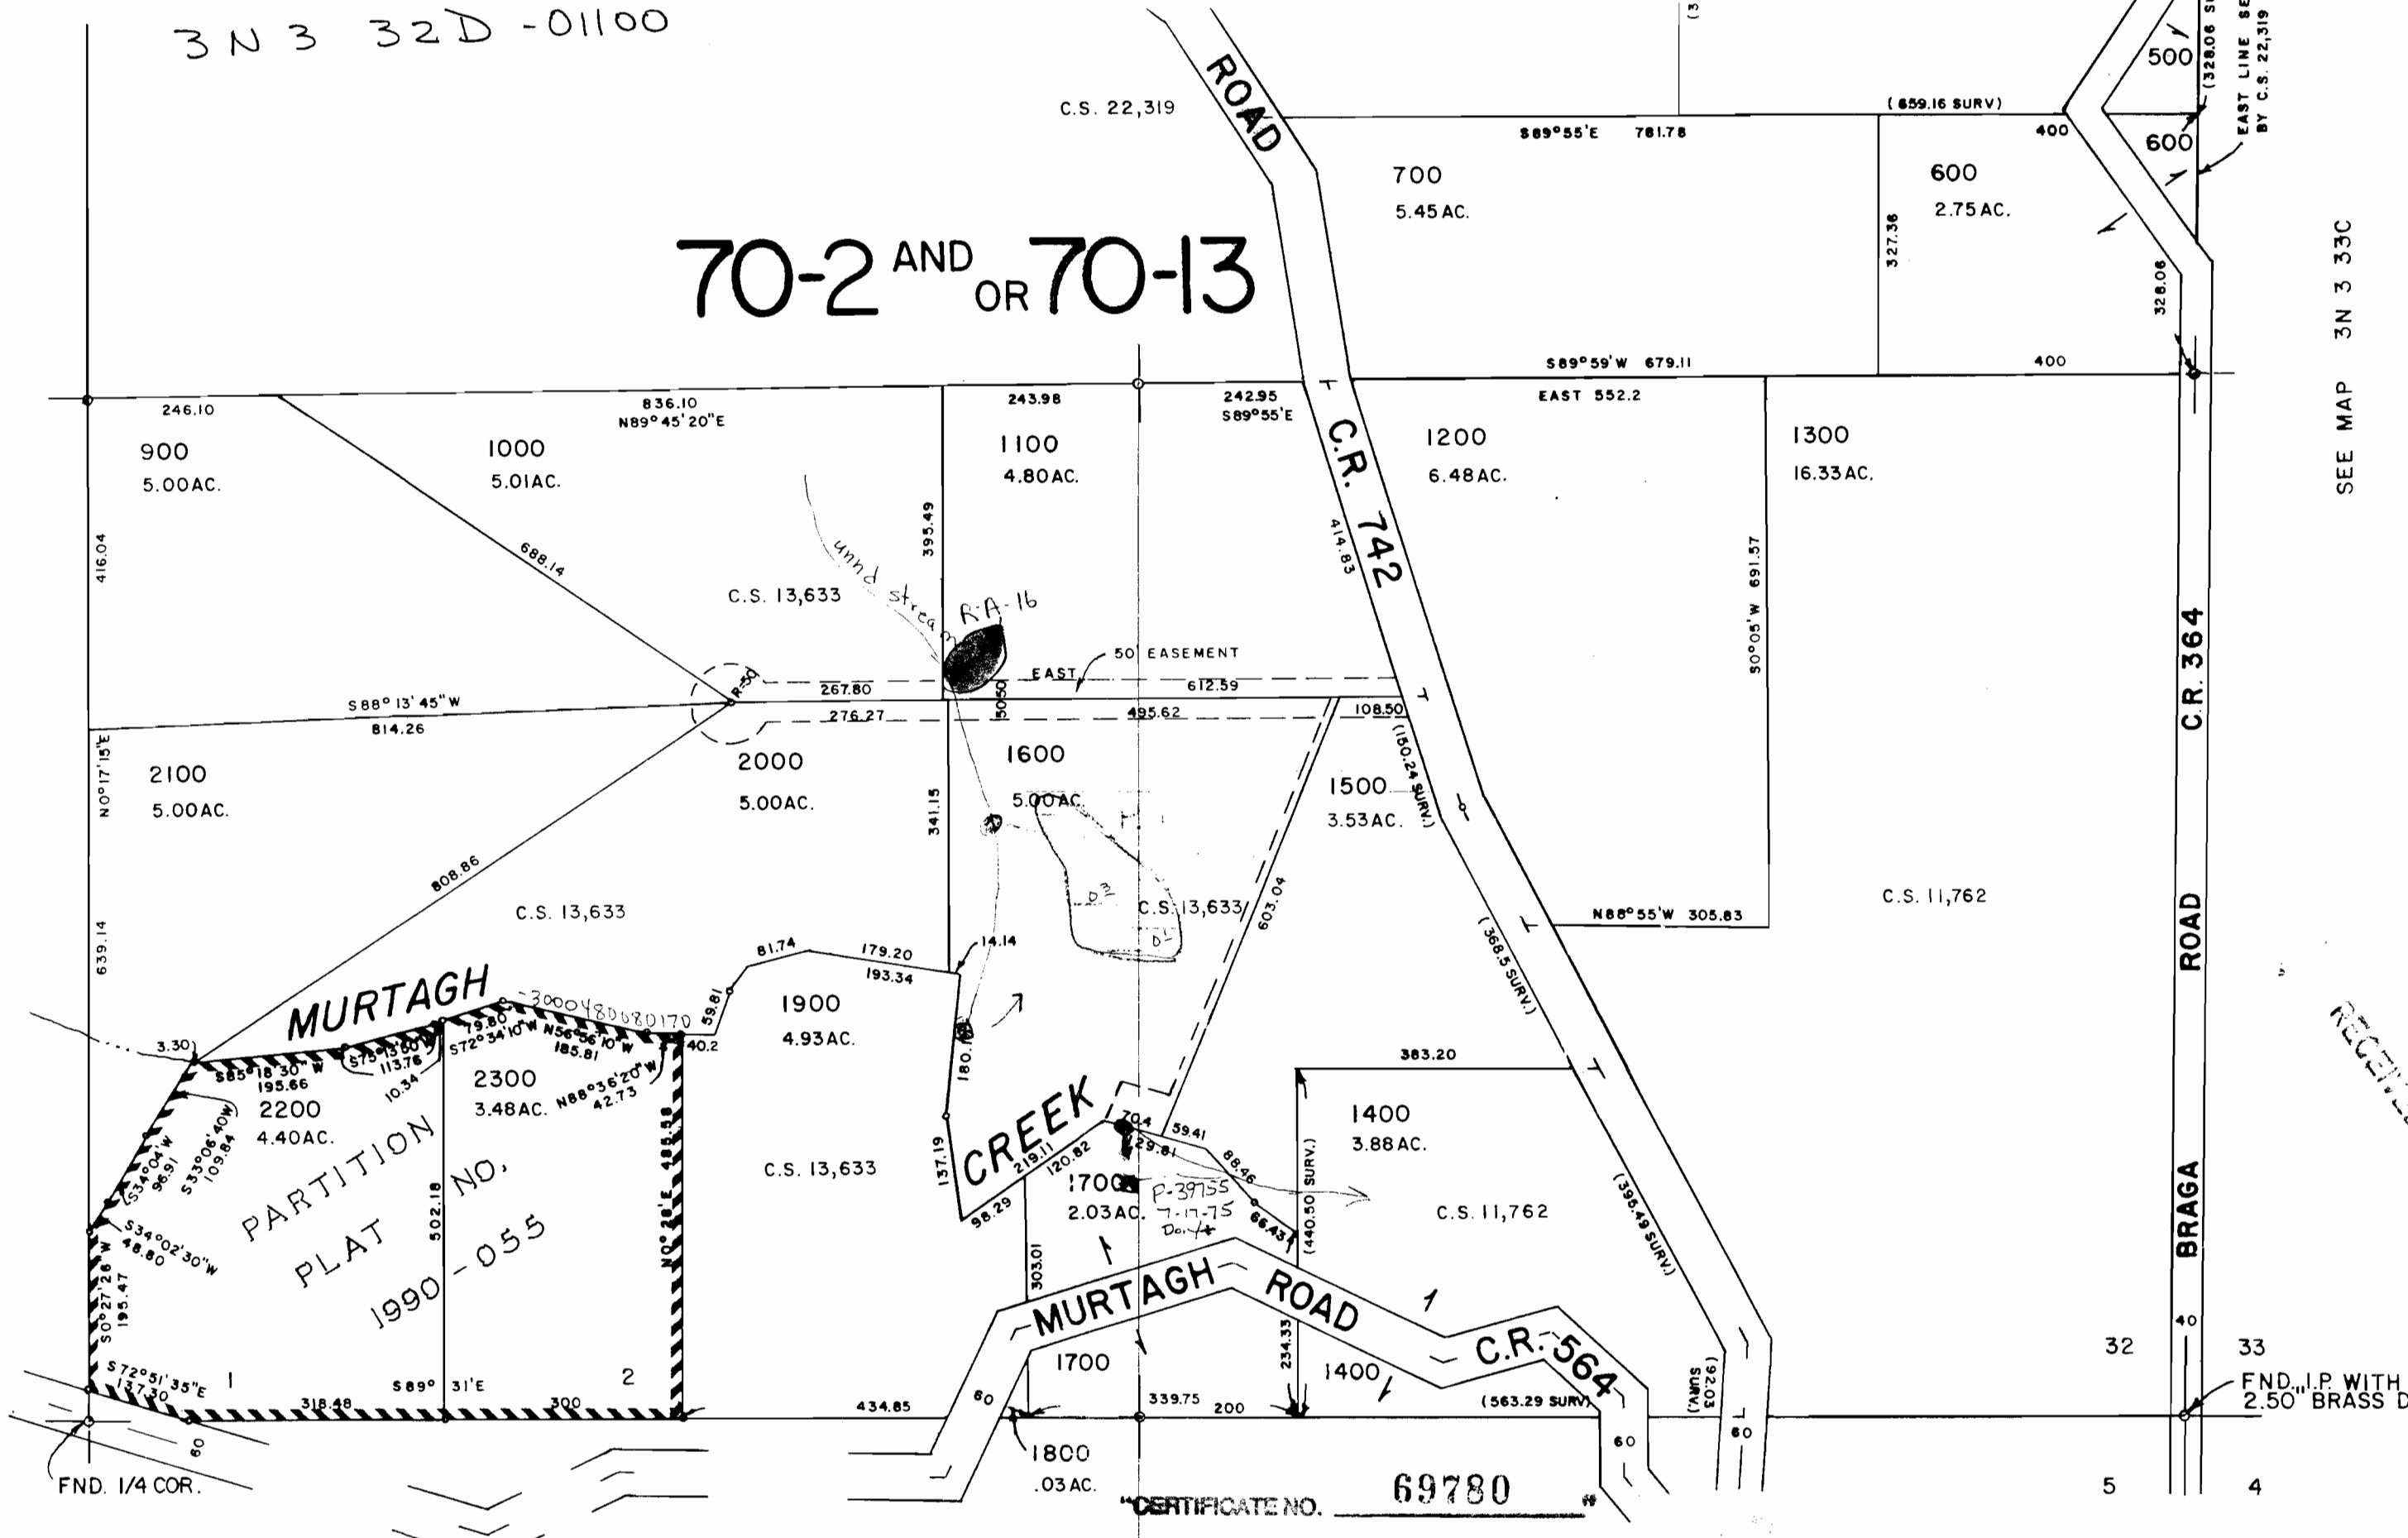

SEE MAP 3 N 3 33C

RECEIVED

CERTIFICATE NO. 69780

SEE MAP 2 N 3 5

Application No. R-75767
Plat No.

3 N 3 32 D
1100

3 N 3