


SEE MAP
2N 3 14

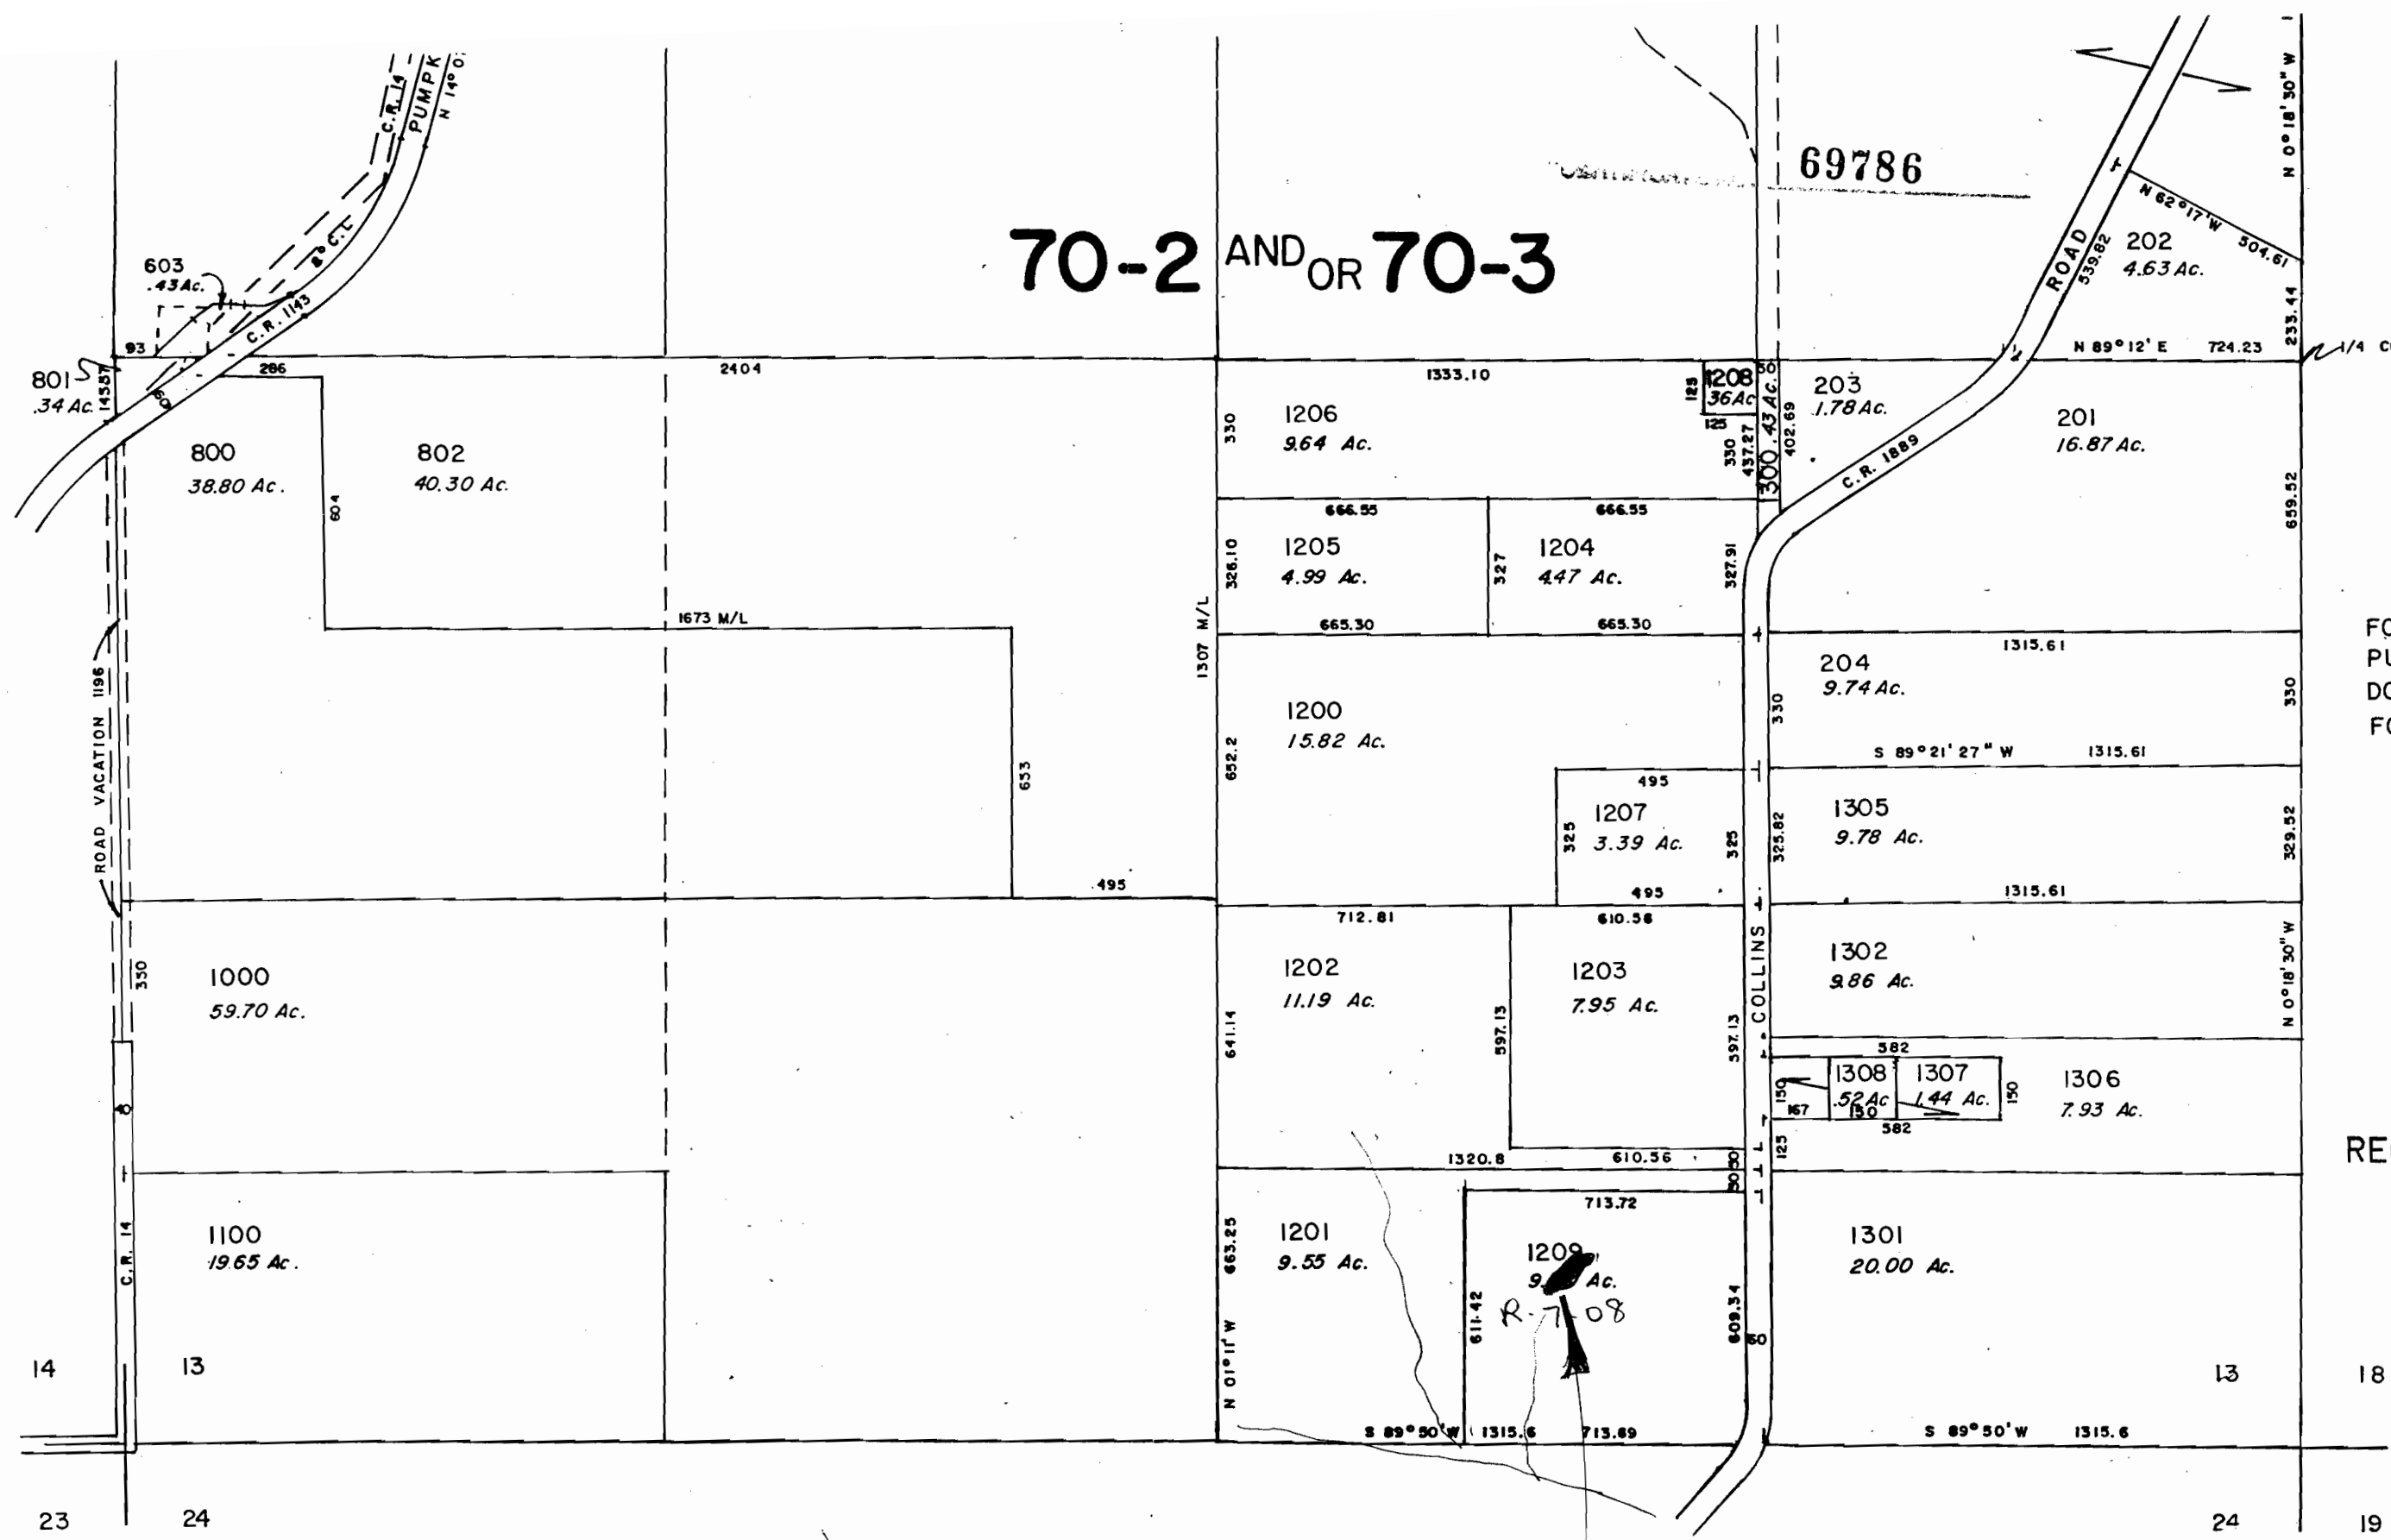

SEE MAP
2N 2 B

FOR ASSESSMENT
PURPOSES ONLY
DO NOT RELY
FOR ANY OTHER

RECEIVED DE

SEE MAP
2N 3 24

1970's Pond 1/4 Acre

Application No. R-75775 2N 3 13
Form No. 2N 3