

Form A1-187
March 1961

UNITED STATES
DEPARTMENT OF THE INTERIOR
BUREAU OF LAND MANAGEMENT

RECEIVED

SEP 30 1983

SECTION


35 NESW

Oregon State Water Filings

WATER RESOURCES DEPT
SALEM, OREGON

TOWNSHIP 30 S, RANGE 37 E, W. M.

North LAKE RIDGE RES.

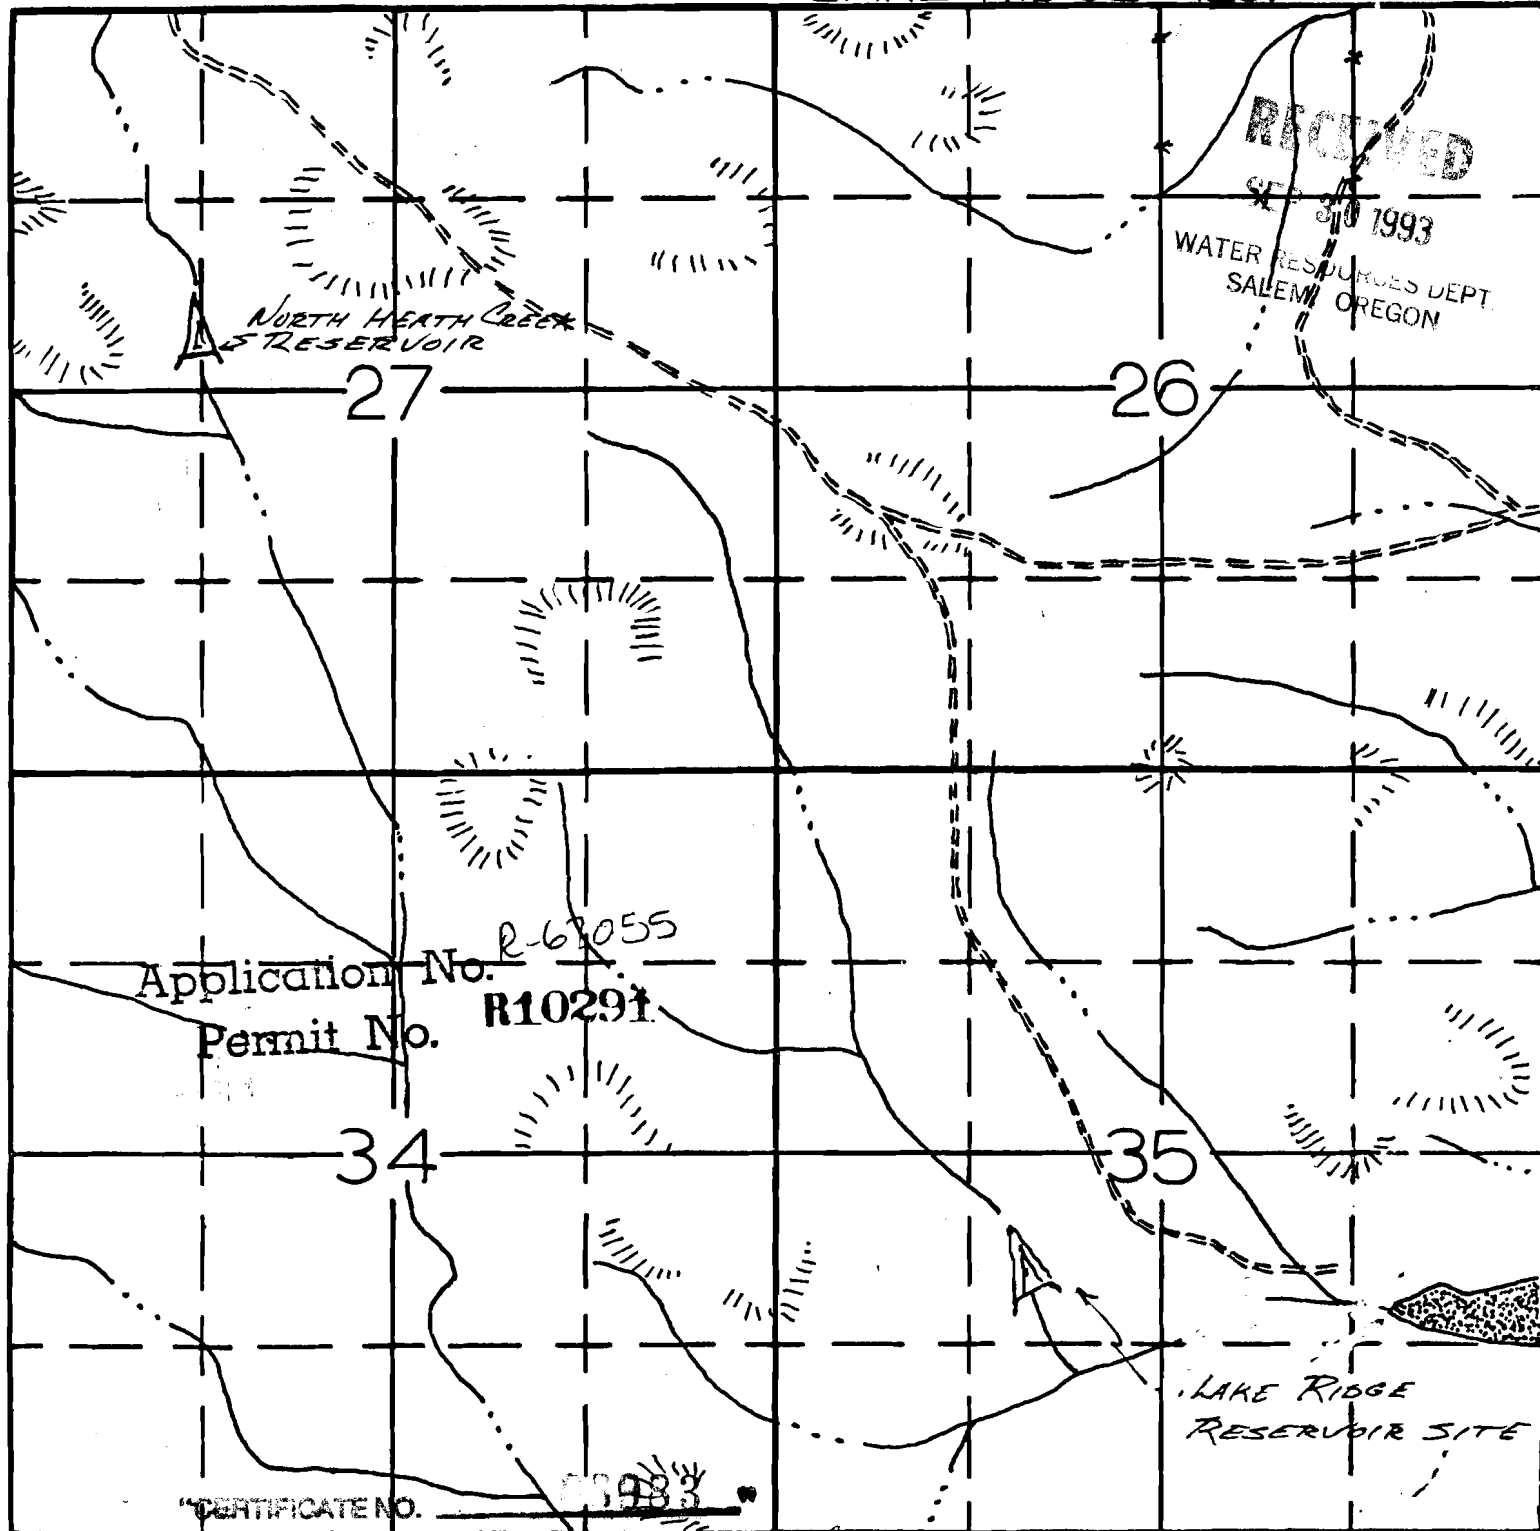

DRAWN JA 9-13

R-77058

APPLICATION No.

PERMIT No.