

P. 5628
2377
50550


17408

STATE ENGINEER
RECEIVED

SEP 18 1922

SALEM, • OREGON

2047

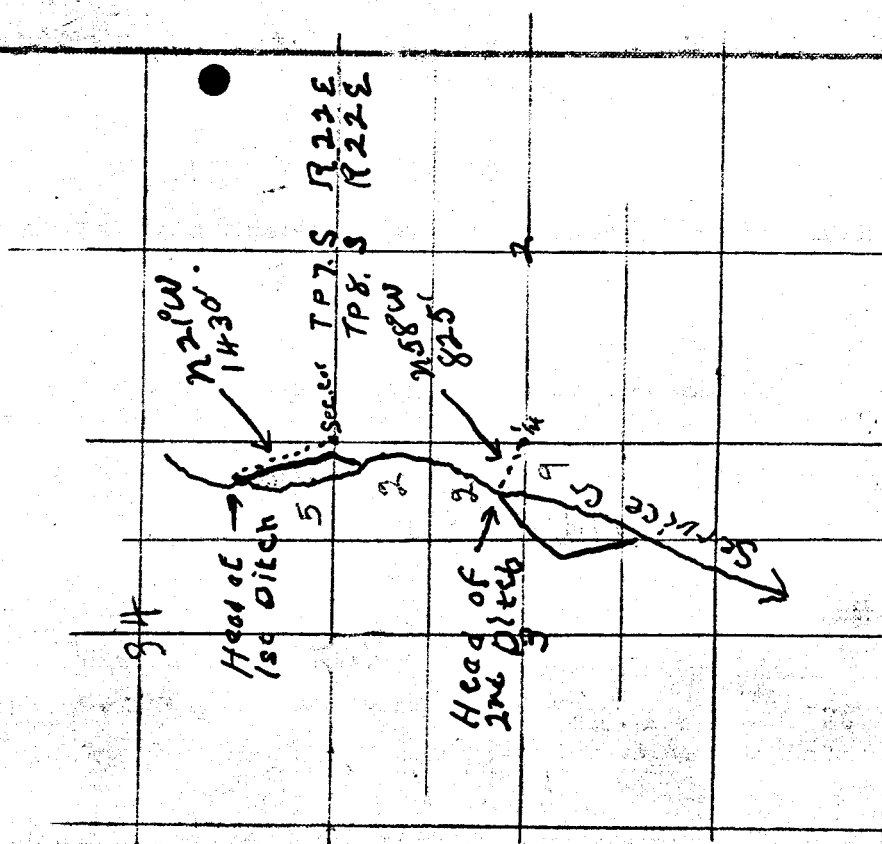

Application No. 8647
Permit No. 5628