




UNITED STATES
DEPARTMENT OF THE INTERIOR
GEOLOGICAL SURVEY

70996
BUTLER HILL QUADRANGLE
OREGON-HARNEY CO.
7.5 MINUTE SERIES (TOPOGRAPHIC)

Application No. R-77279
Permit No.

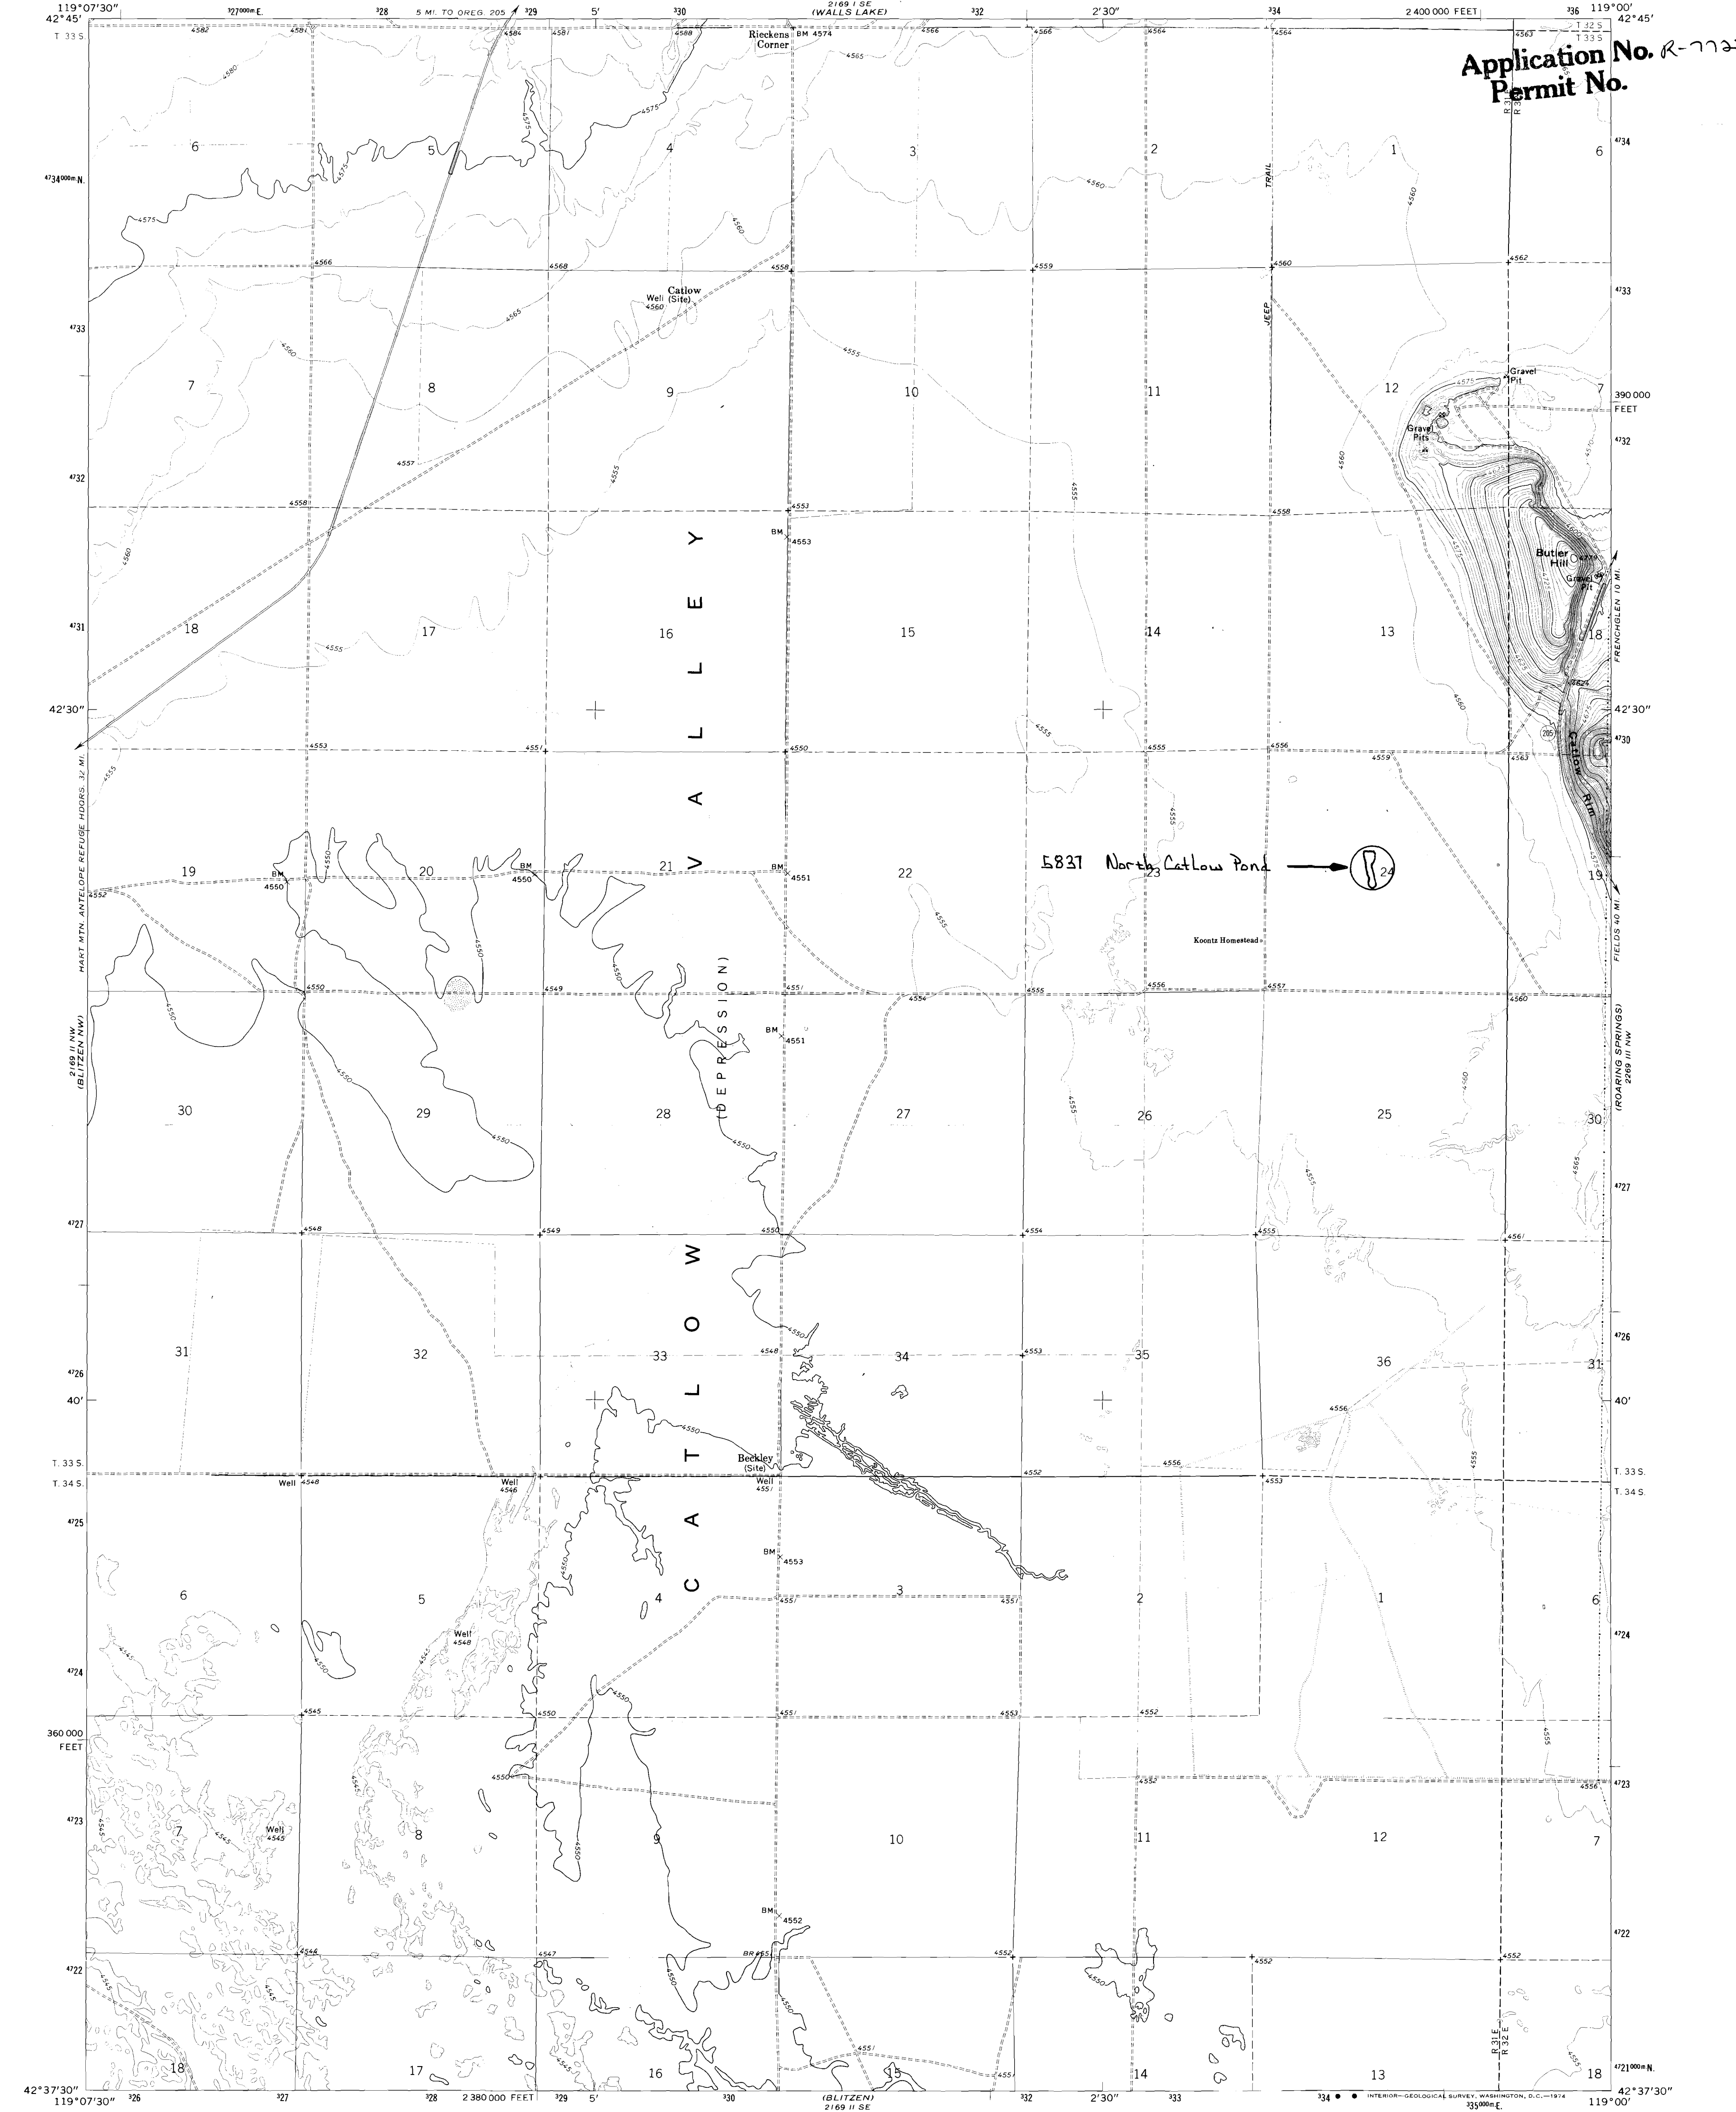

Mapped, edited, and published by the Geological Survey
Control by USGS and USC&GS
Topography by photogrammetric methods from aerial
photographs taken 1969. Field checked 1971
Projection and 10,000-foot grid ticks: Oregon coordinate
system, south zone (Lambert conformal conic)
1000-meter Universal Transverse Mercator grid ticks,
zone 11, shown in blue. 1927 North American datum
Fine red dashed lines indicate selected fence lines
Where omitted, land lines have not been established

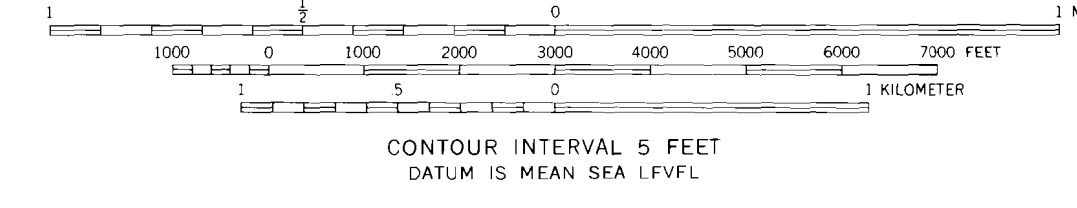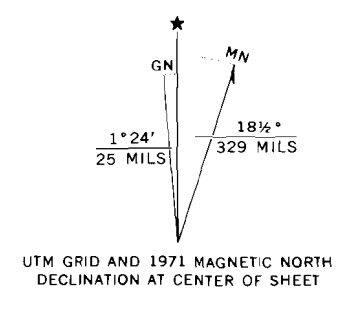

ROAD CLASSIFICATION
Primary highway, hard surface
Secondary highway, hard surface
Unimproved road
Interstate Route
U. S. Route
State Route

BUTLER HILL, OREG.
N4237.5-W11900/7.5

1971

AMS 2169 II NE-SERIES V892