


T. 9 S., R. 44 & 45 E., W.M.

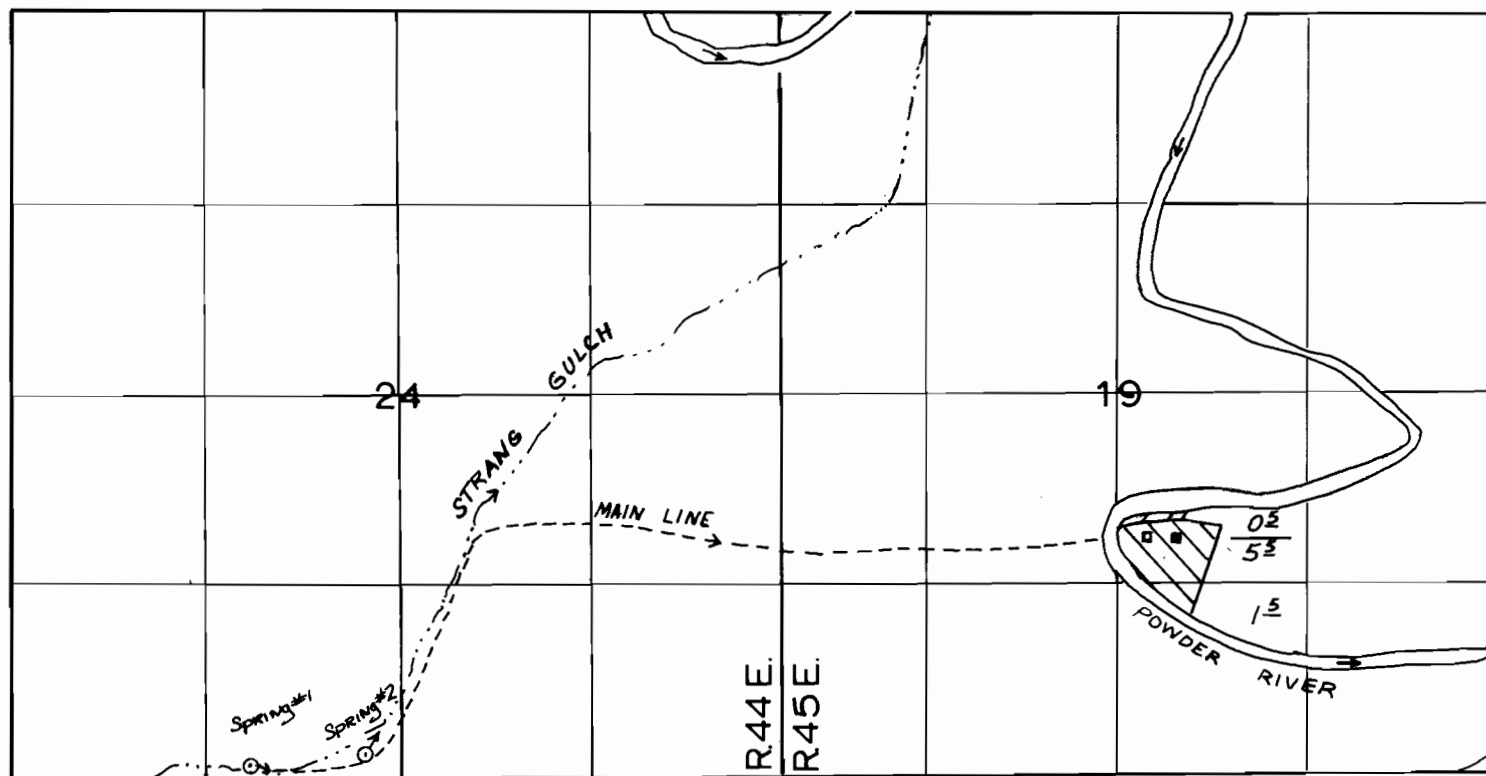

N
1" = 1320'

Spring # 1 - 75' N. and 3700' W.,
Spring # 2 - 130' N. and 2900' W.,
both from the SE Cor., Sec. 24.



PRIMARY
SUPPLEMENTAL

FINAL PROOF SURVEY UNDER

App. No. 63948 Permit No. 47517

IN NAME OF

WALLACE AND LORIN STANCIU

Surveyed 4-5-1994 by J. Miller

