SECTION 30 T1 S R3W W.M.

WASHINGTON COUNTY OREGON

SCALE 1"=400'

Application No. R-70138
Permit No.

"CERTIFICATE NO. 70118"
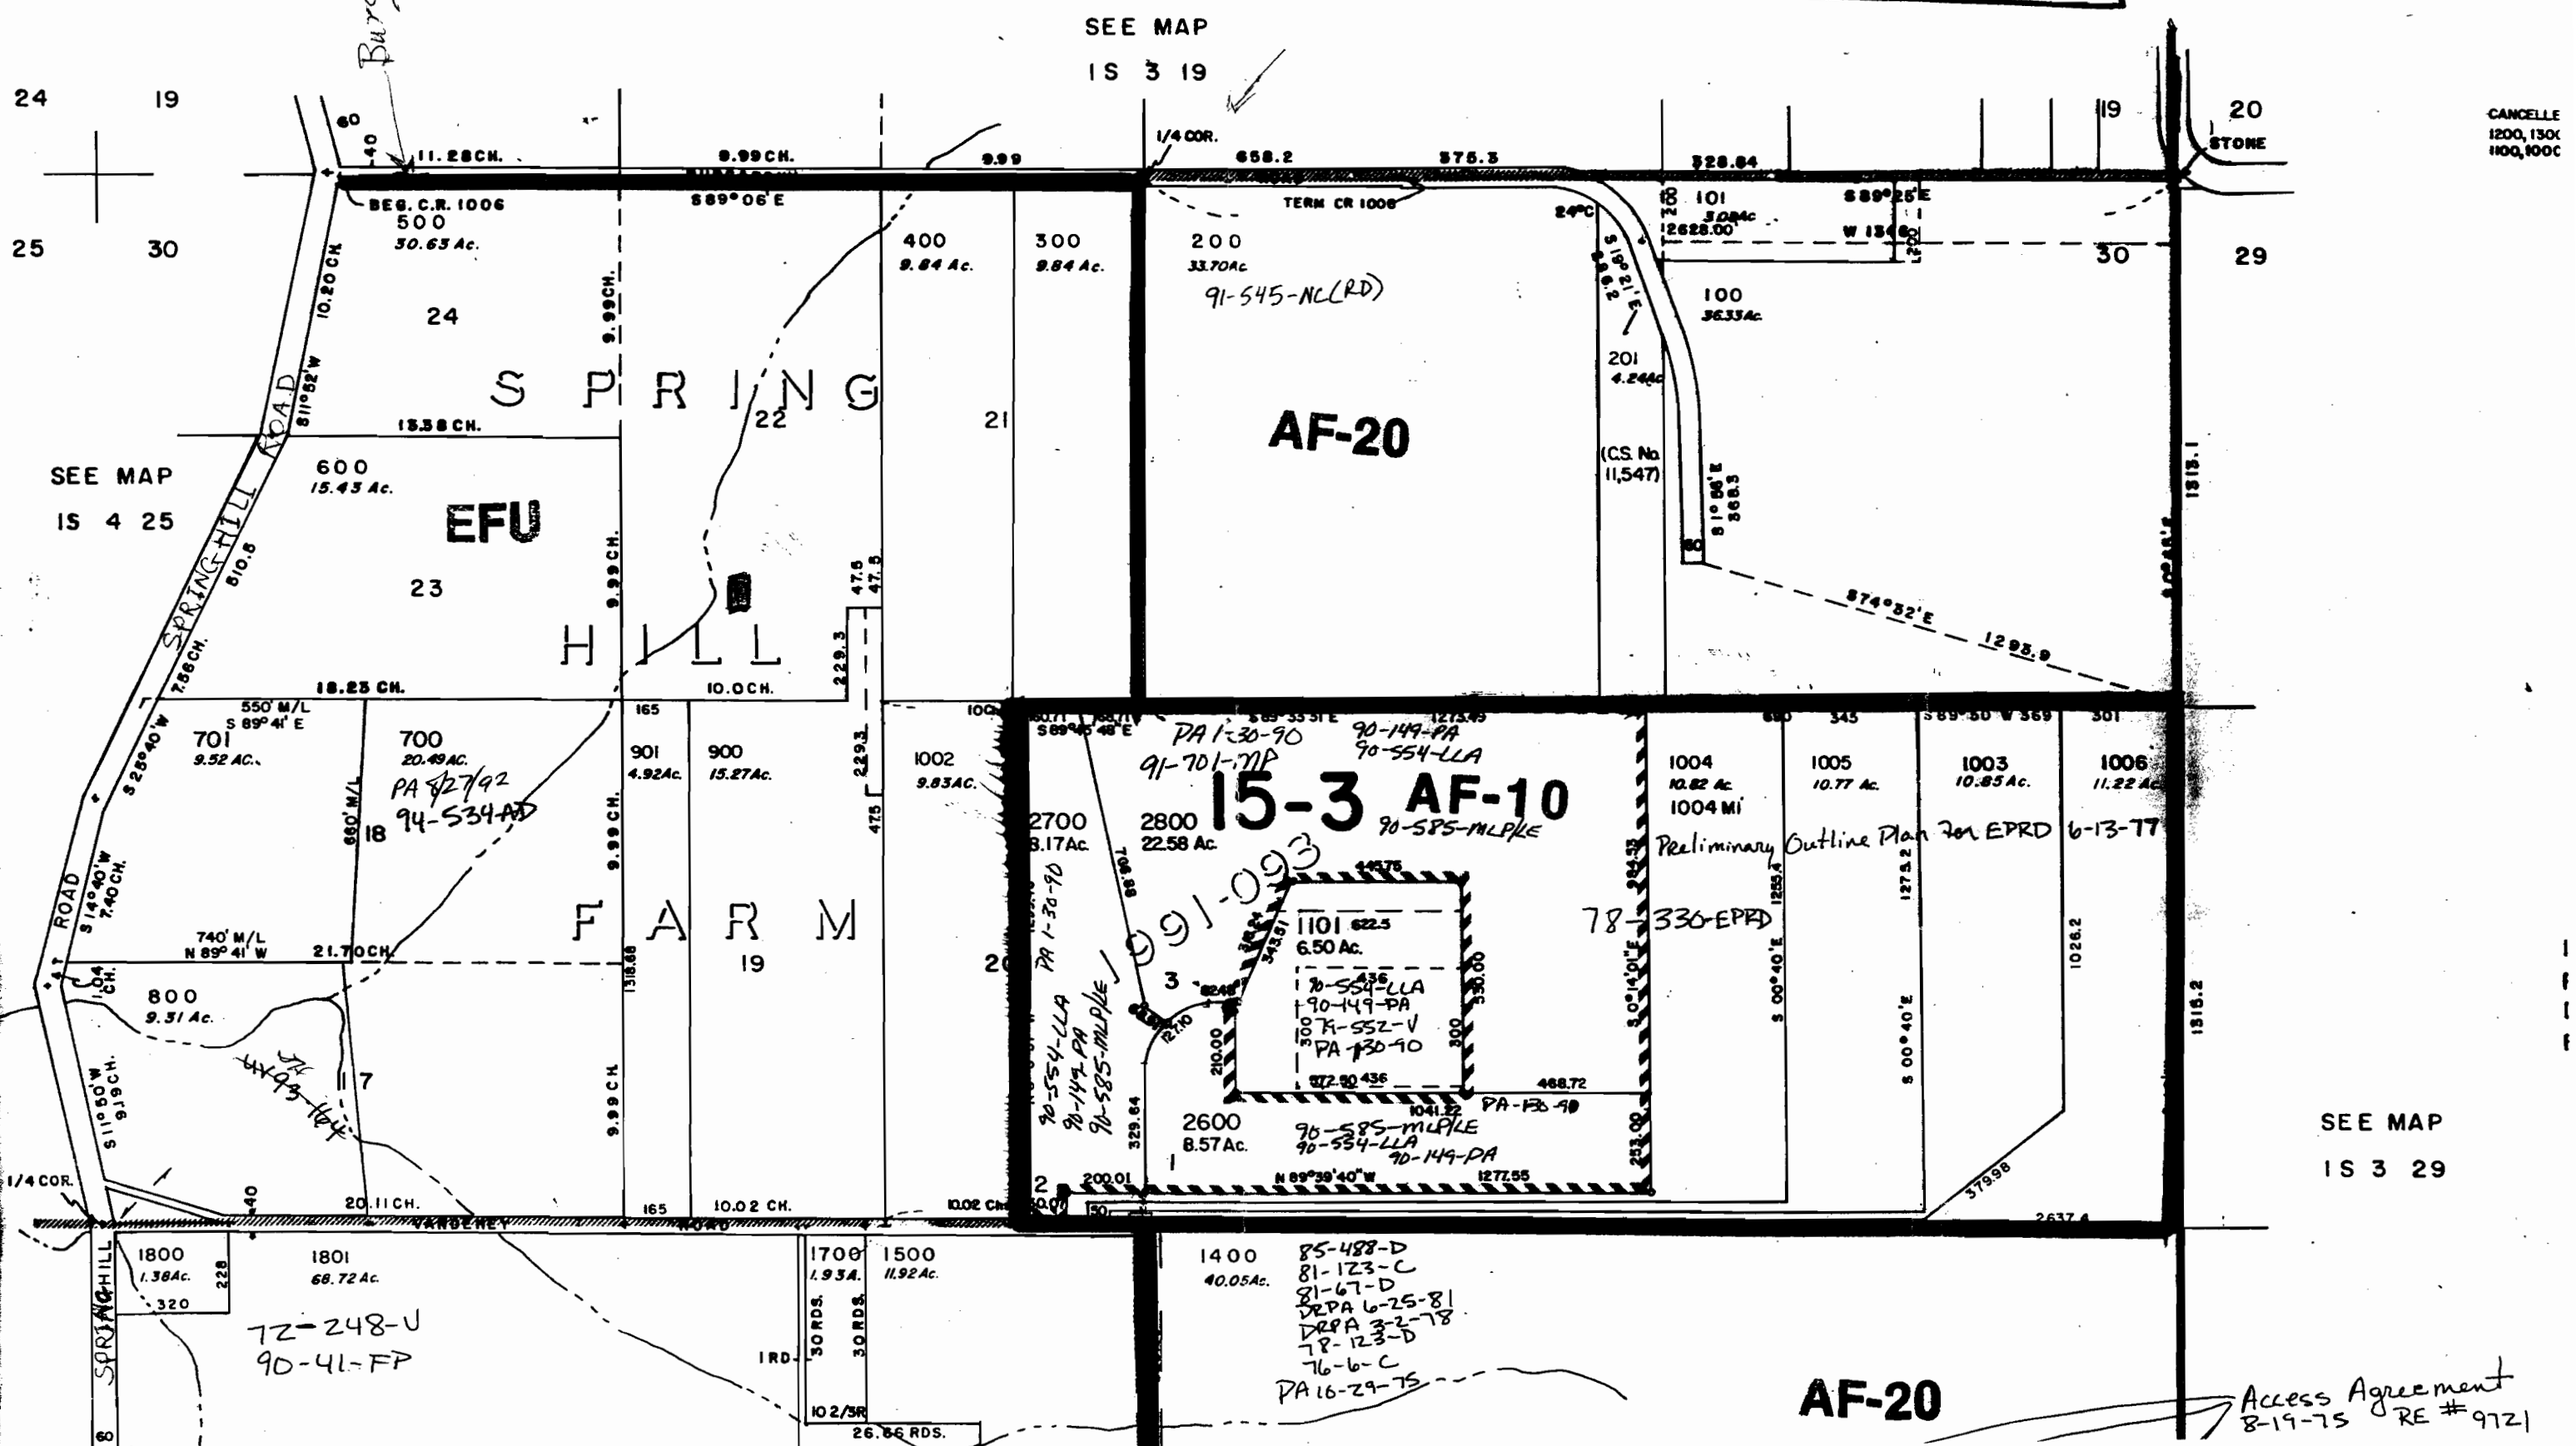
CENSUS TRACT 330