


# Exhibit A (Golf Course Layout)

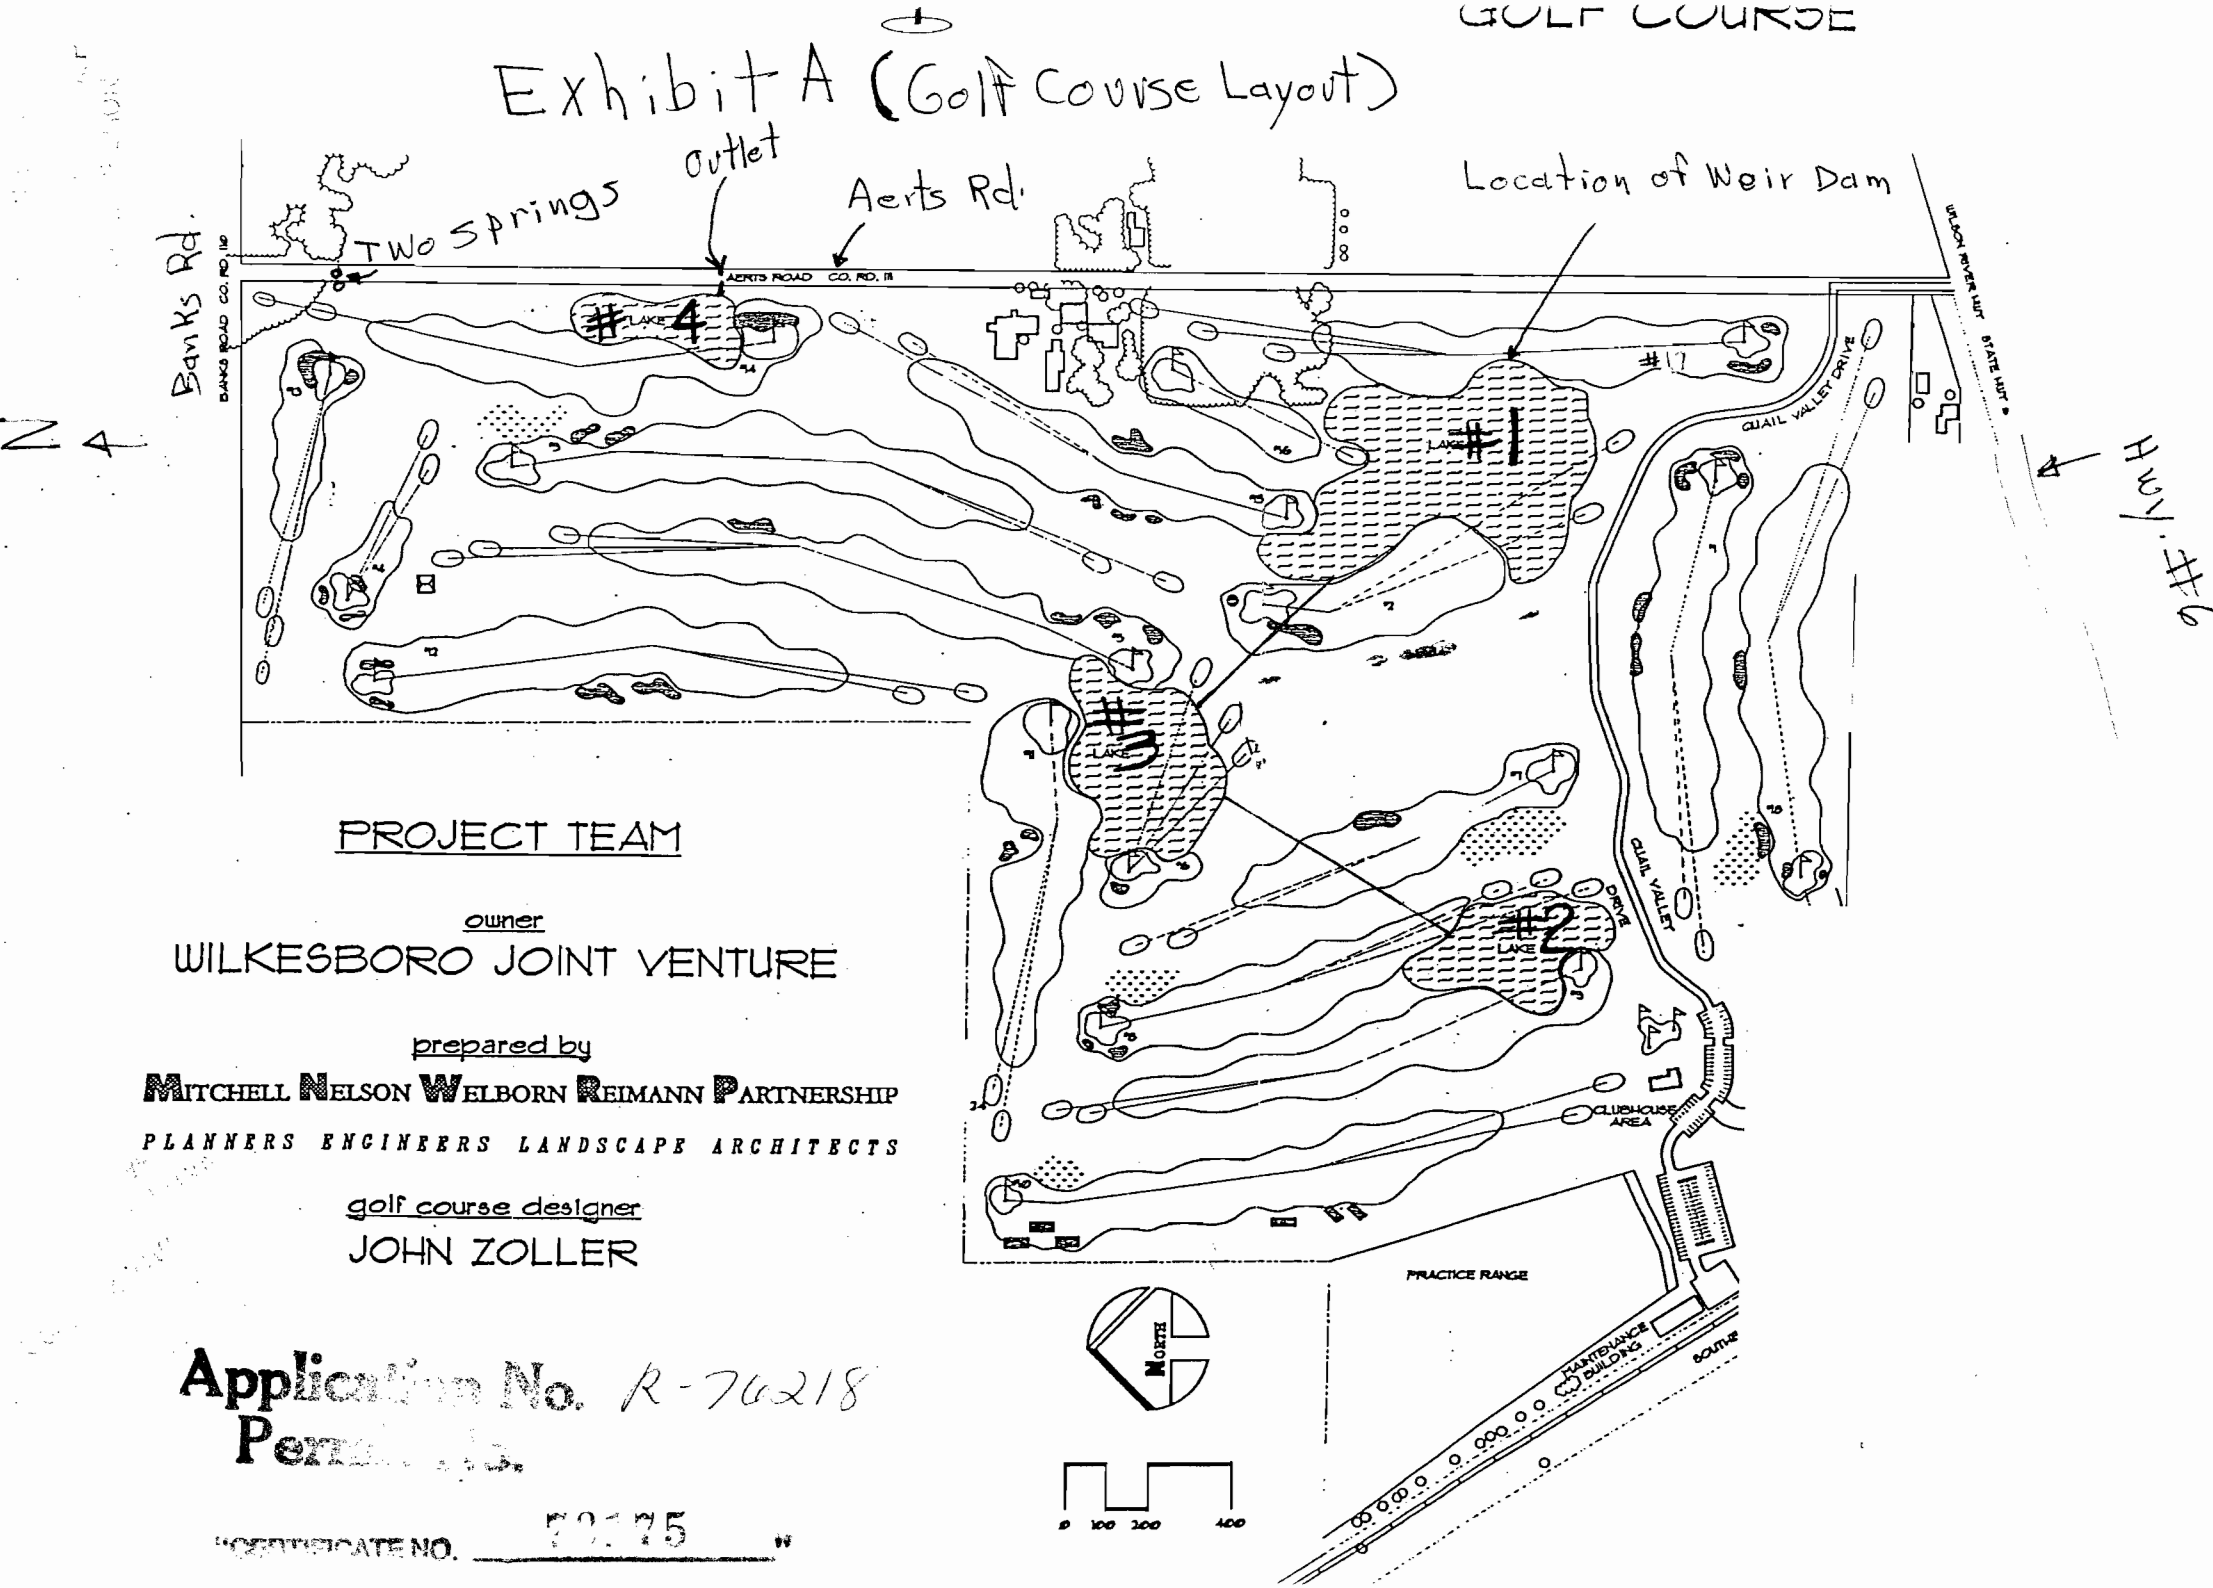

## PROJECT TEAM

owner

WILKESBORO JOINT VENTURE

prepared by

**MITCHELL NELSON WELBORN REIMANN PARTNERSHIP**  
PLANNERS ENGINEERS LANDSCAPE ARCHITECTS

golf course designer

JOHN ZOLLER

Application No. R-76218  
Permits

CERTIFICATE NO. 70175