


# Application No. R-74257 Permit No.

"CERTIFICATE NO. 70213"

JAN - 3 1995

COUNTY

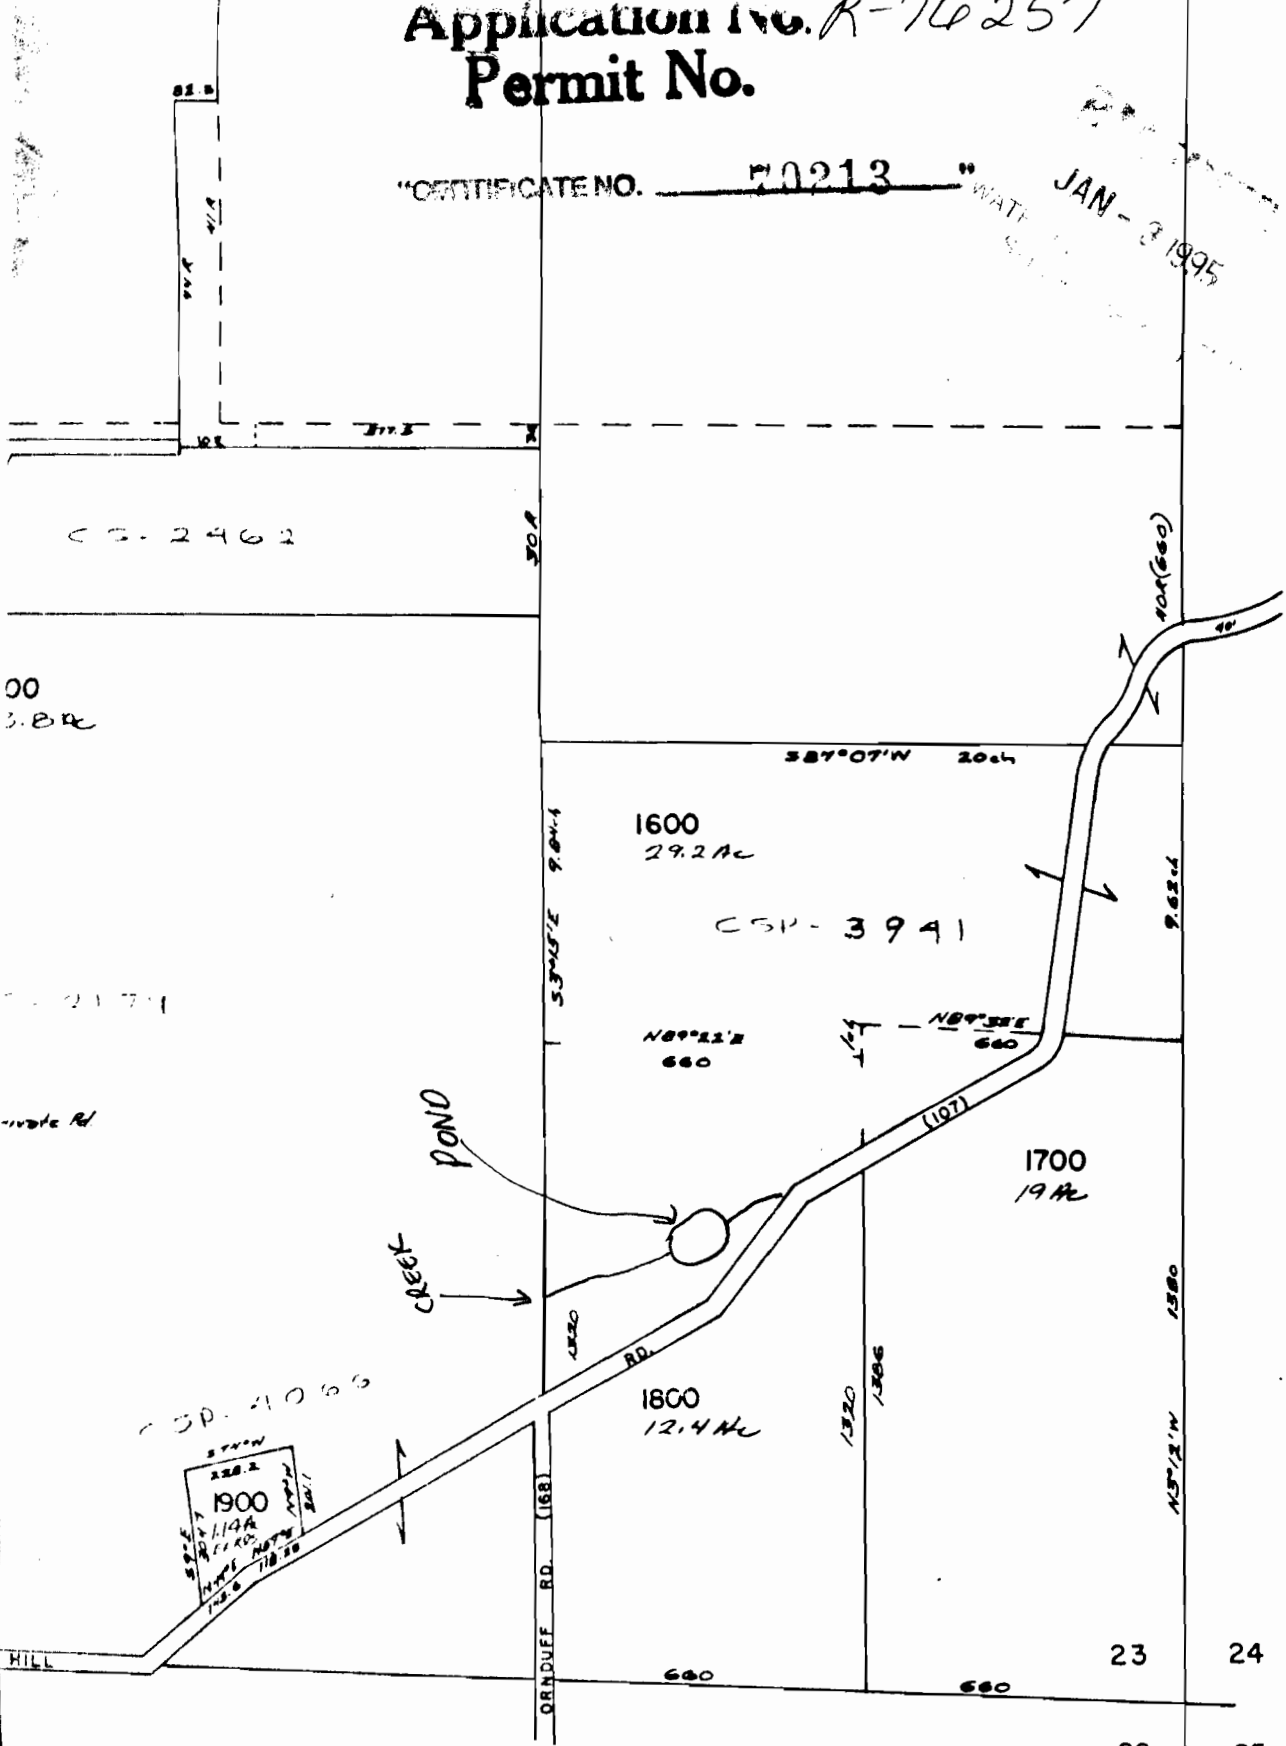

ROBIN CADDY 21655 FINNIGAN HILL ROAD HILLSBORO, OK 97123

APPLICATION No. HB 2153

WASHINGTON

(C)