


POND

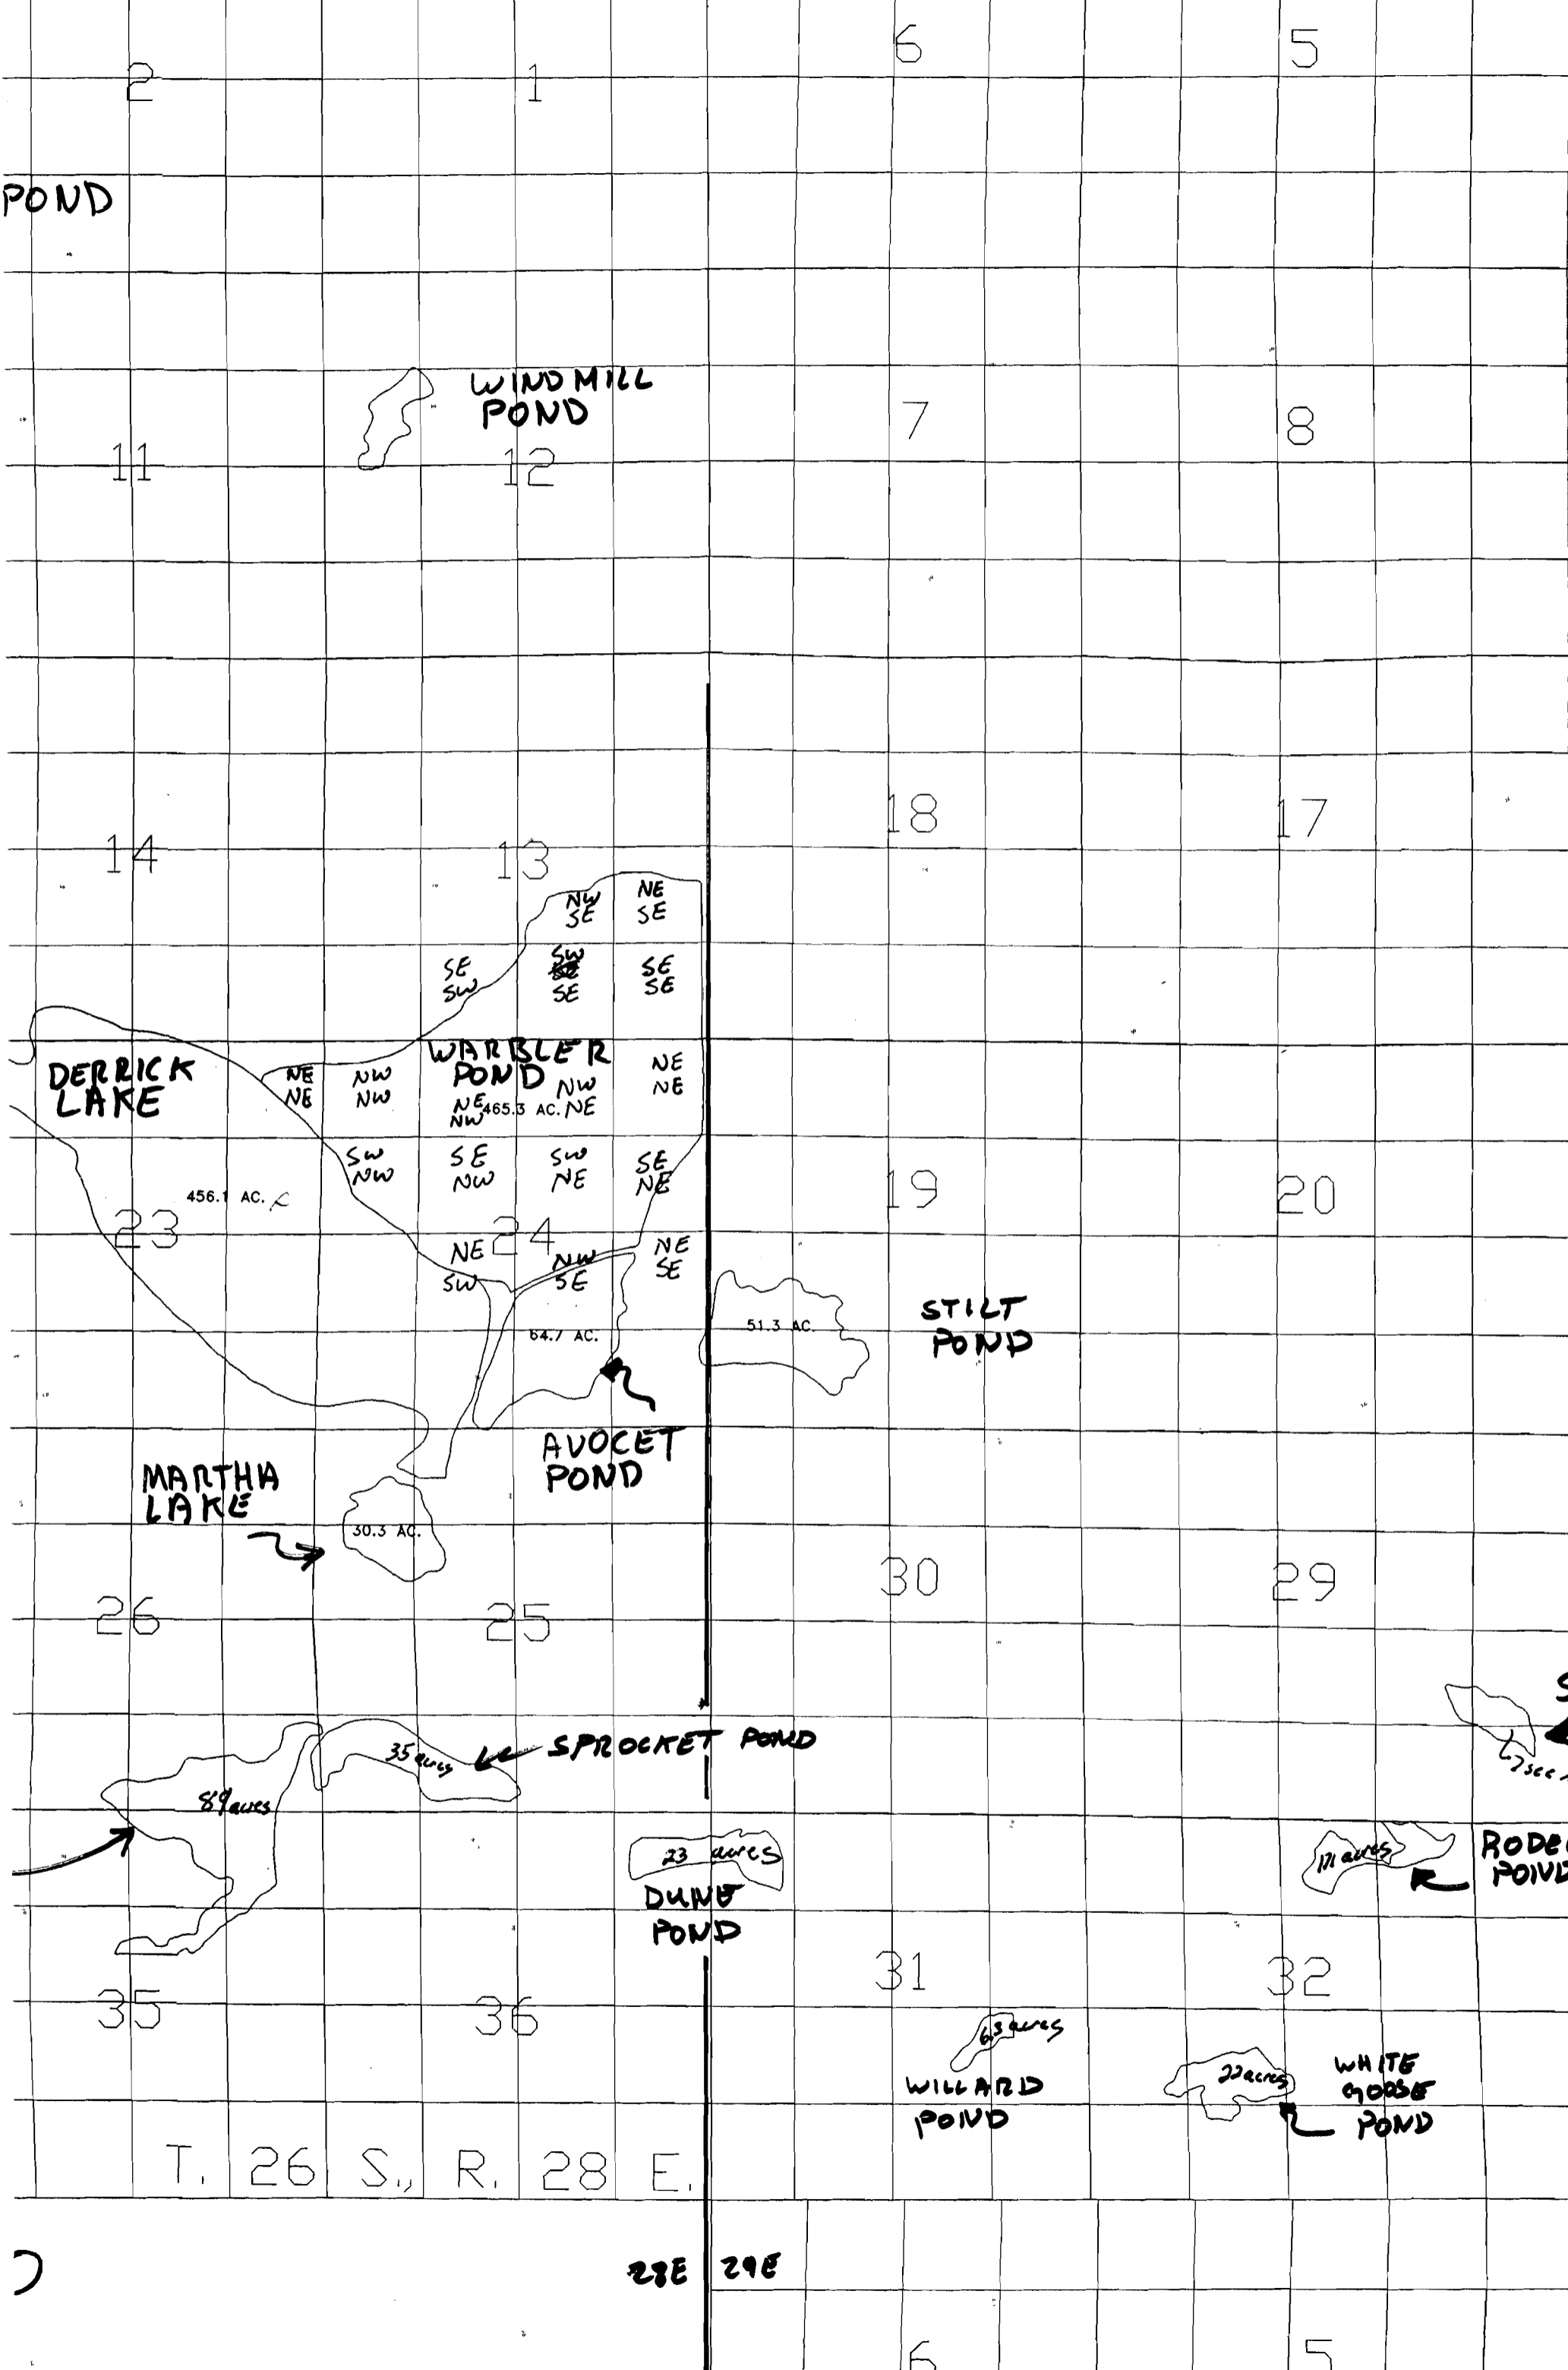

T. 26 S., R. 28 E.

28E 29E

2

6

5