

SEE MAP
2N 3 16

SEE MAP
2N 3

FOR ASSE
PURPOSES
DO NOT R
FOR ANY

EF DAIRY
-3000480080

70-2 AND OR 70-3

70496

Application No.
Permit No.

SEE MAP
2N 3 22

2N

F-2-217
4-1-7
SHE SEC. 21


22
Rm
10.05

3.4 Ac.
IN 2N3W22

P 19067
12-12-49

P. 30018
9-10-54

P. 22536
7/20/53

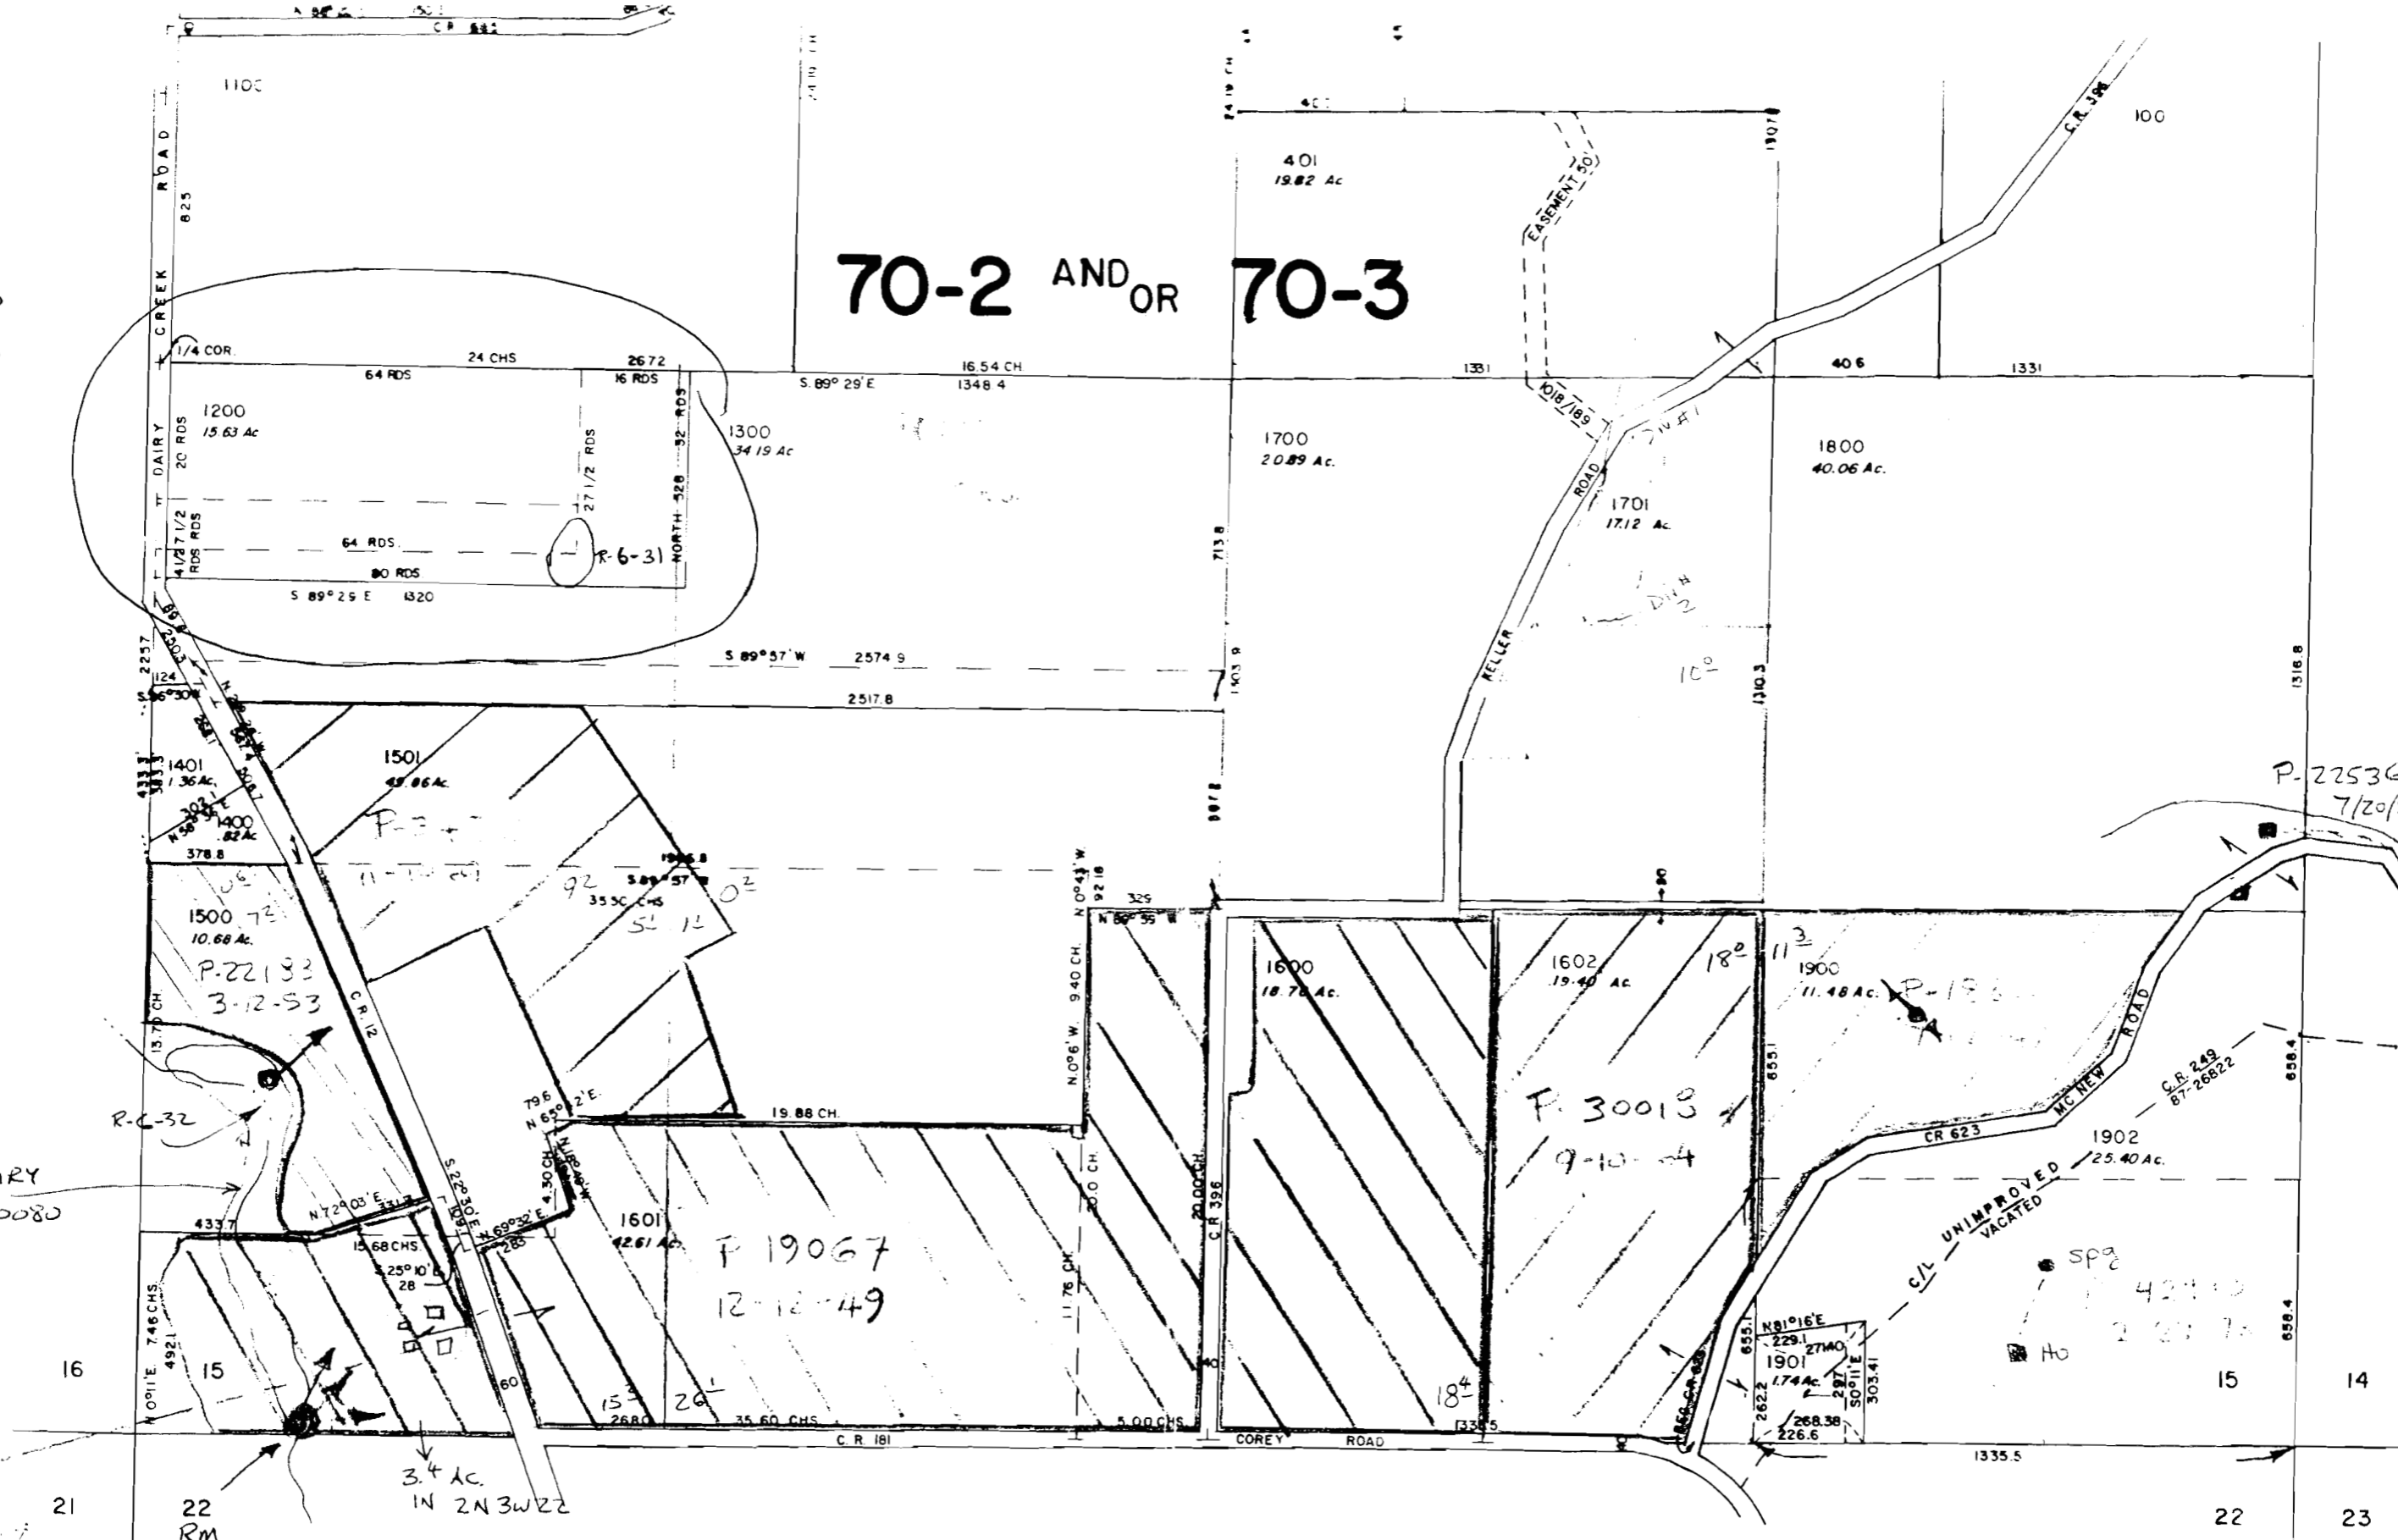

No Final Proof Map available

No Permit Map available