


Application No. R-76570
Permit No.

RECEIVED
3 1994
WATER RESOURCES DEPT
OREGON

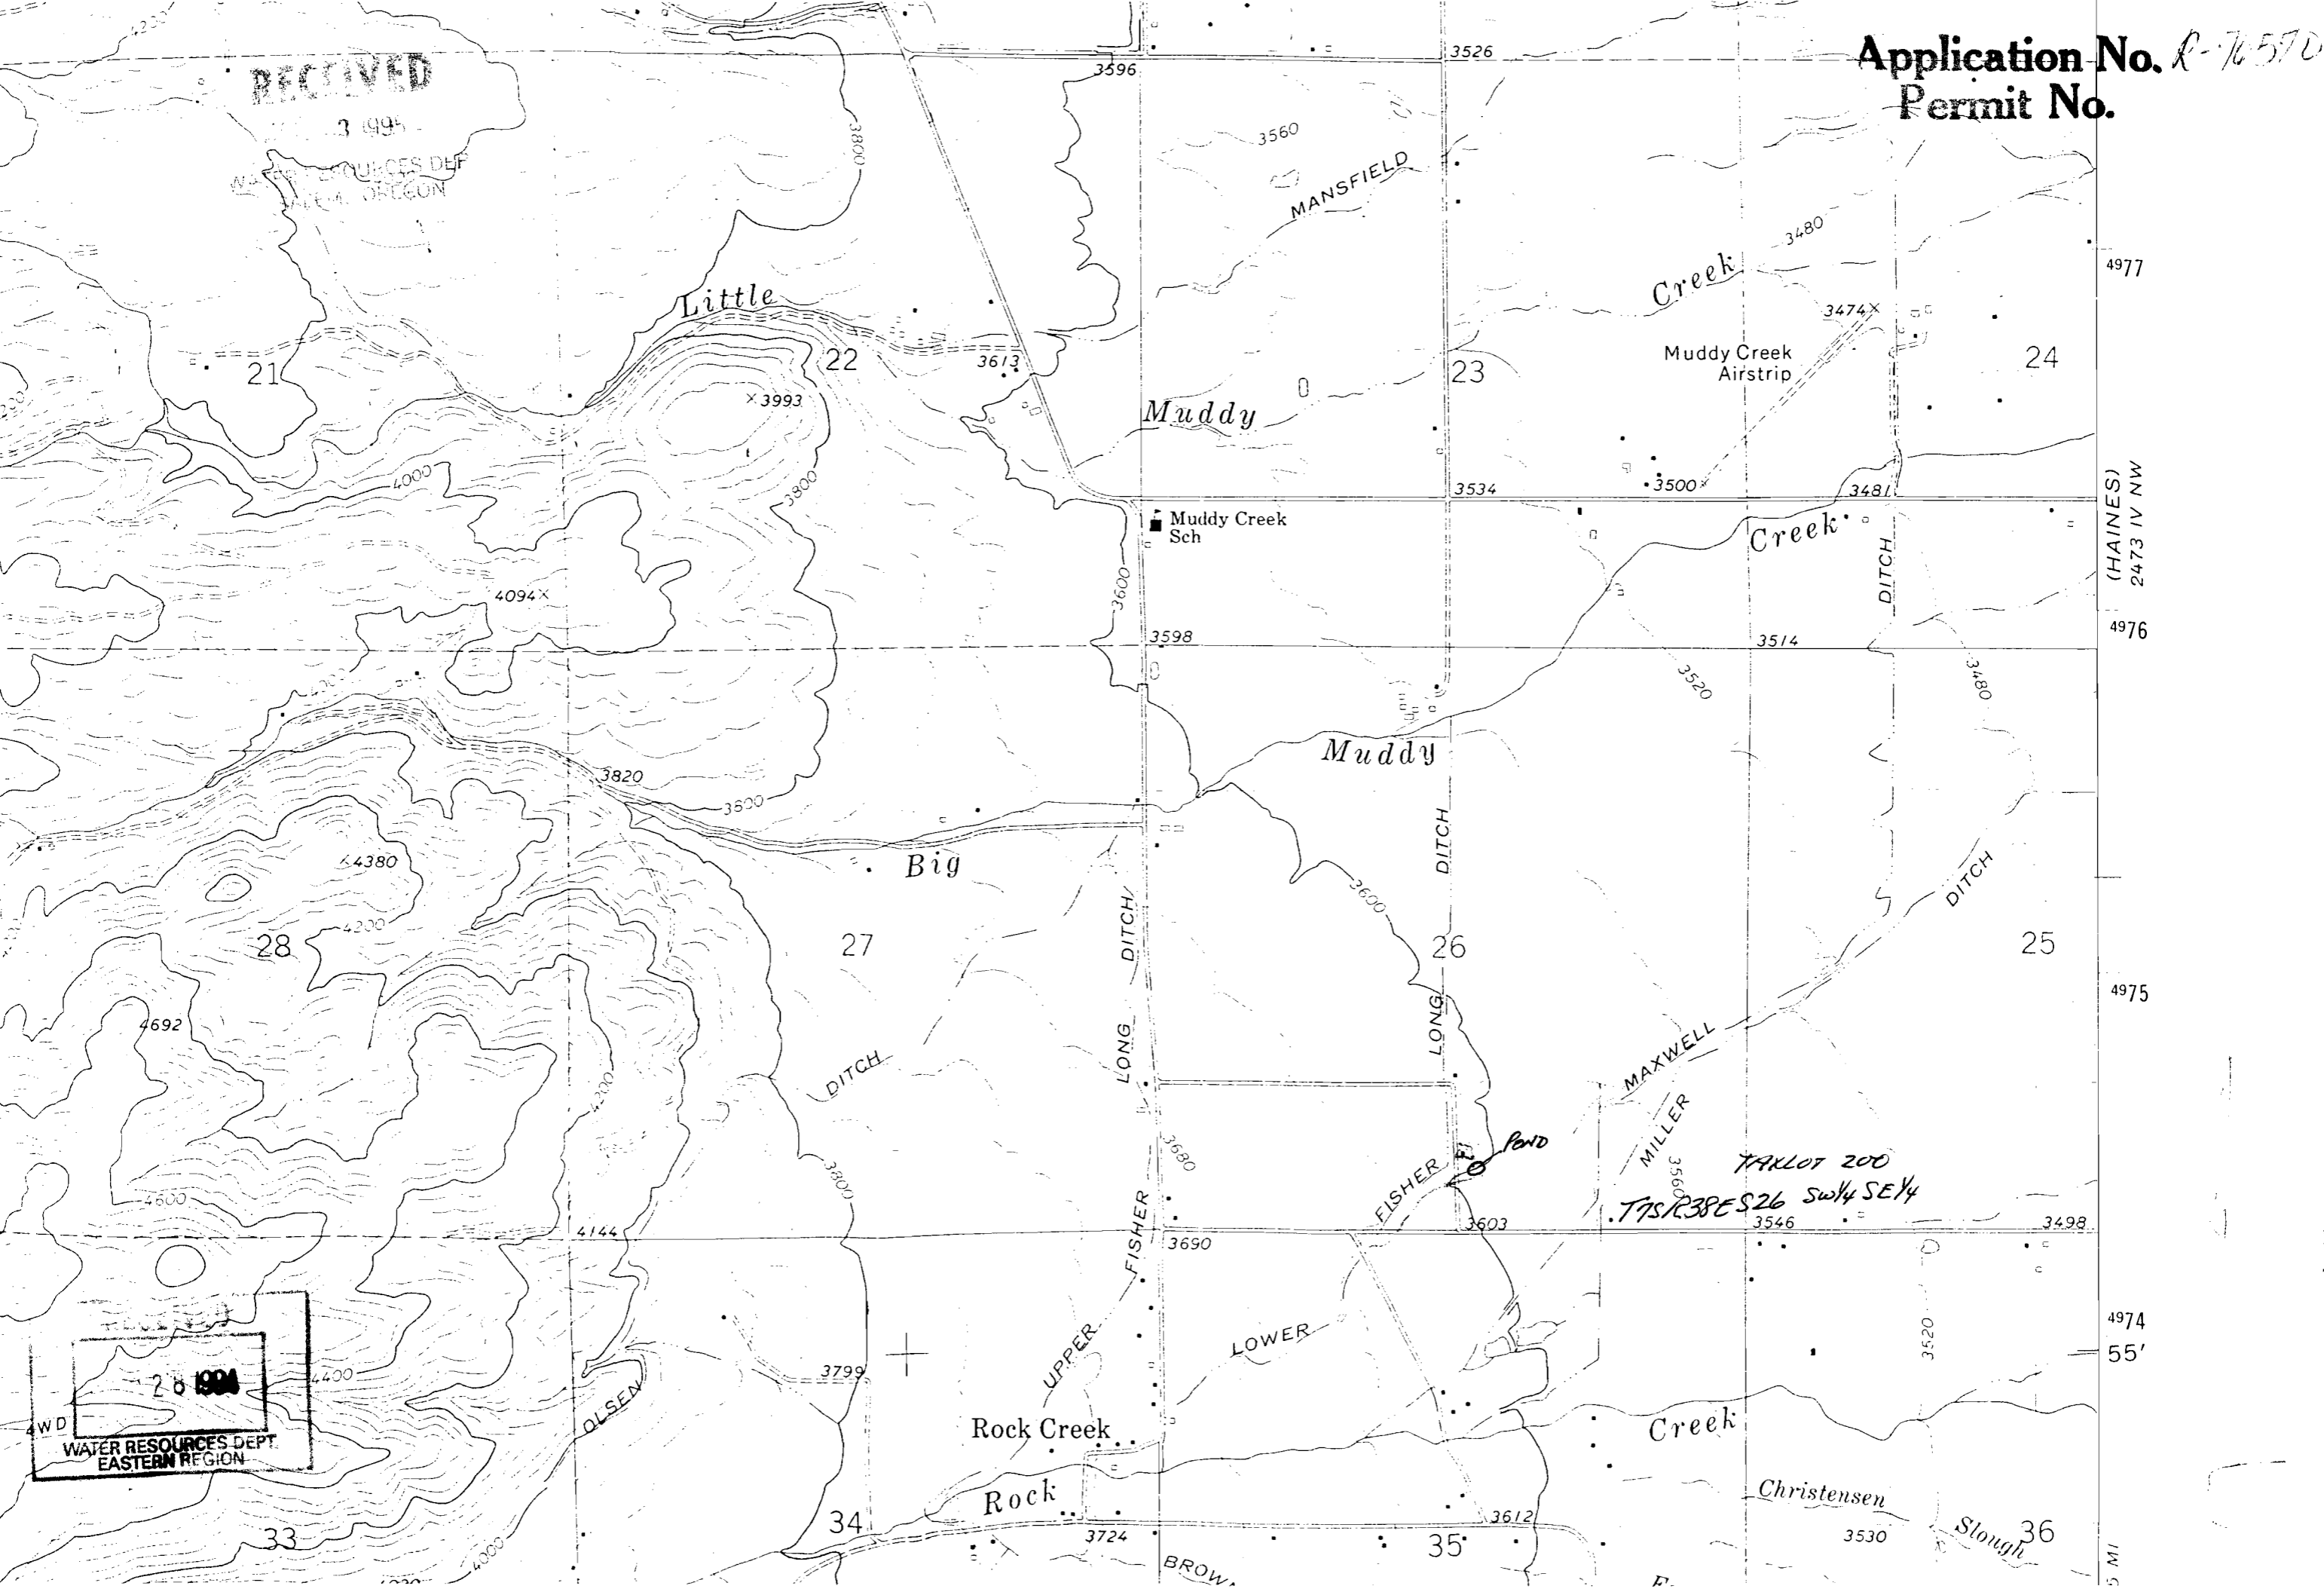

4977
4976
4975
4974
55'
5 MI

26 1994
WATER RESOURCES DEPT
EASTERN REGION

TAKLOT 200
T75R238E S26 SW 1/4 SE 1/4

BROW