

NW 1/4


T.I.N.R. 3, 4 W.W.M.

Tax Lot 100

RECEIVED

JAN - 3 1995

WATER RESOURCES DIVISION
SALEM, OREGON

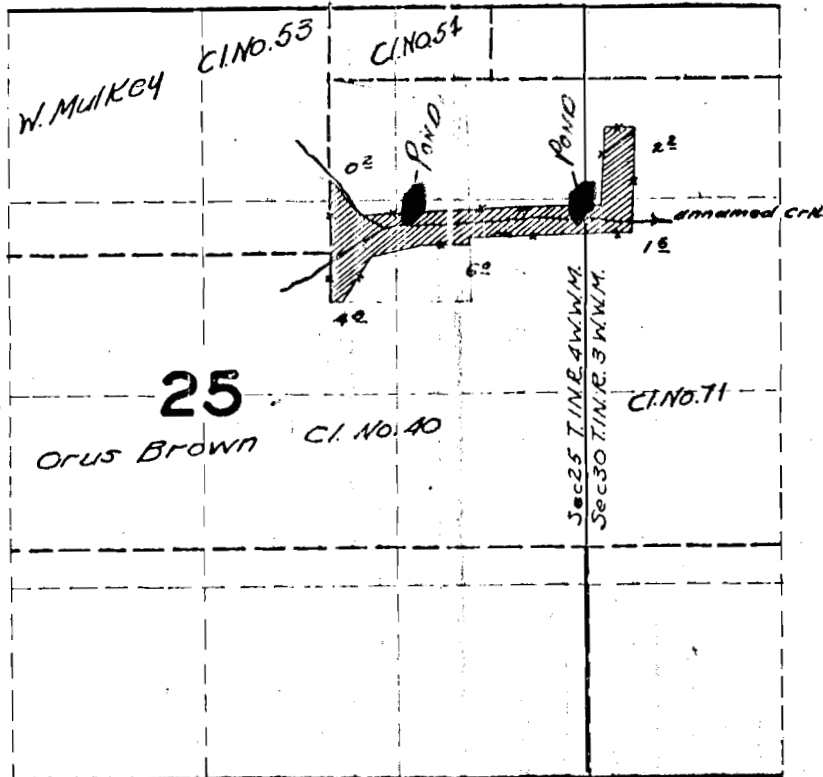

Application No. R-76609
Permit No.

FINAL PROOF SURVEY
UNDER

Application No. 23223 Permit No. 18900
IN NAME OF

GEORGE SPIESSCHLERT & F. A. VANAKEN

Surveyed 4 / 23 19 52, by H. L. COFFMAN

