

SECTION 34 T1N R3W W.M.

WASHINGTON COUNTY OREGON

SCALE 1"=400'

Application No. *R-11-12*

Permit No.

70565

CERTIFICATE NO. \_\_\_\_\_

28 27

33 34

27 26

34 35

SEE MAP  
IN 3 27

SEE MAP  
IN 3 33


15-23

7-25

7-25

7-18

7-11

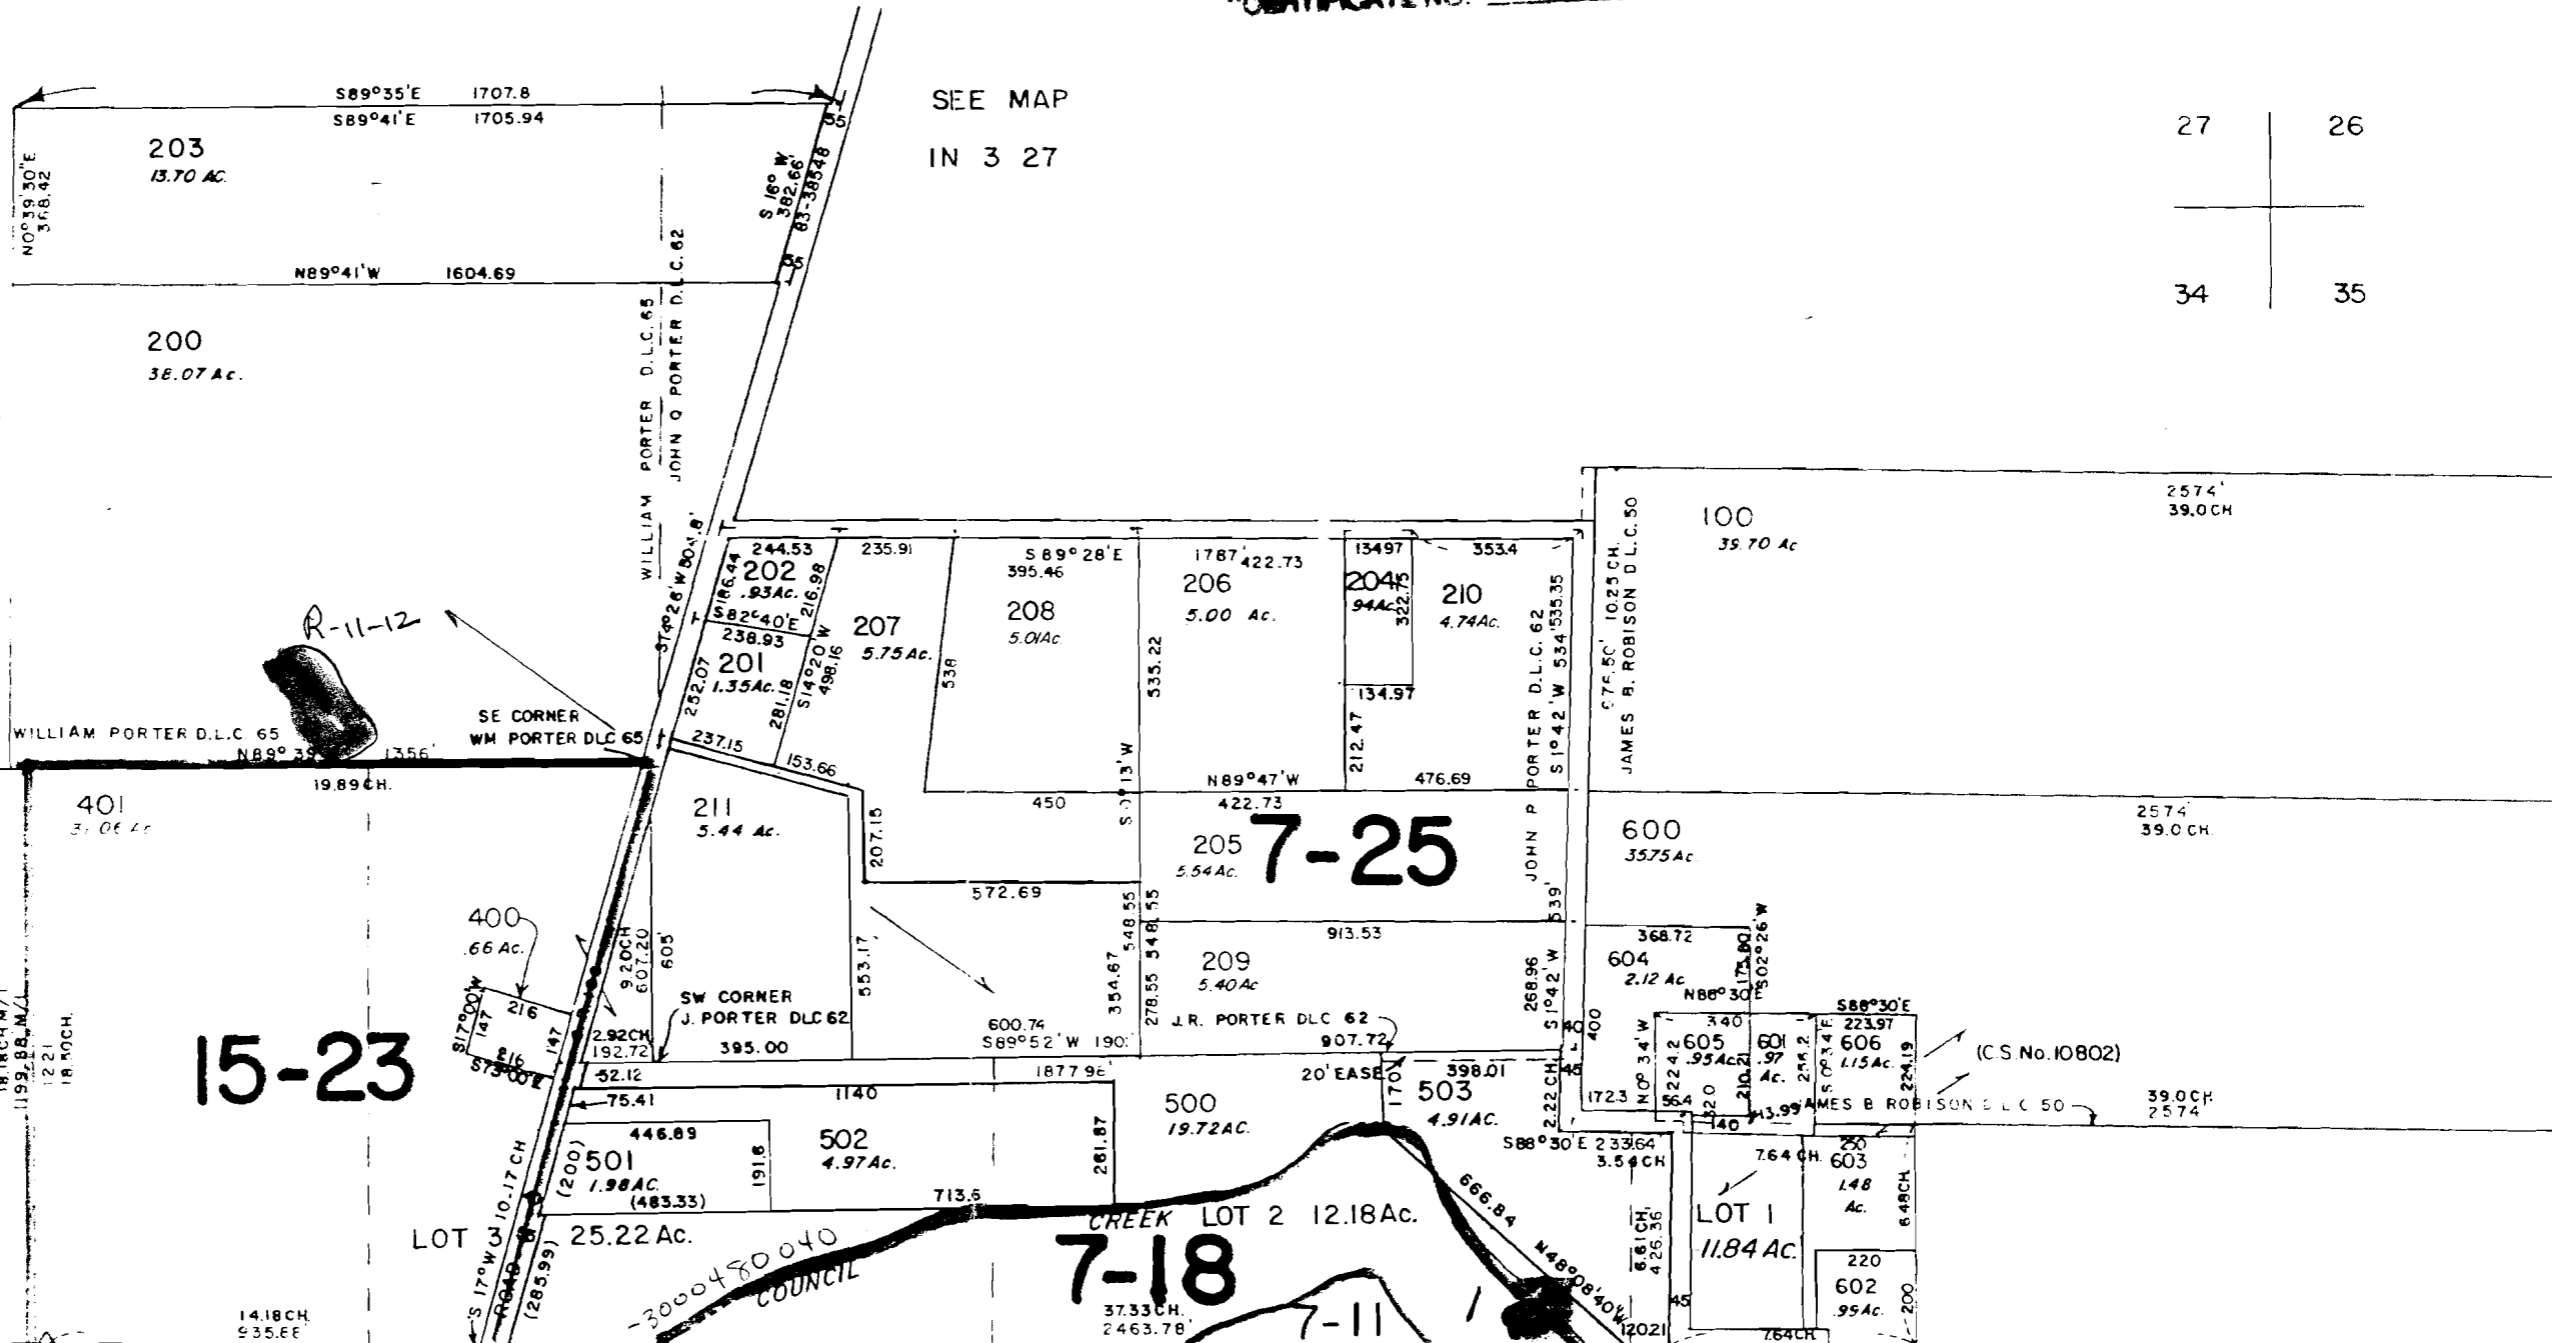

SEE MAP  
IN 3 35

SEE MAP  
IN 3 33DA

SEE MAP  
IN 3 34CB

SEE MAP  
IN 3 34CA

SEE MAP  
IN 3 34D

FOR AS  
PURPOS  
DO NOT