

SECTION 19 T2N R3W W.M.

WASHINGTON COUNTY OREGON

SCALE 1"=400'

Application No. *R-641*
Permit No.

SEE MAP


2N 3 18

CERTIFICATE NO. 70589

CANCE

18

17

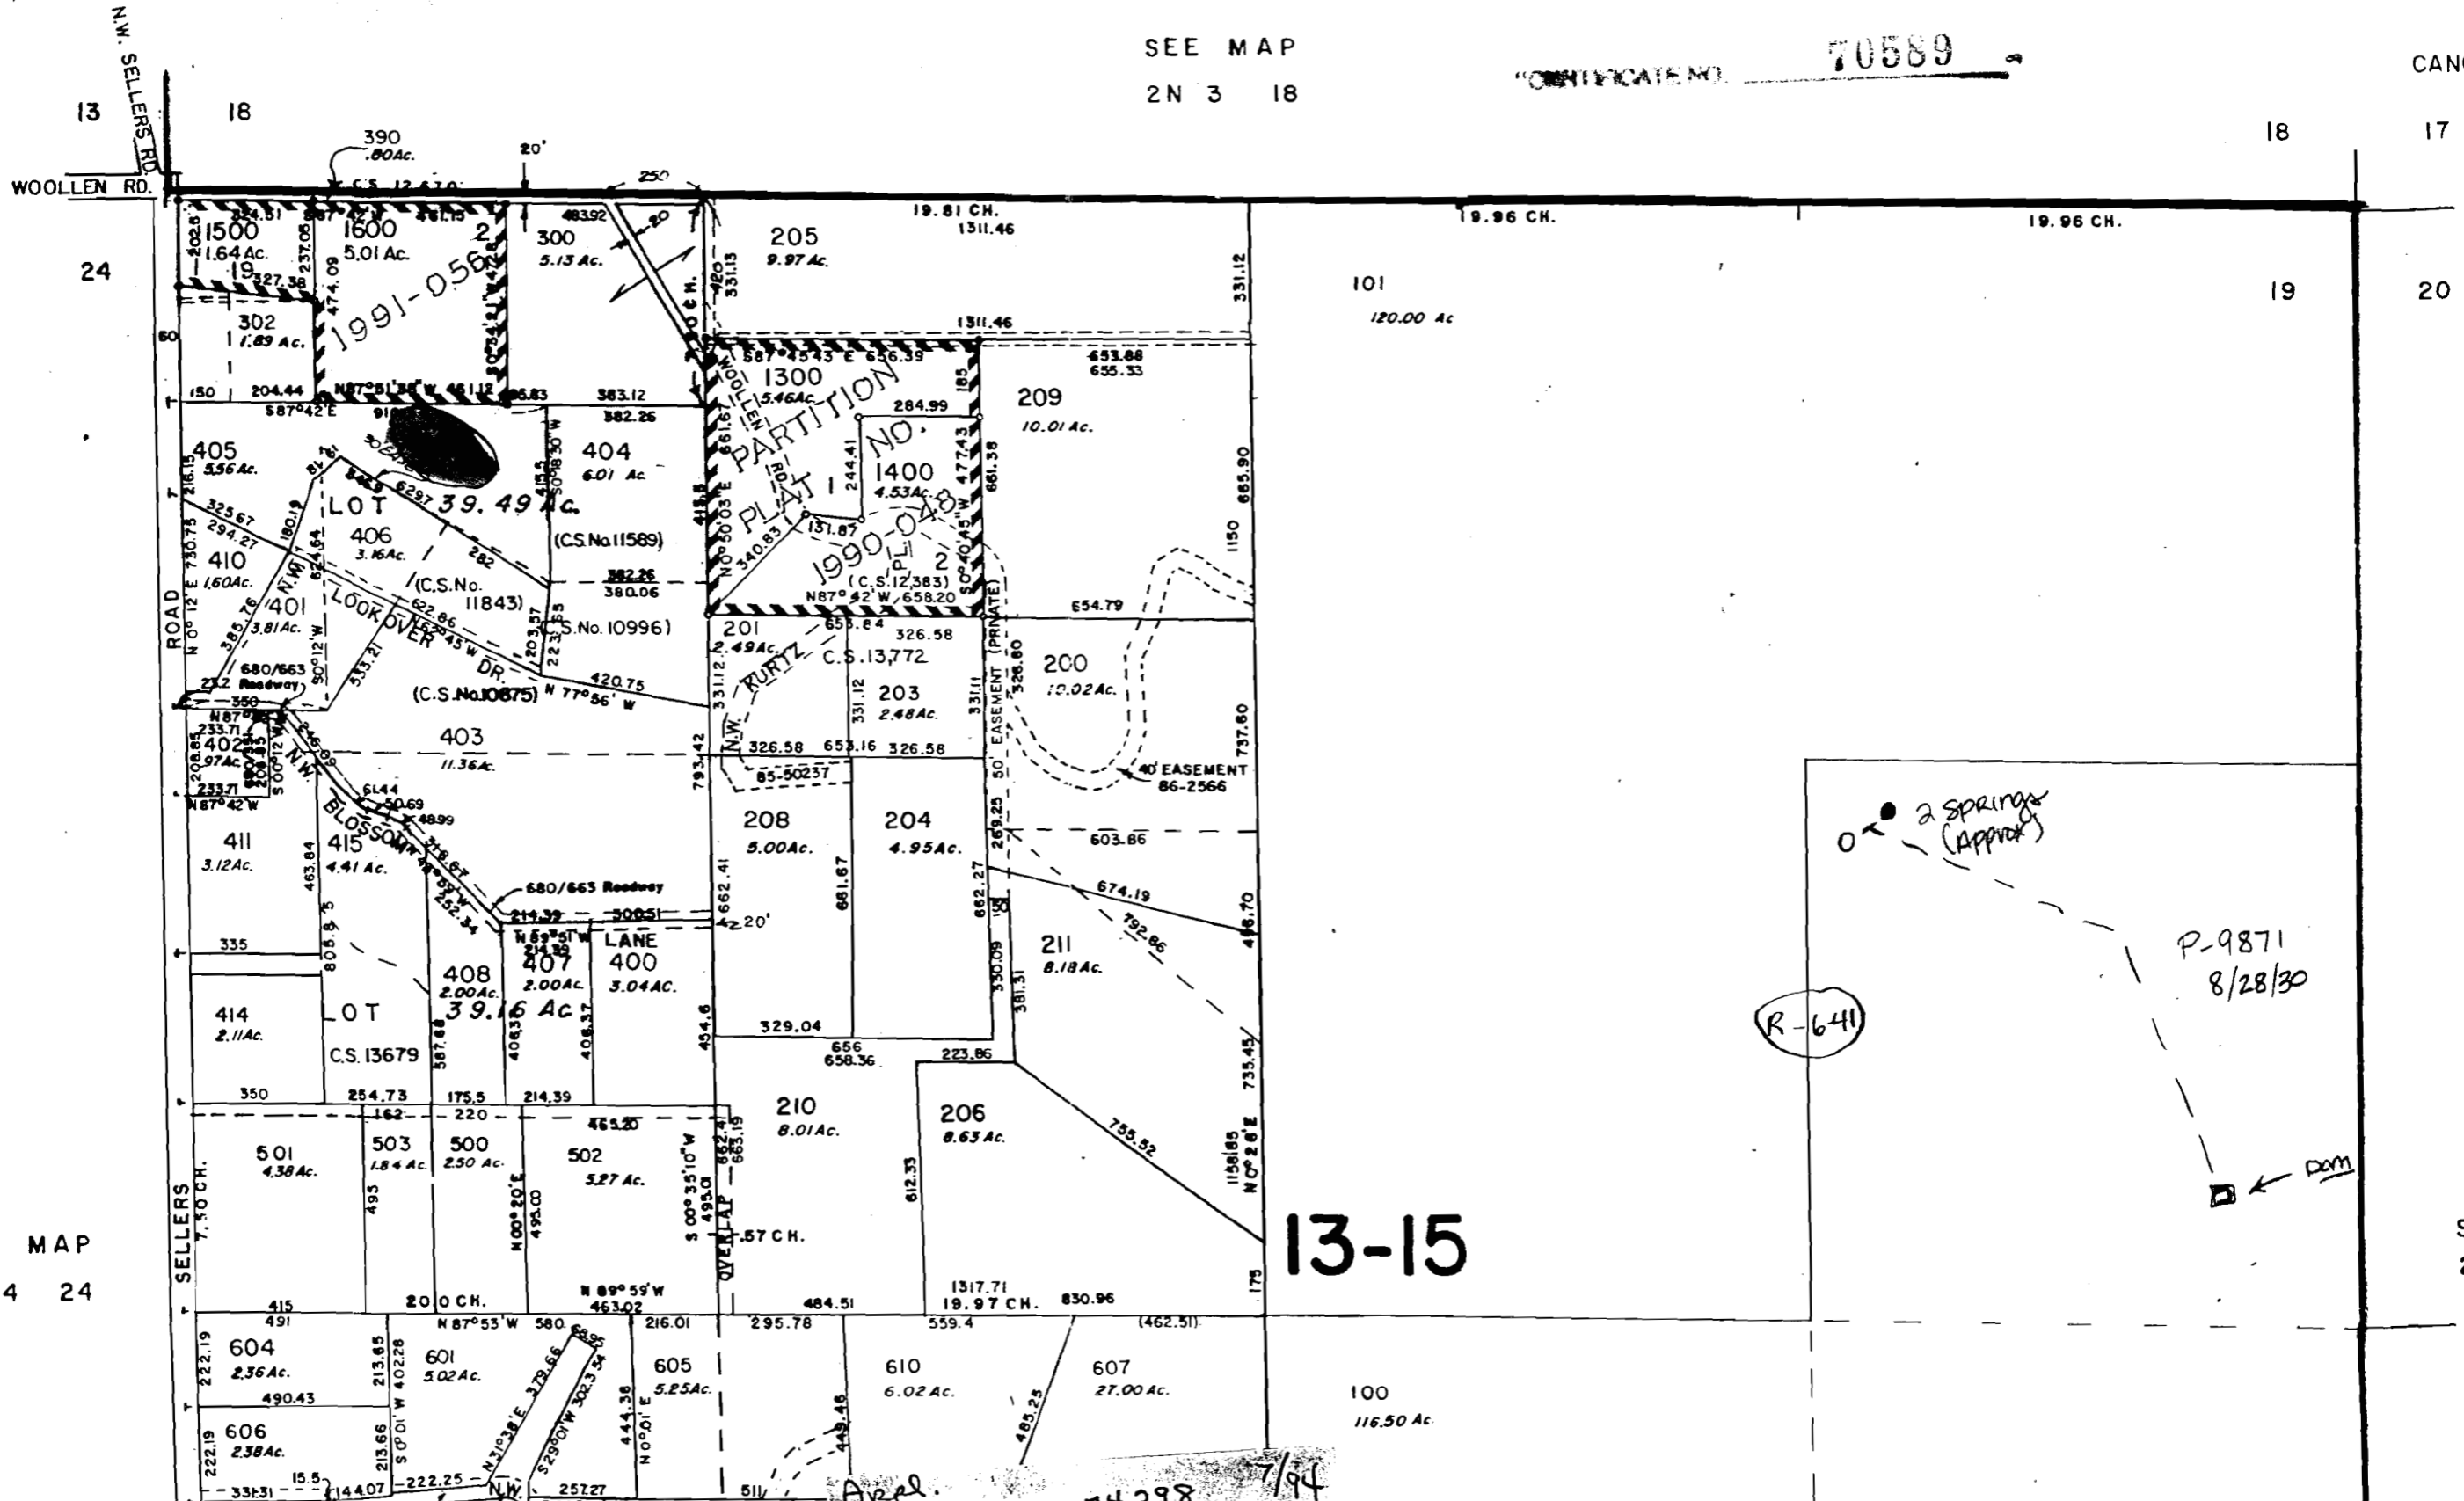

SEE MAP
2N 4 24

13-15

SE
2N