


Work Copy

location of reservoir based on original Application Map. BC 6-12-96

SECTION 23 T1S R3W WM
WASHINGTON COUNTY OREGON
SCALE 1"=400'

1S 3 23

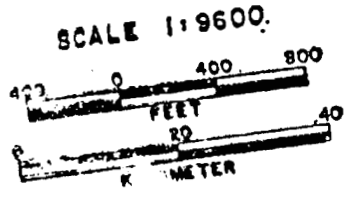

This map was prepared for assessment purposes only.

