

AF-20

70606

RECEIVED  
13-15  
DEC 30 1994  
WATER RESOURCES DEPT  
SALEM, OREGON

E MAP  
4 26DA

MAP  
26DD


26

36

35

AF-20

EFU

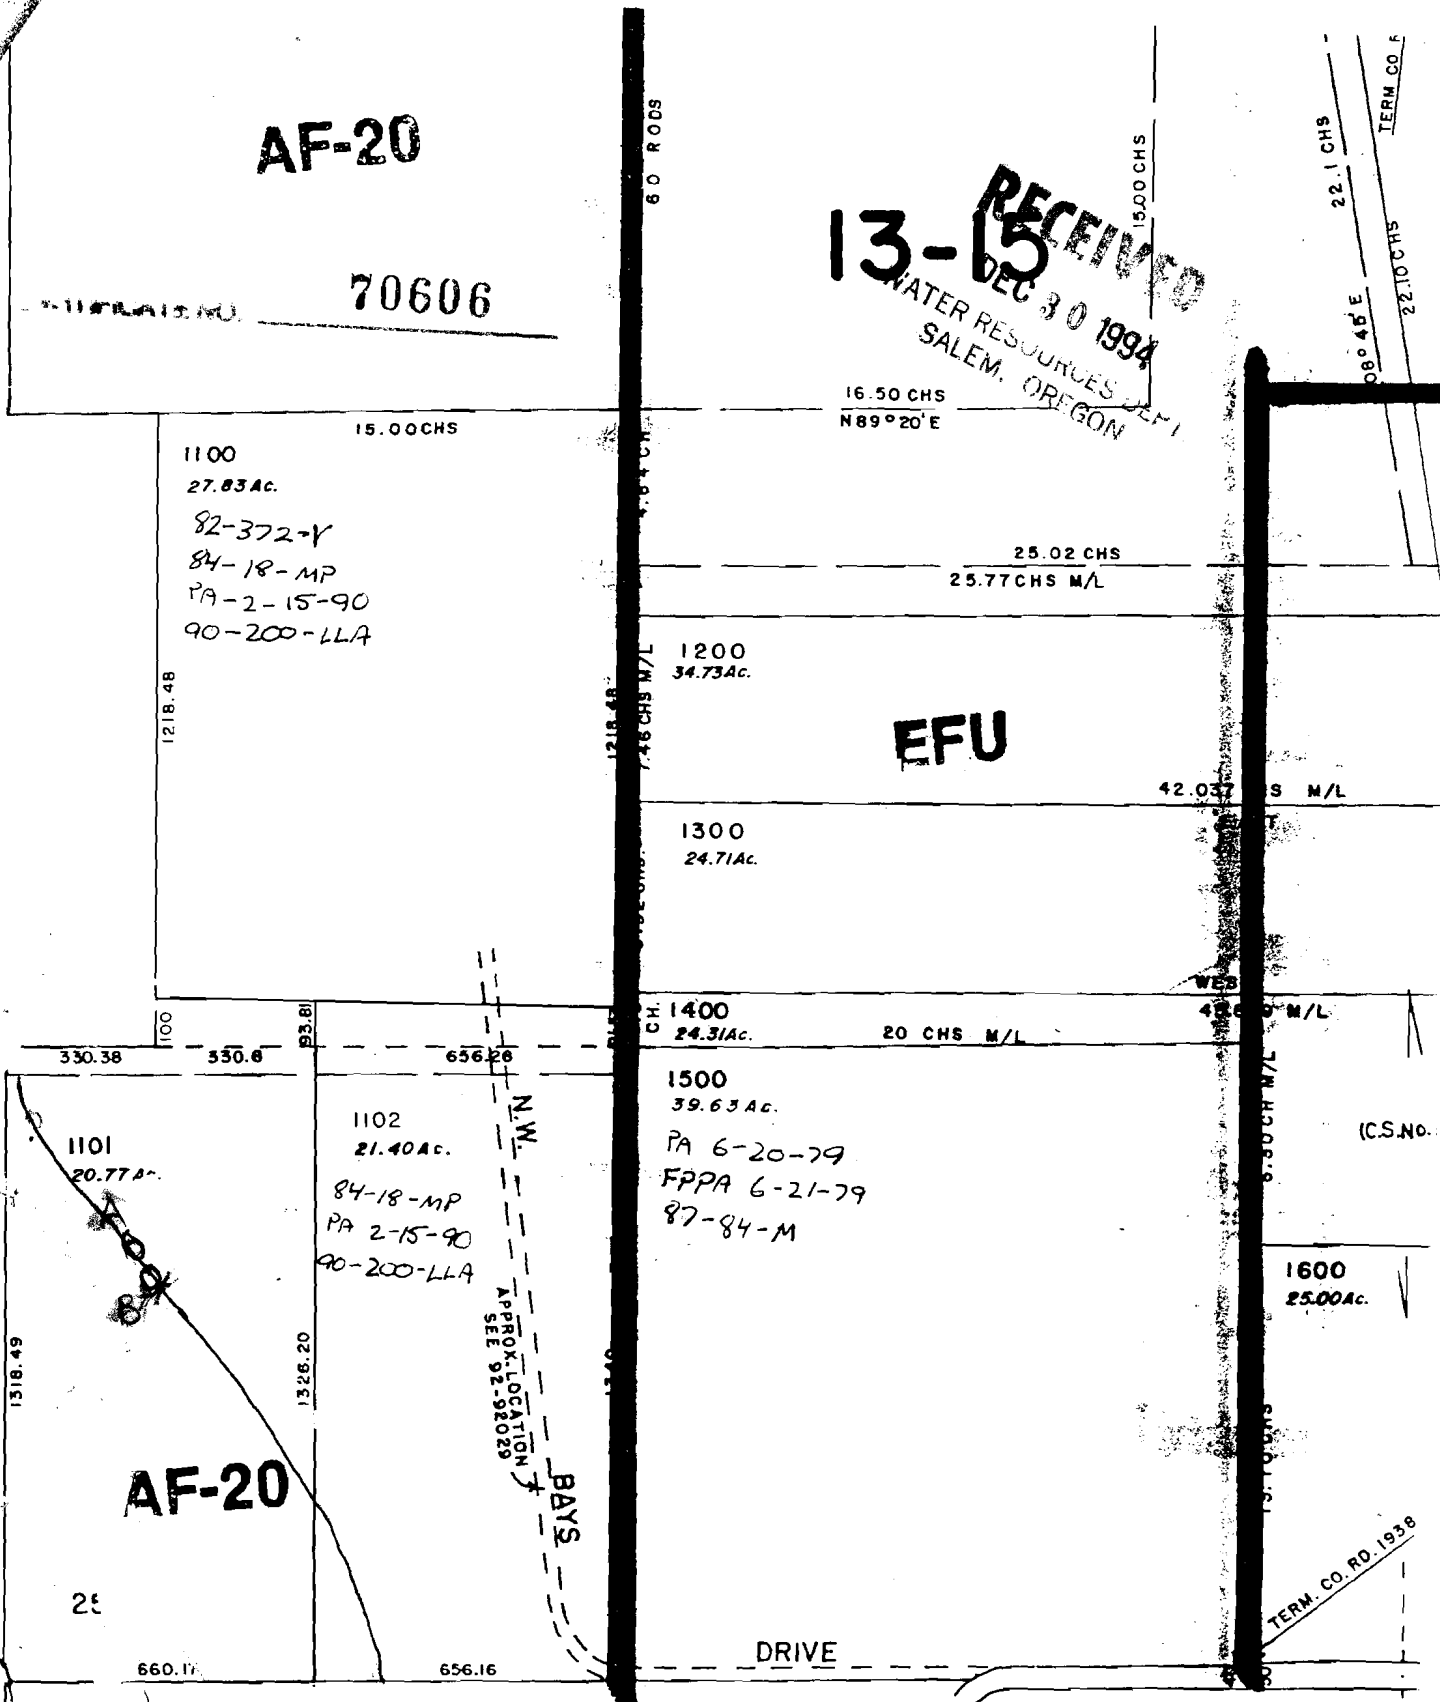

~~25 + 25~~ 1101

Application No. R-76680  
Permit No.

SEE MAP  
2N 4 36