

Application No. *R-76775*
Permit No.

RECEIVED


JAN 1 1995

WATERMASTER
SALMON, OREGON

T.28:3 N.R.3 W.W.M.

70697

32

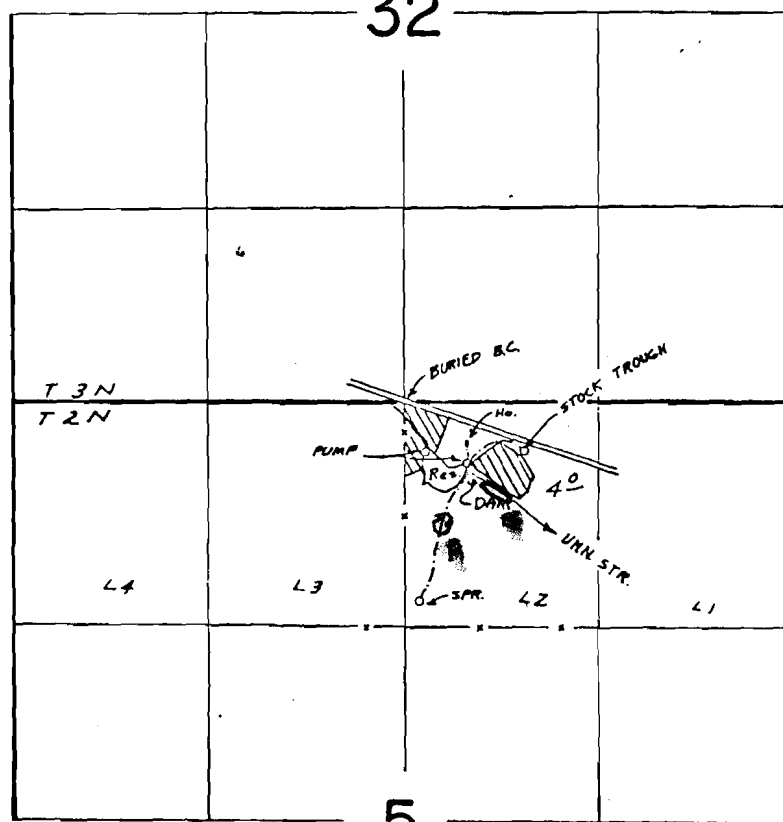

RECEIVED

JAN 03 1995

WATERMASTER
HILLSBORO, OR

DAM 430' S & 420' E, SPRING 1350' S & 100' E FROM N¹/₄ COR. SEC. 5

FINAL PROOF SURVEY
UNDER

48880 36329
Application No. *R-48673* Permit No. *R-5879*
IN NAME OF

THOMAS W. MASON

Surveyed *JUN 26* 19*73*, by *R.G. MUCKEN*