


Application No. R-76795
Permit No.

2N 33 - 00/00

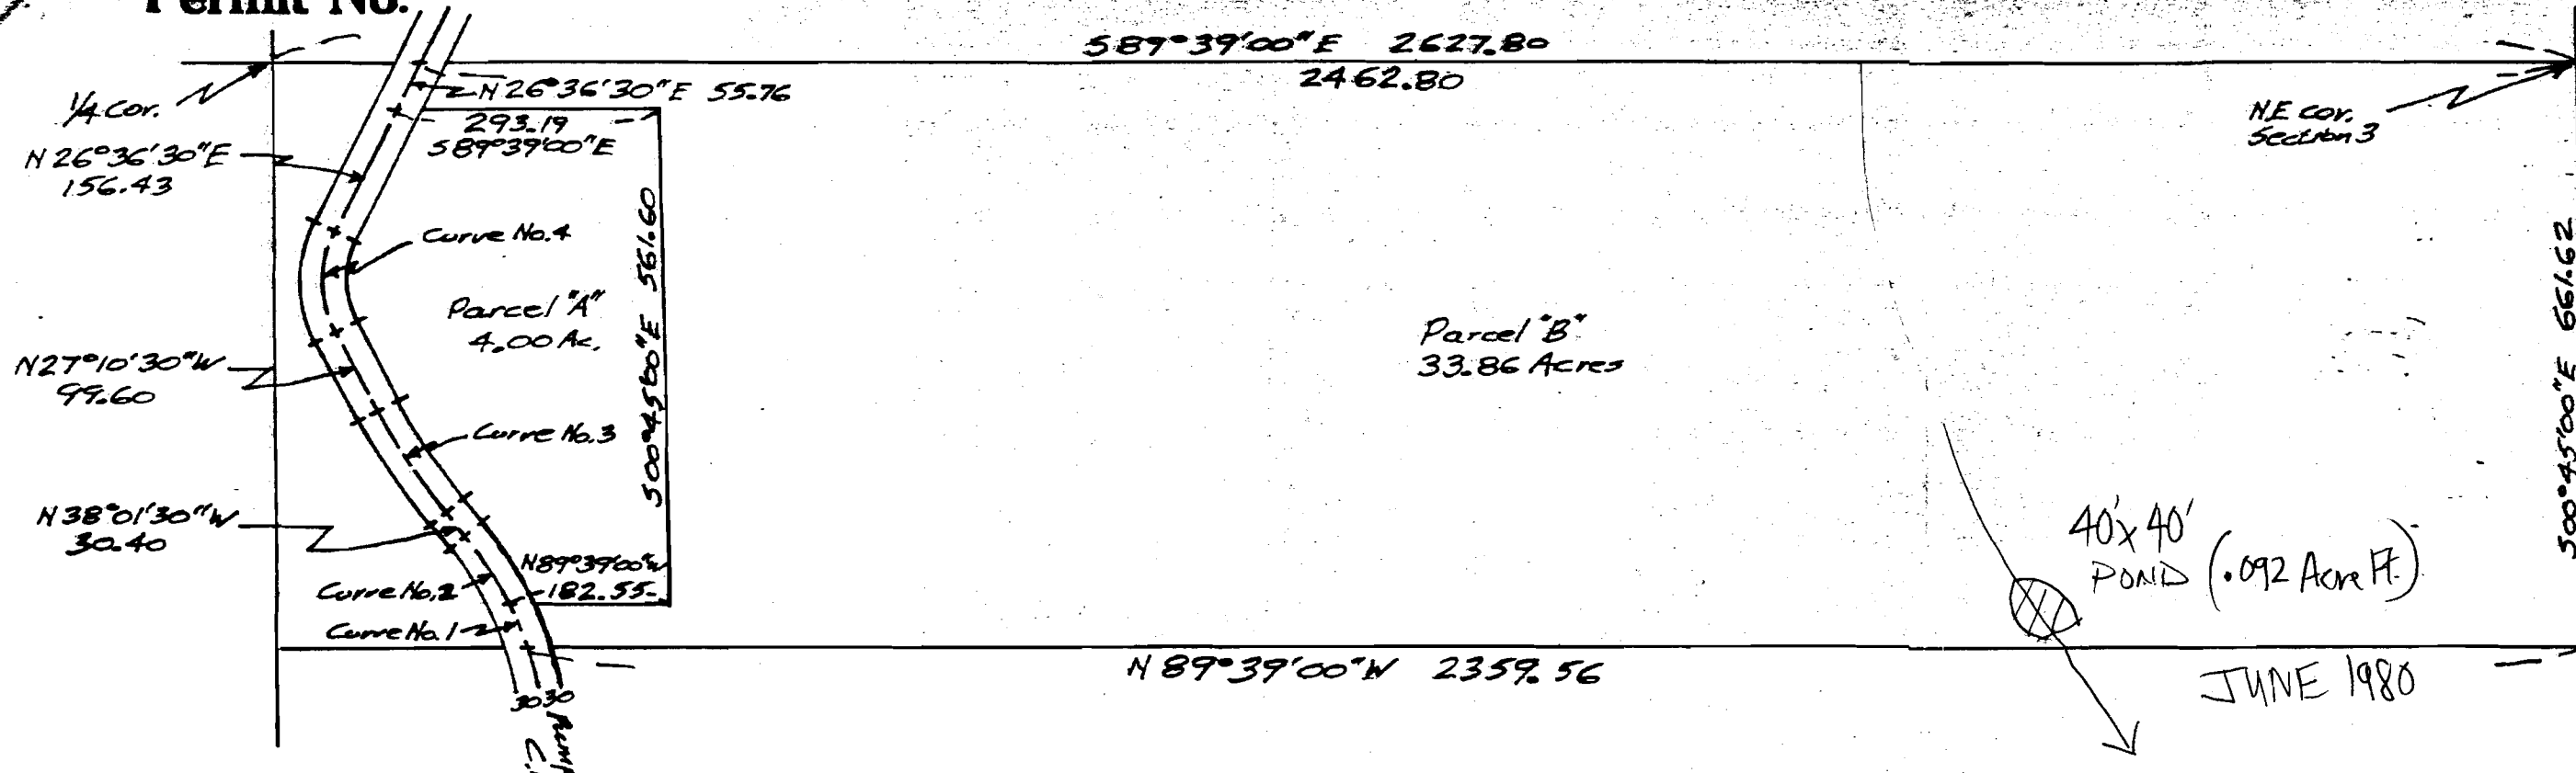

Curve No. 1
Δ = 07°30'11"
R = 409.26
L = 53.60
LC = 53.56
N 20°38'51"W

Curve No. 2
Δ = 13°37'33"
R = 409.26
L = 97.33
LC = 97.10
N 31°12'44"W

Curve No. 3
Δ = 10°51'00"
R = 716.20
L = 135.62
LC = 135.42
N 32°36'00"W

Curve No. 4
Δ = 53°47'00"
R = 124.56
L = 116.92
LC = 112.68
N 00°17'00"W

CERTIFICATE NO. 70714

References: C.S. No. 4353 and C.S. No. 13,627

BANCROFT, 