


Application No. *R-70869*

Permit No.

CERTIFICATE NO. 70784

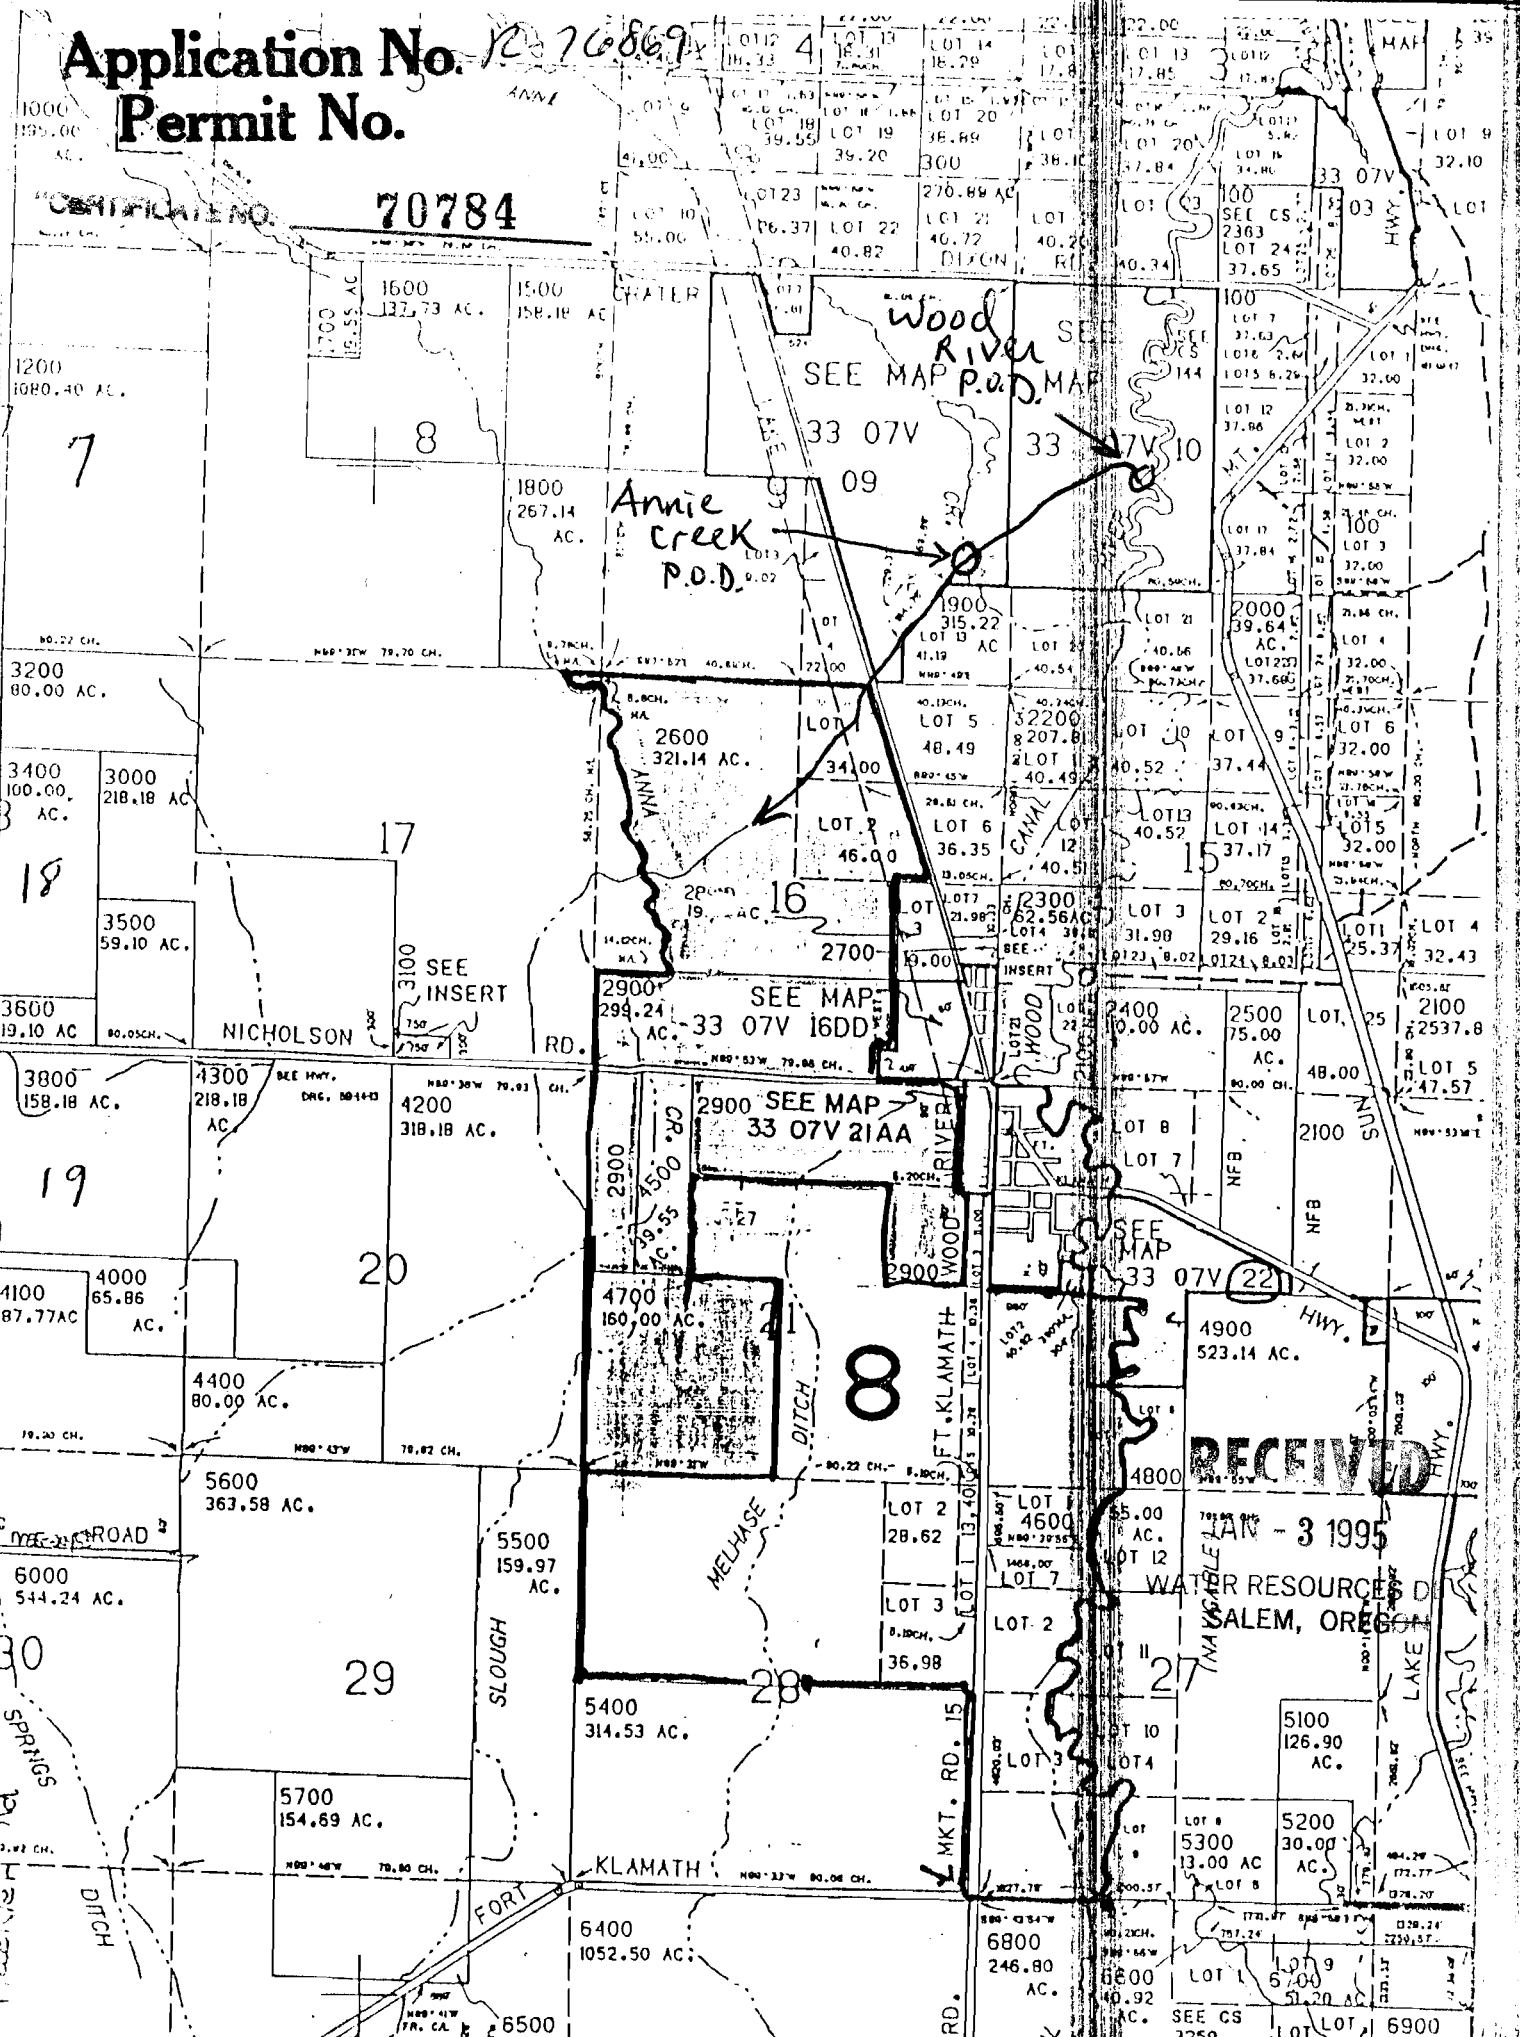

RECEIVED

JAN - 3 1995

WATER RESOURCES DIVISION  
SALEM, OREGON

Wood River SE  
SEE MAP P.O.D. MAP

Annie Creek  
P.O.D.

SEE MAP  
33 07V 16DD

SEE MAP  
33 07V 21AA

SEE MAP  
33 07V 22

8

WATER RESOURCES DIVISION  
SALEM, OREGON

5200  
30.00  
AC.

5300  
13.00  
AC

5700  
AC

6900