

HB2153 Application




T. 38 S., R. 5 E., W.M.

DEC 30 1994

WATER RESOURCES DEPT.
SALEM, OREGON


22|23

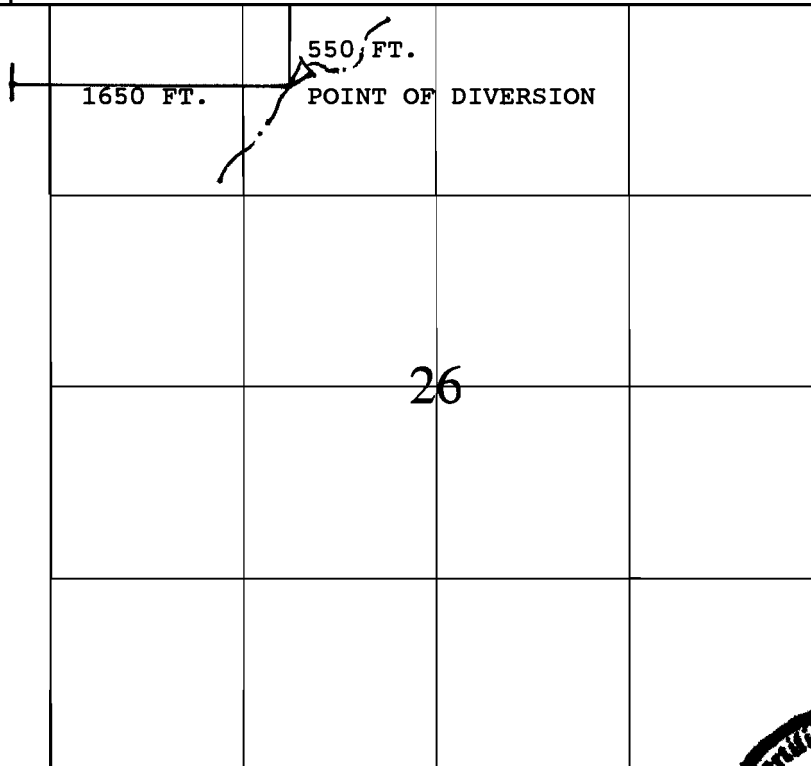

N



1 IN. = 1320 FT.

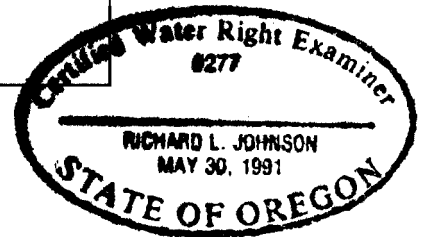

Application No. R-76897 APPLICATION MAP

Permit No. _____ FOR

CERTIFICATE NO. 70006

UNNAMED RESERVOIR, 38S 5E 23 SWSW

IN NAME OF

UNITED STATES BUREAU OF LAND MANAGEMENT

JUNE 20, 1994

THE PURPOSE OF THIS MAP IS FOR IDENTIFYING THE LOCATION OF THE WATER RIGHT ONLY AND IS NOT INTENDED TO PROVIDE LEGAL DIMENSIONS OR LOCATION OF PROPERTY OWNERSHIP LINES.

THE TIE WAS DETERMINED FROM AN INVERSE BETWEEN POSITIONS DERIVED FROM A RESOURCE GRADE GLOBE POSITIONING SYSTEM, A TRIMBLE PATHFINDER, WITH A ACCURACY OF 2-5 METERS, 50 PERCENT OF THE TIME.

WRE 6091A

U.S. BUREAU OF LAND MANAGEMENT - OSO
BRANCH OF CADASTRAL SURVEY

LETTER OF AUTHORIZATION
DATED: MAY 9, 1994

EXECUTED BY:
RICHARD L. JOHNSON, PLS, CWRE

OR-942.1
P.O. BOX 2965
PORTLAND OR., 97208