


RECEIVED



DEC 29 1994

WATER RESOURCES DIV.
SALEM, OREGON

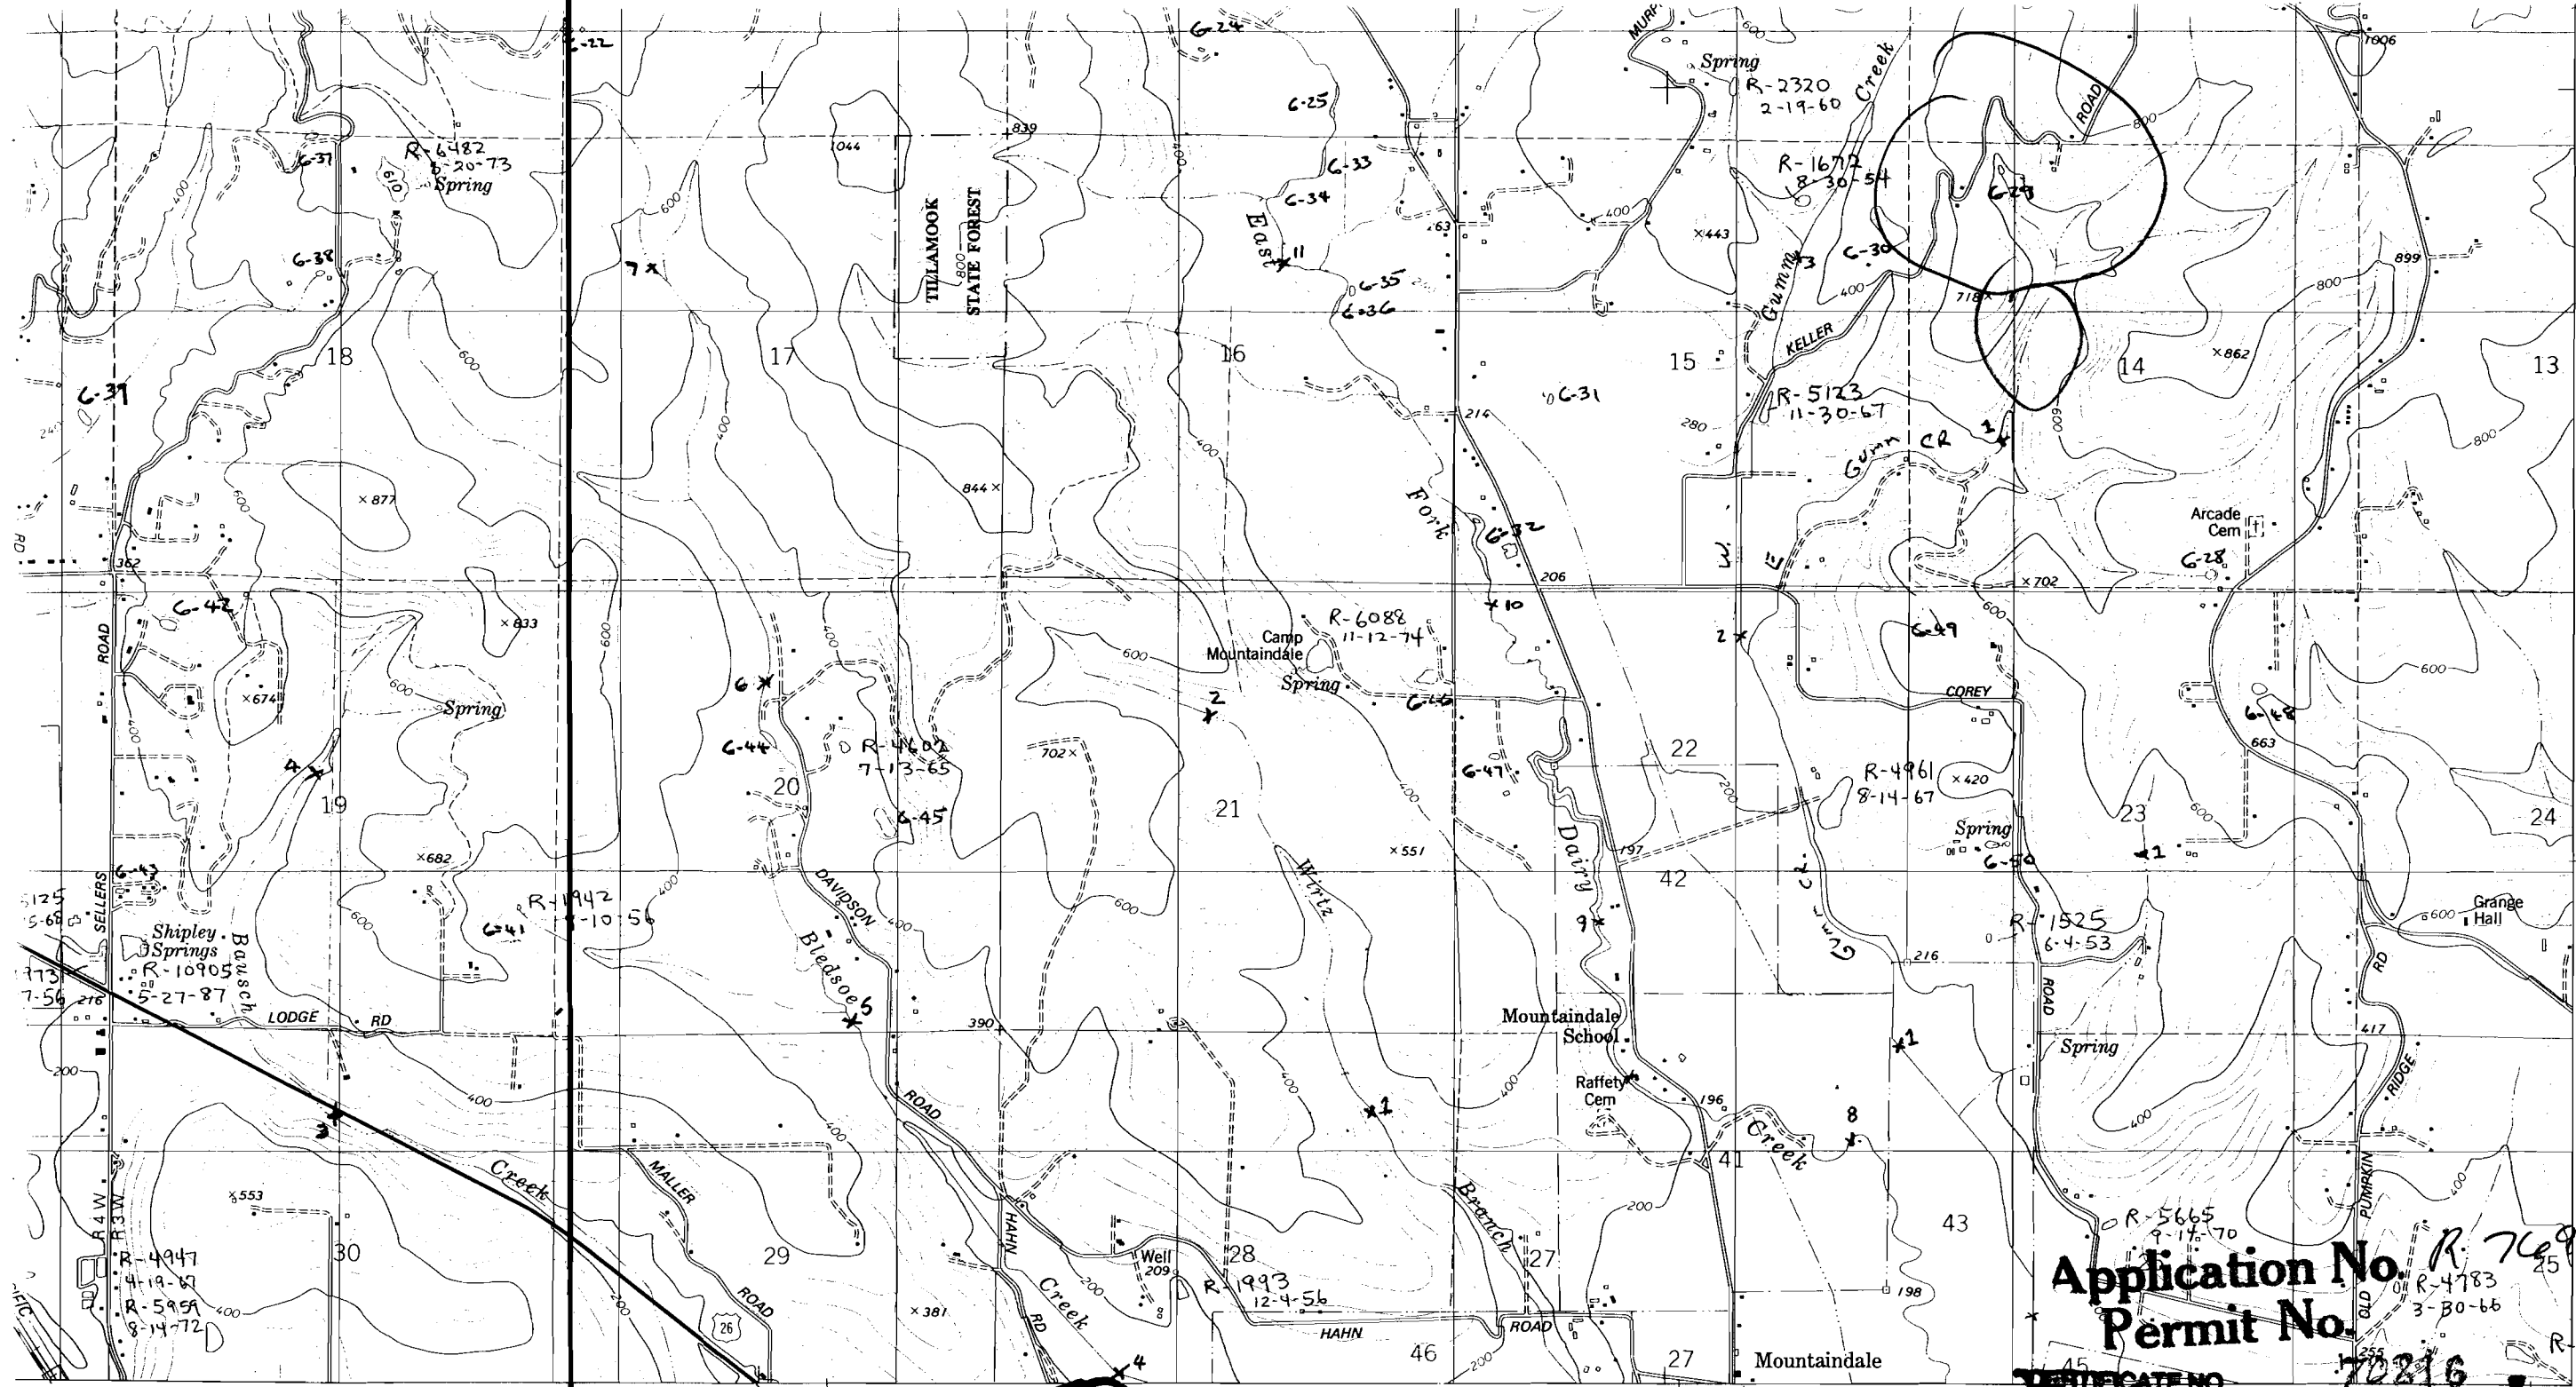

30 000 FEET
FOREST GROVE 7 MI.
, and published by the Geological Survey
id NOS/NOAA
ogrammetric methods from aerial
1973. Field checked 1974. Map edited 1979
00-foot grid ticks: Oregon coordinate
(Lambert conformal conic)
sal Transverse Mercator grid, zone 10
an datum
dicted North American Datum 1983
lines 23 meters north and
shown by dashed corner ticks
e inholdings within the boundaries of
e reservations shown on this map
es indicate selected fence and field lines
ble on aerial photographs
unchecked

UTM GRID AND 1979 MAGNETIC NORTH
DECLINATION A CENTER OF SHEET

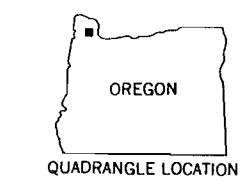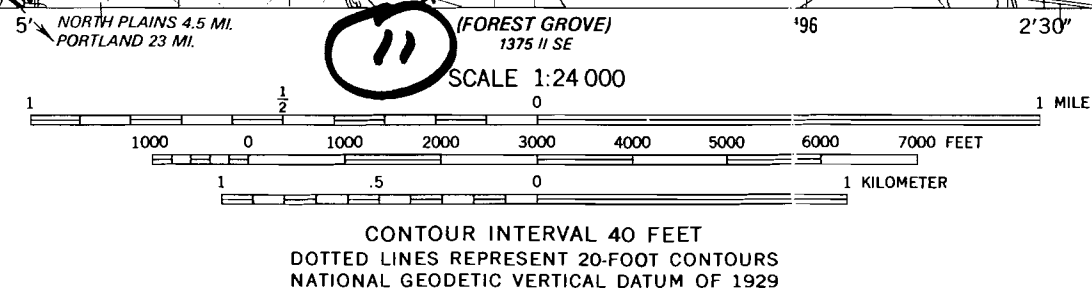

ROAD CLASSIFICATION
Primary highway, _____ Light-duty road, hard or
hard surface _____ improved surface _____
Secondary highway, _____ Unimproved road _____
hard surface _____
○ Interstate Route ○ U. S. Route ○ State Route

MEACHAM CORNER, OREG.
NE/4 FOREST GROVE 15' QUADRANGLE
N4537.5—W12300/7.5

1979

DMA 1375 II NE—SERIES V892

12

6

SECTION 14 T2N R3W W.M.

WASHINGTON COUNTY OREGON

SCALE 1" = 400'

2N 3 14

RECEIVED


DEC 29 1994

WATER RESOURCES DLP
SALEM, OREGON

CERTIFICATE NO. 52016

Application No. R-76907
Permit No.

SEE MAP
2N 3 11

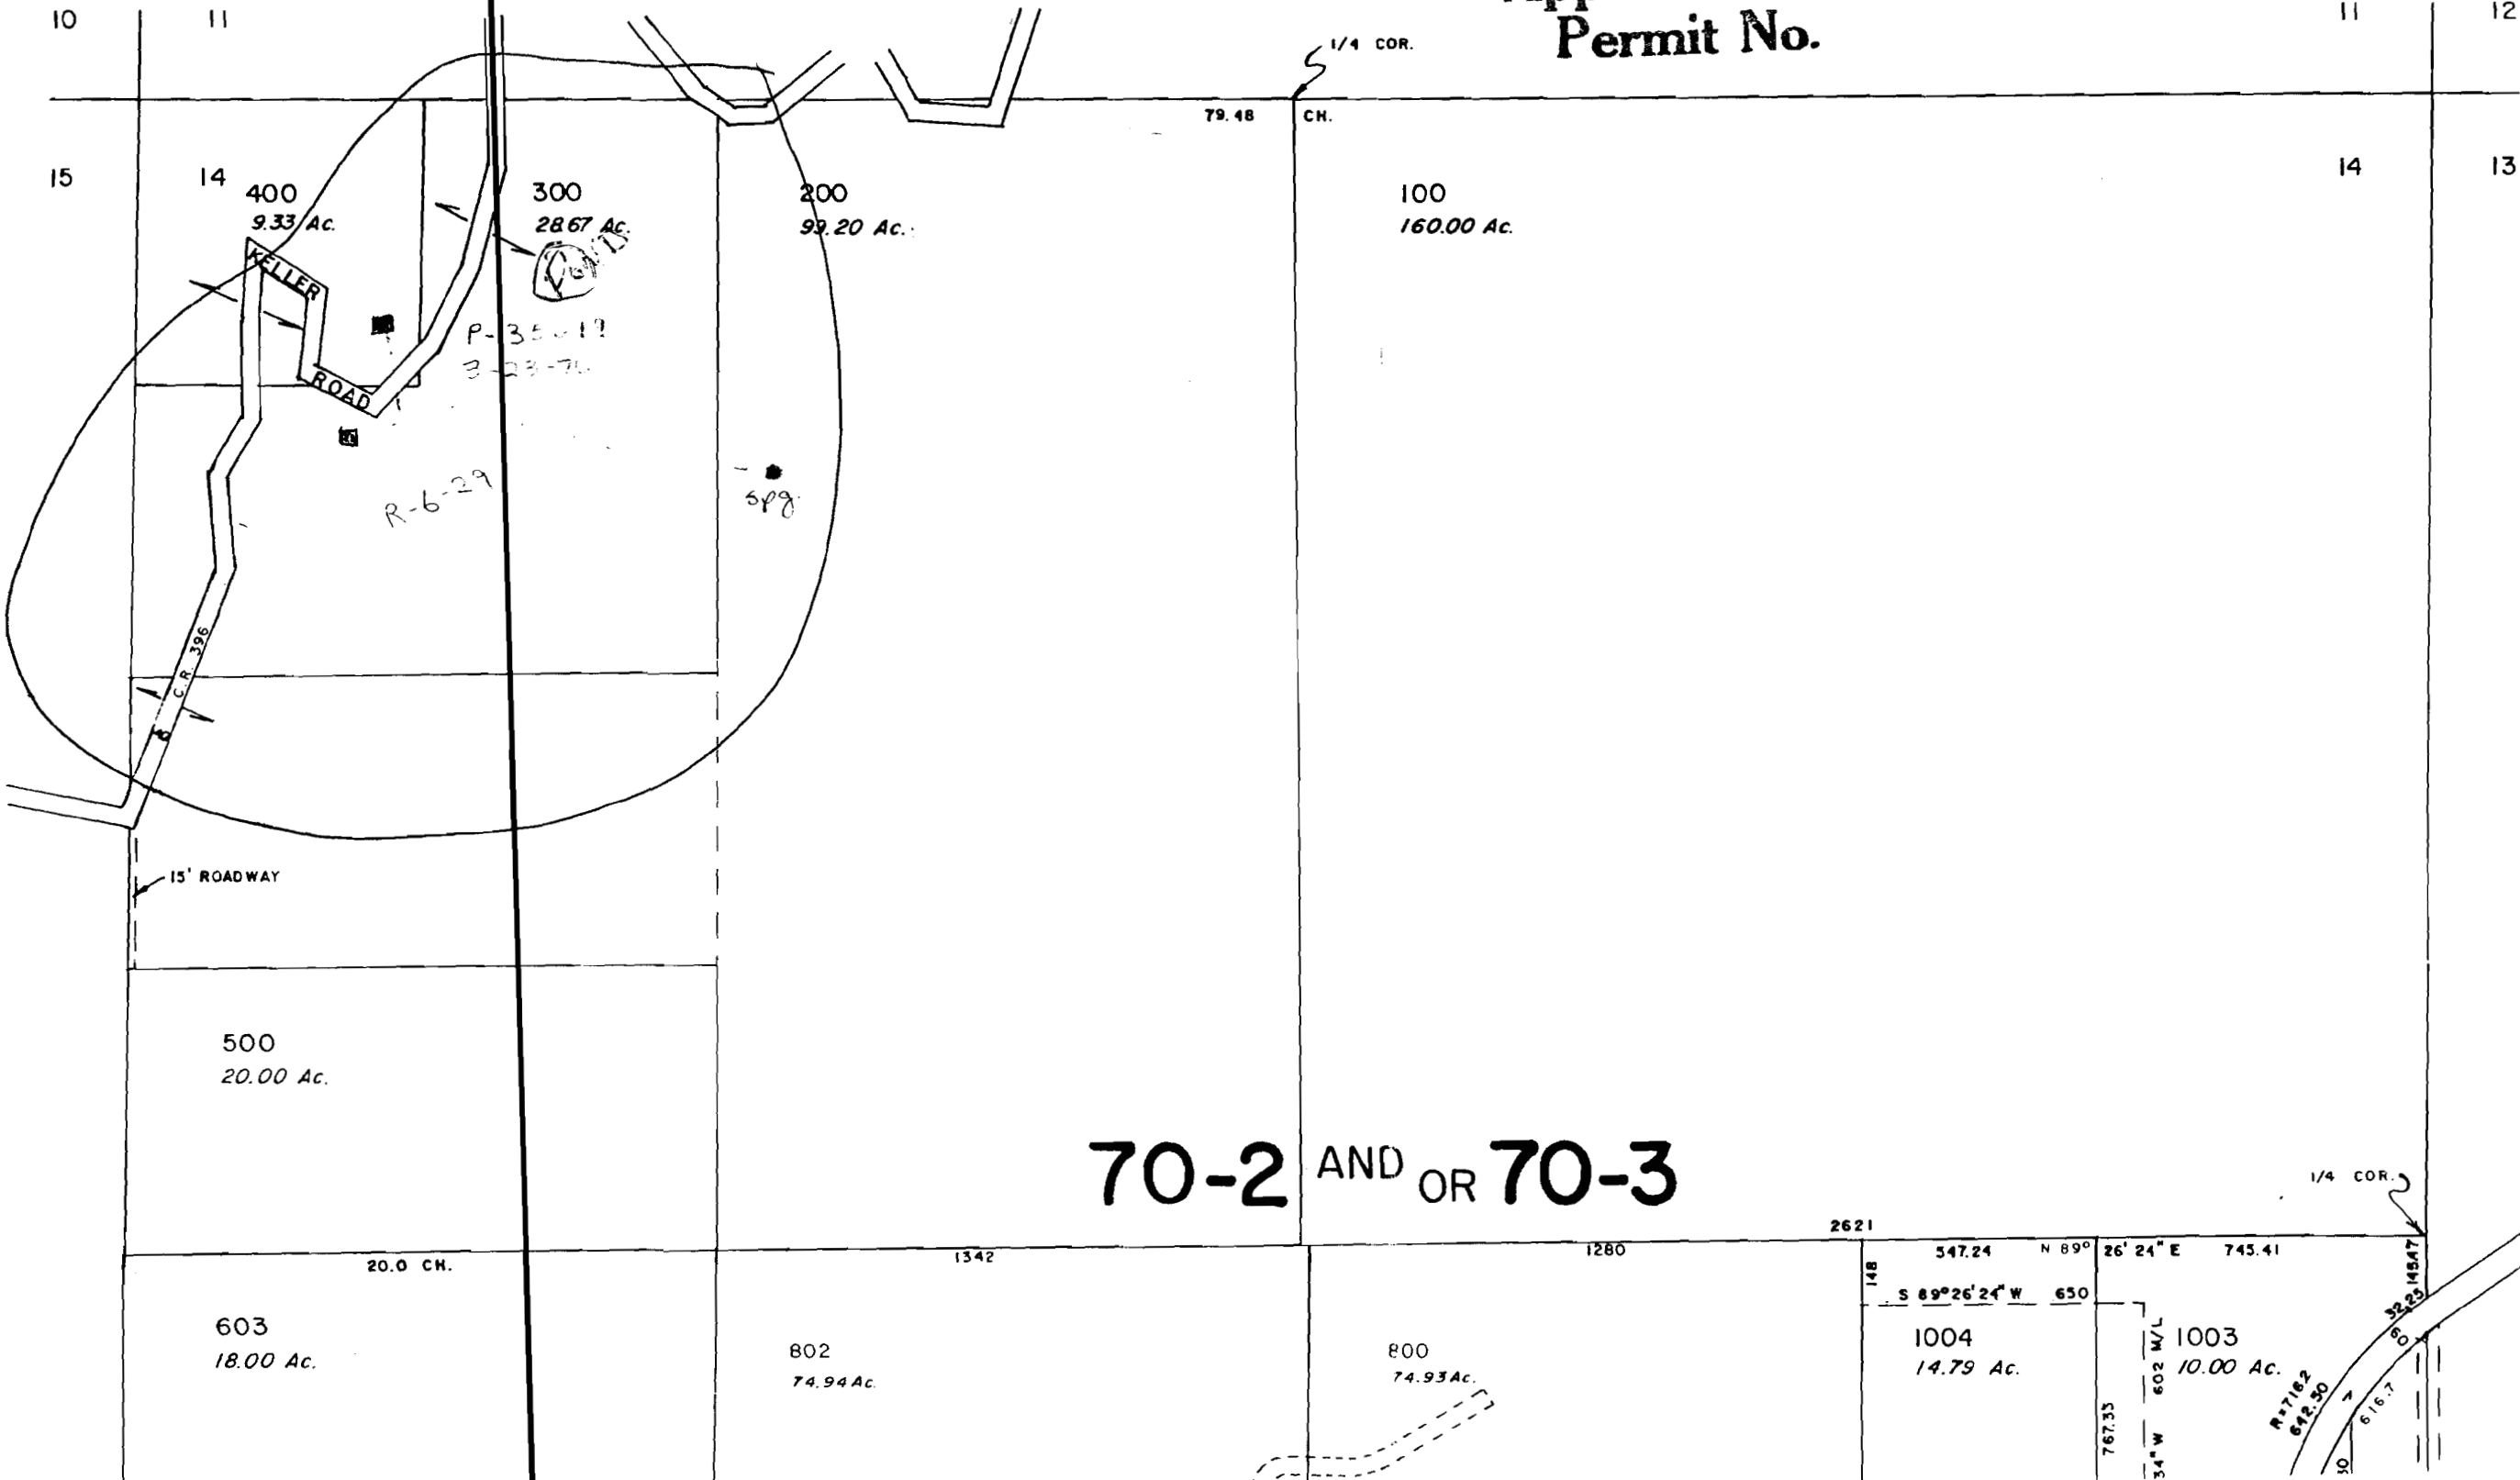

CANCELLED TAX LOTS
1002

70-2 AND OR 70-3

SEE MAP
2N 3 13